

REC'D JUL 22 1997


GRANT COUNTY U.S. PUBLIC LAND SURVEY MONUMENT RECORD

TYPE OF MONUMENT:
TIES ARE AS INDICATED ON SKETCH

WITNESSES TO CORNER LOCATION

Sean M. Walsh

Christopher G. Reedy

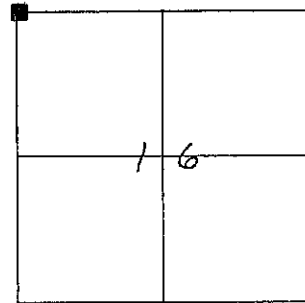

CORNER LOCATION

Set 3/4" x 24" iron rod at corner

Northwest Corner Section 16, 7-3W

BASIS FOR MONUMENT LOCATION

Subsequent to Original gov't. Survey, I could not locate any record evidence of this corner having been used.

I re-established this location at a position which is at the projection of occupied lines in the vicinity and at a location which was believed to be the corner by adjacent land owners.

This information is correct and true to the best of my knowledge and belief.



TIE SKETCH

