

REC'D AUG 24 1994

GOVERNMENT CORNER RECORD

East 1/4 CORNER, SECTION 10, TOWNSHIP 7 NORTH, RANGE 3 ~~XXX~~ EAST - WEST,

TOWN, CITY OR VILLAGE OF Marion

TYPE OF MONUMENT: 3/4" x 24" Iron Rod Set ELEVATION - M.S.L. DATUM


WITNESSES TO CORNER LOCATION

Sean M. Walsh

Ryan Keegan

SECTION 10, T. 7 N, R. 3 EW

TOWN OF Marion

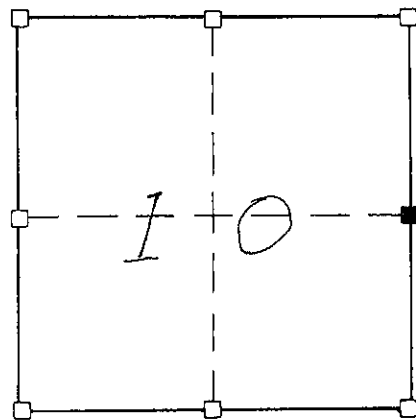

NORTH

TIE SKETCH (SHOW ALL HELPFUL FEATURES)

Ties in trees are 60 penny poles set in blaze at base of tree as noted.

3/4" Iron Rod Set

WOODED

30.78'

WOODED

36.88'

S/S 11 Twin White Oak

11.82'

13.96'

SW/S 15" White oak

WOODED


W/S 10" Burr Oak

WOODED

SURVEYOR'S CERTIFICATE

SEAL S- 2016

I, Sean M. Walsh, DO HEREBY CERTIFY THAT I have monumented and perpetuated
this corner as shown above at a location where I found the remains of
an old corner post. I accepted this location as the only available
evidence. That this information is correct to the best of my knowledge
and belief.

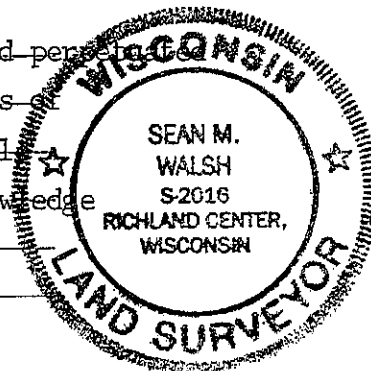

DATED THIS 4 DAY OF AUG, 19 94

REGISTERED LAND SURVEYOR