

Survey Monument Record

SW


TYPE OF MONUMENT 1 1/4" Iron pipe
 STATE PLANE COORDINATES: N _____
 E _____
 ELEVATION — M.S.L. DATUM: _____
 THETA ANGLE: _____
 FIELD BOOK: 93-9
 PAGE _____

CORNER NO. _____
 SECTION 7
 TOWN 7N
 RANGE 2W

BASIS FOR MONUMENT LOCATION

(Use reverse side if necessary)

Show info such as: History of corner, with reference to Vol. and pg., dates, surveyor; exact description of monument replaced; if location computed, by taped or EDM traverse; landowner, remarks, etc.

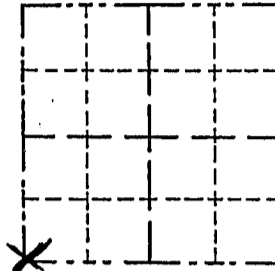


LOCATION
(Indicated by "X")

SEAL:

There are no survey records of this corner since the original government survey. Ownership records dating back to the 1800's as well as testimonial evidence from area farmers (seniors) indicate that this corner has been maintained in its current location. A 1 1/4" Iron pipe was set at the corner after an EDM traverse of the area.

CERTIFIED CORRECT
Laurence E. Schmit
 Registered Land Surveyor
 DATE: 10/20/93

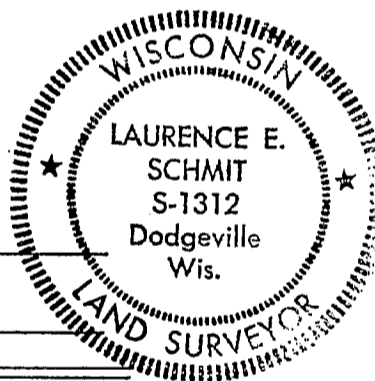

TIE SKETCH

Show at least three (4) ties and monument

