

U.S. PUBLIC LAND SURVEY MONUMENT RECORD

(As Required By s. A-E 7.08, WI Adm. Code)

History of original corner establishment and subsequent restorations and description of any record, monument, occupational, testimonial or other evidence considered:



HISTORY IS THE ORIG. GOUT SURVEY. FOUND AND ACCEPTED A 1" REBAR ON A EAST, WEST, & SOUTH FENCE INTERSECTION. THE REBAR IS OF UNKNOWN ORIGIN

Corner was: (Check All That Apply)

- Restored through acceptance of an obliterated evidence location
- Restored through acceptance of a found perpetuated location
- Considered a lost corner and reestablished through lost corner proportionate methods (include a plan view drawing showing distances and directions to other Public Land Survey Corners used for proportioning and determining the corner location)
- Restored or reestablished in a location that differs from a previous restoration or reestablishment (include a plan view drawing and indicate what was set and/or found)

Describe the monument and accessories used to perpetuate the location of this corner. (Include a plan view drawing and indicate what was set and/or found)

The N¹/₄
 corner of Section 13
 T. 7 N., R. 3 W ~~E.~~,
GRANT County, Wisconsin
 Job ID: 998-252
 Book # _____

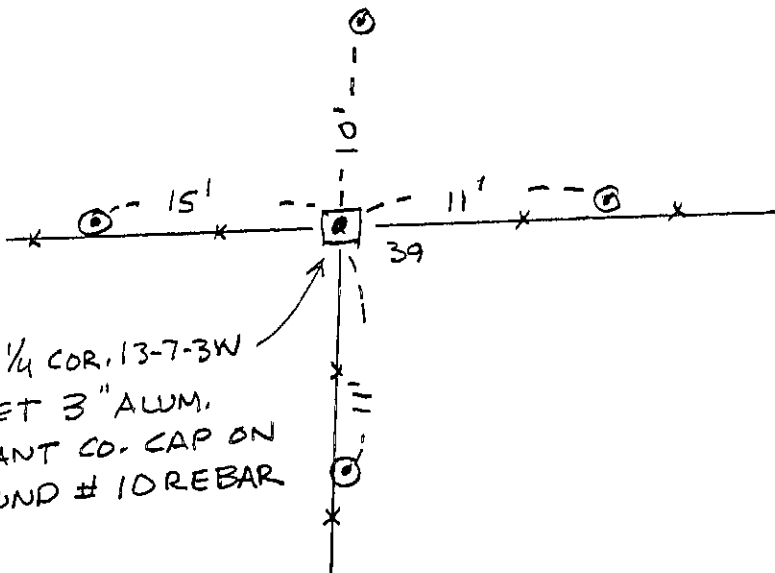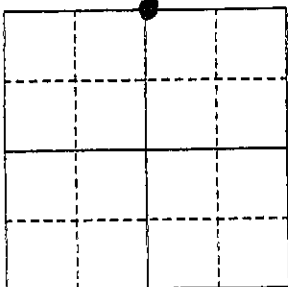

N¹/₄ COR. 13-7-3W
 SET 3" ALUM.
 GRANT CO. CAP ON
 FOUND # 10 REBAR

LEGEND!

- SECTION CORNER AS DESCRIBED
- FENCE
- 1/2" IRON PIPE TIE

● = Location of Corner


I, LAURENCE E. SCHMIT

(Type or print name) certify that the corner location shown on this record was determined by me or under my direction and control and that this U.S. Public Land Survey Monument Record is correct and complete to the best of my knowledge and belief.

Laurence E. Schmit 2-29-2000

Signature

Date

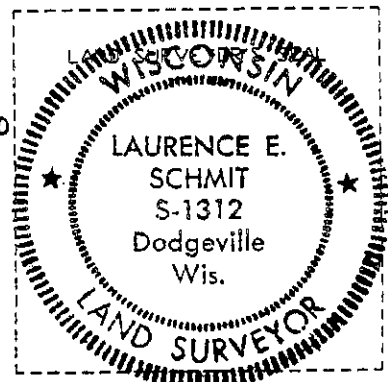

Index No. 42