

GRANT COUNTY CERTIFIED LAND CORNER


CORNER NUMBER 68

CERTIFICATE:

I, Larry L. Austin, do hereby certify that on the 28th day of July, 2000, I found no evidence of the North 1/4 corner of Section 21, Town 7 North, Range 3 West, of the 4th Principal Meridian, and I re-established said corner according to the Wisconsin statutes as shown and described hereon.

Dated this 3rd day of November, 2000

Larry L. Austin
Larry L. Austin S-1903

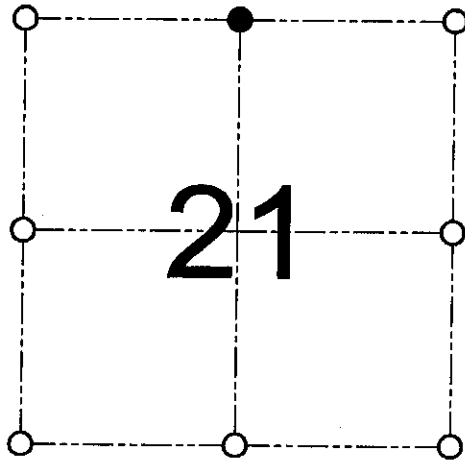

● = CORNER LOCATION
NORTH 1/4 CORNER OF SECTION 21, T 7 N R 3 W TOWN OF MARION

HISTORY OF ORIGINAL CORNER ESTABLISHMENT:

Corner was originally set in 1833 by Harvey Parke.
No other record of the corner was found.

DESCRIPTION OF CORNER EVIDENCE FOUND:

I found no evidence of the location of the corner. I reset the corner based on proportionate methods along the North line of Section 21.

DESCRIPTION OF CORNER AND WITNESS MONUMENTS, references and accessories used to perpetuate the original or re-established location of this corner

WITNESS TO THE CORNER LOCATION: SHANE AUSTIN & SHELBY BLINDERT & BOBBY SEDGWICK

SKETCH:

