

APR 15 1991

# GOVERNMENT CORNER RECORD

CENTER CORNER, SECTION 18, TOWNSHIP 7 NORTH, RANGE 3 ~~EAST~~ - WEST,

TOWN, ~~CITY/TOWNSHIP~~ OF MARION

TYPE OF MONUMENT: 3/4" X 24" IRON ROD PLACED ELEVATION - M.S.L. DATUM \_\_\_\_\_


WITNESSES TO CORNER LOCATION

SEAN M. WALSH

PATRICK J. DEDERICH

SECTION 18, T 7 N, R 3 **NW**

TOWN OF MARION

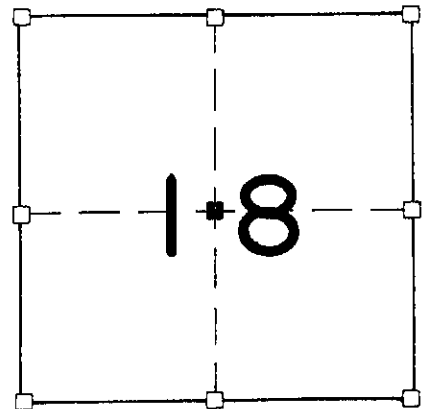

- - CORNER LOCATION
- - 3/4" X 24" IRON ROD SET
- TREE TIES - 20d POLESPIKE IN BLAZE AT BASE OF TREE

NORTH

TIE SKETCH  
 (SHOW ALL HELPFUL FEATURES)

BURIED ±20"

35.06'

PASTURED

FIELD

N/S 11" SHAGBARK  
 HICKORY

17.86'

26.15'

10.15'

W/S 9" SHAGBARK  
 HICKORY


WOODED

WOODED

SURVEYOR'S CERTIFICATE

SEAL S. 1454

I, Matthew J. Janiak, DO HEREBY CERTIFY THAT the above corner has been  
established under my direction and supervision in accordance with  
the information contained hereon and that this information  
is correct and true to the best of my knowledge, information and  
belief. This location is that of physical occupation as no other  
evidence could be located.

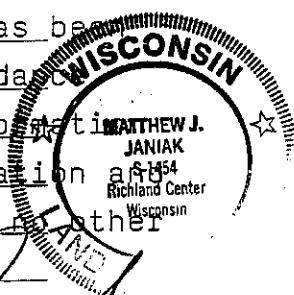

DATED THIS 9th DAY OF April, 1991

*Matthew J. Janiak*  
 REGISTERED LAND SURVEYOR

*SEALED*