


Survey Monument Record

CORNER NO. _____
 SECTION 30
 TOWN 7N
 RANGE 3W

FEB 5 1996

TYPE OF MONUMENT 1" Iron Pipe
 STATE PLANE COORDINATES: N _____
 E _____
 ELEVATION — M.S.L. DATUM: _____
 THETA ANGLE: _____
 FIELD BOOK: 95-11
 PAGE _____

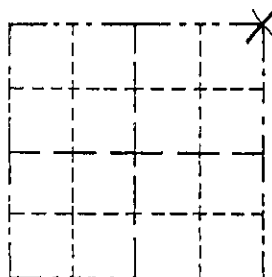

BASIS FOR MONUMENT LOCATION

(Use reverse side if necessary)

Show info such as: History of corner, with reference to Vol. and pg., dates, surveyor; exact description of monument replaced; if location computed, by taped or EDM traverse; landowner, remarks, etc.

LOCATION
 (Indicated by "X")

- POINT PERPETUATED LOCATION
- OBLITERATED EVIDENCE LOCATION
- LOST CORNER (RESTORED BY PROPORTIONATE METHODS)

There are no survey records of this corner since the original government survey. Ownership records indicate that the corner has been maintained since the mid 1800's and EDM shots along the occupied north and east lines of the section do not stray more than a few feet off line. The occupied location of a 3 way fence intersection was accepted and monumented. TIES were set as shown below.
 NOTE: ORIGINAL BEARING TREES ARE LONG GONE.

CERTIFIED CORRECT TO THE BEST OF MY KNOWLEDGE AND BELIEF

Michael R. LaRosa

Registered Land Surveyor

DATE: 1/10/1996

TIE SKETCH

Show at least ~~two~~ (4) 1/2" iron pipe monument

