

MAY 25 1990

# GRANT COUNTY

## GOVERNMENT CORNER RECORD

S W CORNER, SECTION 19, TOWNSHIP 7 NORTH, RANGE 2 EAST - WEST,  
TOWN, CITY OR VILLAGE OF HICKORY GROVE, RICHLAND CO.

TYPE OF MONUMENT: 3/4" IRON ROD SET ELEVATION - M.S.L. DATUM \_\_\_\_\_

STATE PLANE COORDINATES: N \_\_\_\_\_


WISCONSIN SOUTH ZONE E \_\_\_\_\_

WITNESSES TO CORNER LOCATION

SEAN M. WALSH

PATRICK J. DEDERICH

SECTION 19, T 7 N, R 2 W  
TOWN OF HICKORY GROVE

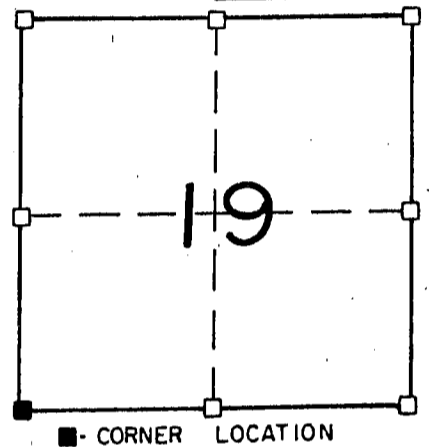

NORTH

TIE SKETCH  
(SHOW ALL HELPFUL FEATURES)

WOODED

WOODED

20 d POLESPIKE W/S  
10" BITTERNUT HICKORY

20 d POLESPIKE  
NW/S BITTERNUT HICKORY 8"

22.75'

28.94'

20.03'

3.58'

20 d POLESPIKE SE/S  
14" W. OAK

20 d POLESPIKE NW/S  
23" ASH


WOODED

WOODED

SURVEYOR'S CERTIFICATE  
STATE OF WISCONSIN)  
RICHLAND COUNTY )SS

SEAL - S-1454

I, Matthew J. Janiak, DO HEREBY CERTIFY THAT the above corner  
has been established under my direction and supervision  
in accordance with the information contained hereon and  
that this information is correct to the best of my information  
knowledge and belief. this corner has been established at the  
occupied location, this location also fits very well with

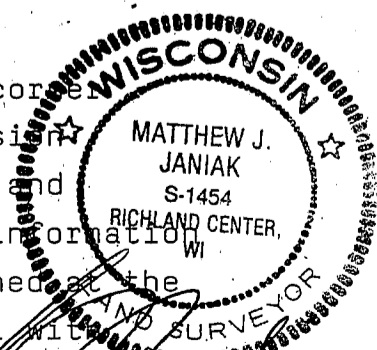

DATED THIS 16TH DAY OF MAY, 1990

REGISTERED LAND SURVEYOR

CORNER CODE

993

previously recorded dimensions of the west line of section 19.