

REC'D JUN 4 1997


GRANT COUNTY U.S. PUBLIC LAND SURVEY MONUMENT RECORD

North 1/4 corner Section 25, 7-3W

TYPE OF MONUMENT:
TIES ARE AS INDICATED ON SKETCH

WITNESSES TO CORNER LOCATION

Christopher G. Reedy
Christopher J. Ruetten

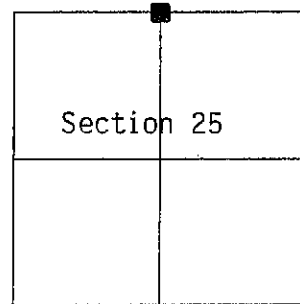


CORNER LOCATION

BASIS FOR MONUMENT LOCATION

Subsequent to Original Gov't. Survey, no record evidence of this corner having been used could be located.

This corner has been re-established at the mid-point of the North line of Section 25.

I, do hereby certify that the information contained hereon is correct and true to the best of my knowledge and belief.

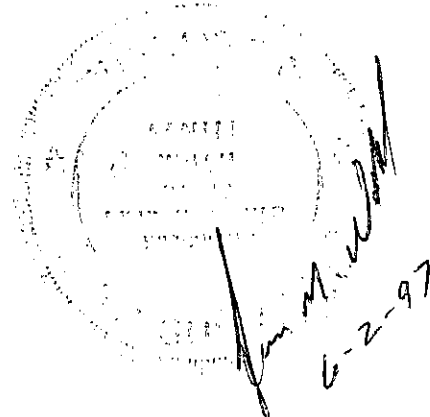

- -- indicates 3/4" x 24" iron rod set
- -- indicates 3/4" x 24" iron rod set

TIE SKETCH

