


Survey Monument Record

TYPE OF MONUMENT 3/4" X 24" IRON BAR SET

CORNER NO. 107
 SECTION 34
 TOWN 7N
 RANGE 3W

FIELD BOOK: 96-12
 PAGE (3)

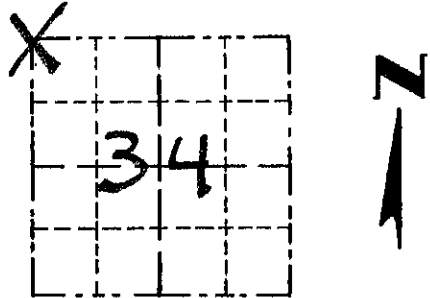

LOCATION
 (Indicated by "X")


BASIS FOR MONUMENT LOCATION

(Use reverse side if necessary)

Show info such as: History of corner, with reference to Vol. and pg., dates, surveyor; exact description of monument replaced; if location computed, by taped or EDM traverse; landowner, remarks, etc.

SEAL:

CORNER SET IN 1833 BY HARVEY CLARKE. ORIGINAL BEARING TREES WERE UNRECOVERABLE. NO RECORD OF CORNER FOUND SINCE ORIGINAL SURVEYS. CORNER SET AT A OCCUPIED FENCE CORNER, VERIFIED ITS LOCATION BY EDM TRAVERSE OF AREA,

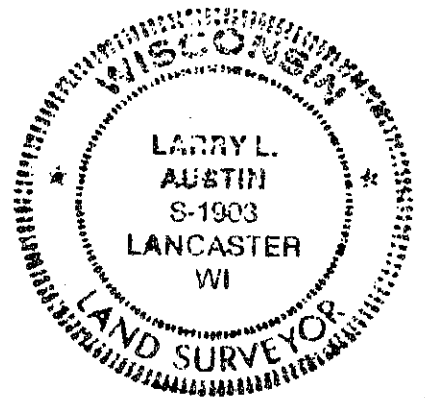

CERTIFIED CORRECT

Larry L. Austin
 Registered Land Surveyor
 DATE: 8/22/96

TIE SKETCH

Show at least three (3) ties and monument

LEGEND

- ⊕ 3/4" X 24" IRON BAR SET
- 1/2" X 18" IRON BAR SET AS TIES
- XX EXISTING FENCE

