

GRANT COUNTY CERTIFIED LAND CORNER

CORNER NUMBER 109

CERTIFICATE:


I, Larry L. Austin, do hereby certify that on the 28th day of July, 2000, I found evidence of the Southwest corner of Section 28, Town 7 North, Range 3 West, of the 4th Principal Meridian, and I re-established said corner according to the Wisconsin statutes as shown and described hereon.

Dated this 3rd day of November, 2000

Larry L. Austin
Larry L. Austin S-1903



SEAL

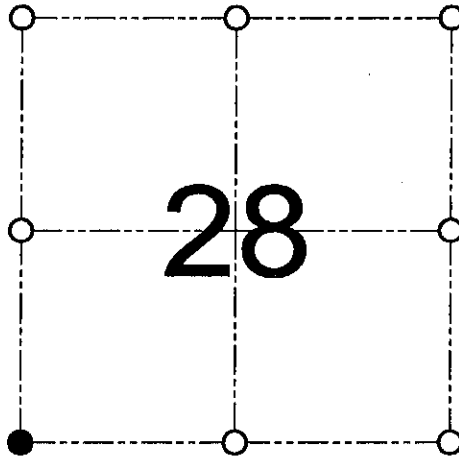

● = CORNER LOCATION

SOUTHWEST CORNER OF
SECTION 28, T 7 N R 3 W
TOWN OF MARION

HISTORY OF ORIGINAL CORNER ESTABLISHMENT:

Corner was originally set in 1833 by Harvey Parke.
In 1890 Gould found the original corner and trees.

DESCRIPTION OF CORNER EVIDENCE FOUND:

I found an existing fence corner and accepted it's
location after an EDM & GPS traverse of the area.

DESCRIPTION OF CORNER AND WITNESS MONUMENTS, references and accessories used to perpetuate the original or re-established location of this corner

WITNESS TO THE CORNER LOCATION: SHANE AUSTIN & SHELBY BLINDERT & BOBBY SEDGWICK

SKETCH:

