


Survey Monument Record

TYPE OF MONUMENT 3/4" X 24" IRON BAR SET

CORNER NO. 62  
 SECTION 24  
 TOWN 7N  
 RANGE 4W

FIELD BOOK: 97-02  
 PAGE (34)

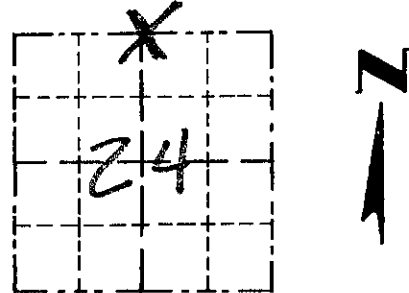

LOCATION  
(Indicated by "X")


BASIS FOR MONUMENT LOCATION

(Use reverse side if necessary)

Show info such as: History of corner, with reference to Vol. and pg., dates, surveyor; exact description of monument replaced; if location computed, by taped or EDM traverse; landowner, remarks, etc.

SEAL:

CORNER SET IN 1833 BY HARVEY PARKE. NO RECORD OF CORNER FOUND SINCE ORIGINAL SURVEY; CORNER WAS SET BASED ON BEARING / DISTANCE TO A BEARING TREE. THIS LOCATION FIT WELL WITH OCCUPIED NORTH / SOUTH FENCE. VERIFIED THIS LOCATION USING EDM METHODS.

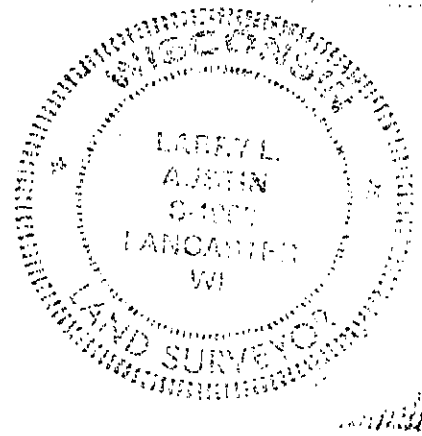

CERTIFIED CORRECT

*Larry L. Austin*  
 Registered Land Surveyor

DATE: 4-13-98

TIE SKETCH

Show at least three (3) ties and monument

LEGEND

- 3/4" X 24" IRON BAR SET
- 1/2" X 15" IRON BAR SET
- ⊗ NAIL SET IN TREE
- EXISTING FENCE

