

# GRANT COUNTY CERTIFIED LAND CORNER

CORNER NO. 105

**CERTIFICATE:**


I, LARRY L. AUSTIN, DO HEREBY CERTIFY THAT ON TWENTY-FIFTH DAY OF JANUARY, 1999, I FOUND MONUMENTED EVIDENCE OF THE NORTHEAST CORNER OF SECTION 34, TOWN 7 NORTH, RANGE 4 WEST, OF THE FOURTH PRINCIPAL MERIDIAN, AND I RE-ESTABLISHED SAID CORNER ACCORDING TO THE WISCONSIN STATUTES AS SHOWN AND DESCRIBED HEREON.

DATED THIS NINETEENTH DAY OF MARCH, 1999  
REVISED THIS 16<sup>th</sup> DAY OF NOVEMBER, 2004 *LLA*

*Larry L. Austin*  
LARRY L. AUSTIN S-1903



SEAL

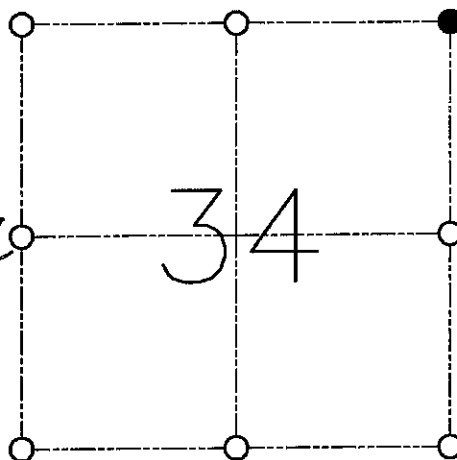

● = CORNER LOCATION  
NORTHEAST CORNER SECTION 34  
T 7 N R 4 W  
TOWN OF WOODMAN

**HISTORY OF ORIGINAL CORNER ESTABLISHMENT:**

CORNER WAS SET IN 1833 BY HARVEY PARKE.

**DESCRIPTION OF CORNER EVIDENCE FOUND:**

I FOUND A 2" IRON PIPE SET BY ROBERT M. LAMPMAN. I ACCEPTED IT'S LOCATION AFTER AN E.D.M. TRAVERSE OF THE AREA.

**DESCRIPTION OF CORNER AND WITNESS MONUMENTS, REFERENCES AND ACCESSORIES USED TO PERPETUATE THE ORIGINAL OR RE-ESTABLISHED LOCATION OF THIS CORNER:**

**WITNESS TO THE CORNER LOCATION:**

BOBBY SEDGWICK  
SHELBY BLINDERT

**SKETCH:**

