

# GRANT COUNTY CERTIFIED LAND CORNER


CORNER NUMBER 122

**CERTIFICATE:**


I, Larry L. Austin, do hereby certify that on the 14th day of June, 2000, I found no evidence of the South 1/4 corner of Section 36, Town 7 North, Range 4 West, of the 4th Principal Meridian, and I re-established said corner according to the Wisconsin statutes as shown and described hereon.

Dated this 23rd day of October, 2000

*Larry L. Austin*  
Larry L. Austin S-1903

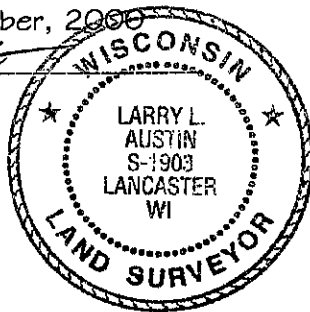

SEAL

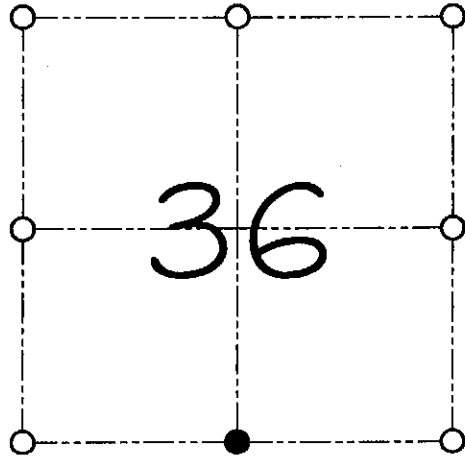

● = CORNER LOCATION

SOUTH 1/4 CORNER OF  
SECTION 36, T 7 N R 4 W  
TOWN OF WOODMAN

**HISTORY OF ORIGINAL CORNER ESTABLISHMENT:**

Corner was originally set in 1832 by Sibley.  
No other recent record of the corner was found.

**DESCRIPTION OF CORNER EVIDENCE FOUND:**

I reset the corner based on proportionate measurements along the South line of Section 36. Verified this location using E.D.M. & G.P.S. methods.

**DESCRIPTION OF CORNER AND WITNESS MONUMENTS, references and accessories used to perpetuate the original or re-established location of this corner**  
WITNESS TO THE CORNER LOCATION: SHANE AUSTIN & BOBBY SEDGWICK

**SKETCH:**

