

GRANT COUNTY CERTIFIED LAND CORNER


CORNER NUMBER 114

CERTIFICATE:


I, Larry L. Austin, do hereby certify that on the 14th day of June, 2000, I found evidence of the West 1/4 corner of Section 31, Town 7 North, Range 3 West, of the 4th Principal Meridian, and I re-established said corner according to the Wisconsin statutes as shown and described hereon.

Dated this 20th day of October, 2000

Larry L. Austin
Larry L. Austin S-1903

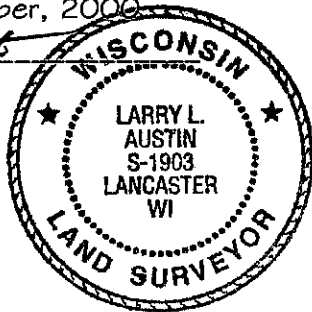

SEAL

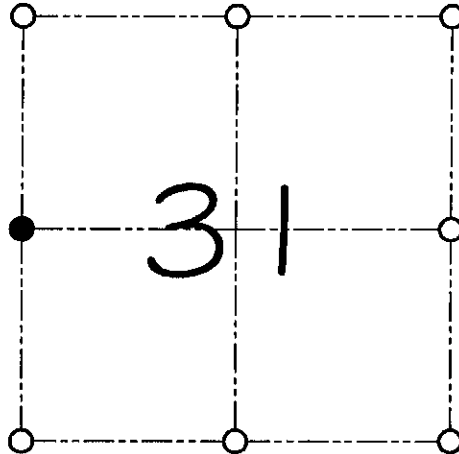

● = CORNER LOCATION

WEST 1/4 CORNER OF
SECTION 31, T 7 N R 3 W
TOWN OF MARION

HISTORY OF ORIGINAL CORNER ESTABLISHMENT:

Corner was originally set in 1832 by Sibley.
In 1880 Joel Barber tied to the corner & set new bearing trees.

DESCRIPTION OF CORNER EVIDENCE FOUND:

I reset the corner proportionately based on Barber's measurements along the West line of Section 31. Verified this location using E.D.M. & G.P.S. methods.

DESCRIPTION OF CORNER AND WITNESS MONUMENTS, references and accessories used to perpetuate the original or re-established location of this corner

WITNESS TO THE CORNER LOCATION: SHANE AUSTIN & BOBBY SEDGWICK

SKETCH:

