

GRANT COUNTY CERTIFIED LAND CORNER


CORNER NUMBER 50

CERTIFICATE:

I, Larry L. Austin, do hereby certify that on the 19th day of June, 2000, I found evidence of the North 1/4 corner of Section 17, Town 8 North, Range 2 West, of the 4th Principal Meridian, and I re-established said corner according to the Wisconsin statutes as shown and described hereon.

Dated this 23rd day of June, 2000

Larry L. Austin
Larry L. Austin S-1903

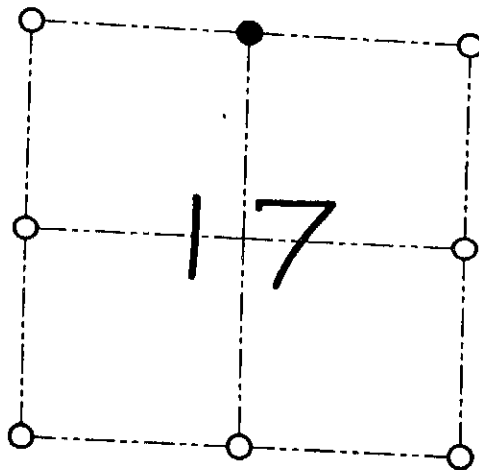

● = CORNER LOCATION
NORTH 1/4 CORNER OF SECTION 17, T 8 N R 2 W TOWN OF WATTERSTOWN

HISTORY OF ORIGINAL CORNER ESTABLISHMENT:

Corner was originally set in 1833 by Harvey Parke.
No other record of the corner was found.

DESCRIPTION OF CORNER EVIDENCE FOUND:

I found one of the original bearing trees and reset the corner based on the tree. This location was verified using EDM & GPS methods.

DESCRIPTION OF CORNER AND WITNESS MONUMENTS, references and accessories used to perpetuate the original or re-established location of this corner

WITNESS TO THE CORNER LOCATION: SHANE AUSTIN & SHELBY BLINDERT & BOBBY SEDGWICK

SKETCH:

