

RECEIVED

GOVERNMENT CORNER RECORD

JAN 9 1992

NORTHEAST CORNER, SECTION 16, TOWNSHIP 8 NORTH, RANGE 2 EAST - WEST,

TOWN, CITY OR VILLAGE OF WATTERSTOWN

TYPE OF MONUMENT: 3/4" X 24" IRON ROD SET ELEVATION - M.S.L. DATUM


WITNESSES TO CORNER LOCATION

SEAN M. WALSH

JASON D. DOBBS

SECTION 16, T 8 N, R 2 EW

TOWN OF WATTERSTOWN

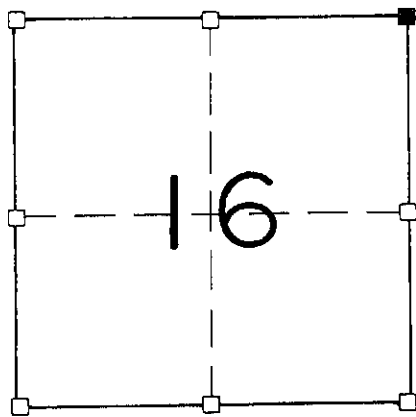

■ - CORNER LOCATION

TIE SKETCH
(SHOW ALL HELPFUL FEATURES)

WOODED

WOODED

20d POLESPIKE
N/S 20" RED OAK

20d POLESPIKE
SE/S 11" RED OAK

20d POLESPIKE
S/S 13" RED OAK

26.50'

8.55'

16.80'

24.18'

20d POLESPIKE
SE/S 9" RED OAK


WOODED

WOODED

SURVEYOR'S CERTIFICATE

I, Sean M. Walsh, DO HEREBY CERTIFY THAT I have accepted and perpetuated the above corner according to the information hereon and that this information is correct and true to the best of my information, knowledge and belief. I found a 60 penny nail with washers at this location as called for by David Davis Sept 19, 1980. I accepted this location as the best available evidence and perpetuated as shown above.

SEAL S-2016

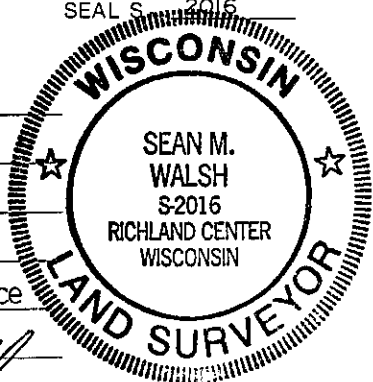

DATED THIS 4TH DAY OF Nov., 19 92

Sean M. Walsh
REGISTERED LAND SURVEYOR

P 47