

# GRANT COUNTY CERTIFIED LAND CORNER


CORNER NUMBER 38A

**CERTIFICATE:**


I, Larry L. Austin, do hereby certify that on the 22nd day of March, 2000, I found no evidence of the Center of Section 11, Town 8 North, Range 2 West, of the 4th Principal Meridian, and I re-established said corner according to the Wisconsin statutes as shown and described hereon.

Dated this 23rd day of June, 2000

*Larry L. Austin*  
Larry L. Austin S-1903

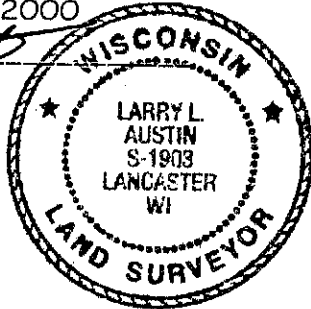

SEAL

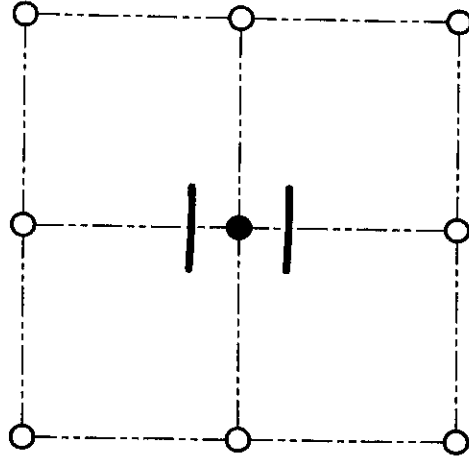

● = CORNER LOCATION  
CENTER OF SECTION 11, T 8 N R 2 W TOWN OF WATTERSTOWN

**HISTORY OF ORIGINAL CORNER ESTABLISHMENT:**

A stone was originally set in 1889 by Gould.  
In 1994 Sean Walsh tied to the corner.

**DESCRIPTION OF CORNER EVIDENCE FOUND:**

I was unable to locate the stone. I reset the corner at the intersection of quarter lines. Verified this location using EDM & GPS methods.

**DESCRIPTION OF CORNER AND WITNESS MONUMENTS, references and accessories used to perpetuate the original or re-established location of this corner**

WITNESS TO THE CORNER LOCATION: SHANE AUSTIN & SHELBY BLINDERT & BOBBY SEDGWICK

**SKETCH:**



FIELDS

FIELDS

\* NOTE \*  
CORNER IS BURIED 12" BELOW GRADE

LINE TABULATION	
A = N 18°21'44" W 51.92'	
B = N 10°02'51" W 97.75'	
C = S 15°51'42" W 59.25'	
D = S 07°12'36" W 119.14'	

FIELDS

FIELDS

LEGEND

- Number 8 by 30" rebar set with Grant County aluminum cap
- Number 4 by 24" rebar set with red plastic cap
- x— Existing fence location