


GRANT COUNTY U.S. PUBLIC LAND SURVEY MONUMENT RECORD

TYPE OF MONUMENT: 3/4" x 24" Iron Rod set
TIES ARE AS INDICATED ON SKETCH

WITNESSES TO CORNER LOCATION

Reginald Jaquish
Christopher Ruetten

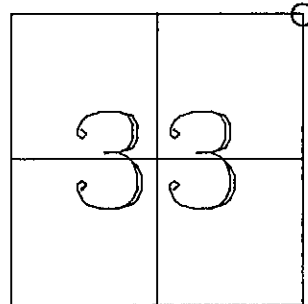

CORNER LOCATION


BASIS FOR MONUMENT LOCATION

NORTHEAST SECTION 33 T8N R2W

Subsequent to Original Gov't. Survey, I could not locate any record evidence of this corner having been used.

I located a well maintained occupied corner at this location and accepted it as the best available evidence. I placed a 3/4" x 24" iron rod at this location and perpetuated as shown hereon.

I do hereby certify that this information is correct and true to the best of my knowledge and belief.

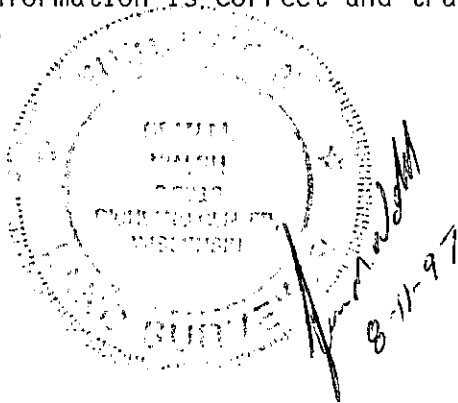

TIE SKETCH

