

GRANT COUNTY CERTIFIED LAND CORNER

CORNER NO. 09

CERTIFICATE:


I, LARRY L. AUSTIN, DO HEREBY CERTIFY THAT ON FIFTEENTH DAY OF MARCH, 1999, I FOUND OCCUPATIONAL EVIDENCE OF THE NORTHWEST CORNER SECTION 4, TOWN 7 NORTH, RANGE 2 WEST, OF THE FOURTH PRINCIPAL MERIDIAN, AND I RE-ESTABLISHED SAID CORNER ACCORDING TO THE WISCONSIN STATUTES AS SHOWN AND DESCRIBED HEREON.

DATED THIS TWENTY-SIXTH DAY OF MARCH, 1999

Larry L. Austin
LARRY L. AUSTIN S-1903



SEAL

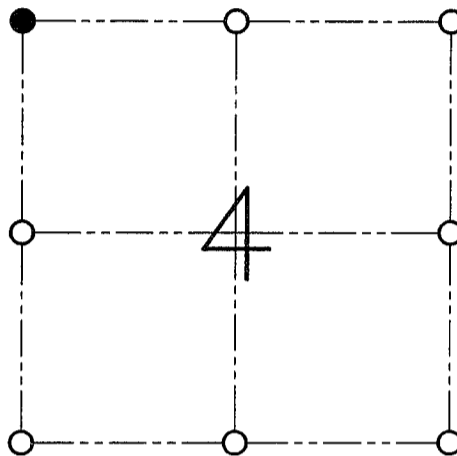

● = CORNER LOCATION

**NORTHWEST CORNER
SECTION 4, T 7 N R 2 W
TOWN OF HICKORY GROVE**

HISTORY OF ORIGINAL CORNER ESTABLISHMENT:

CORNER WAS SET IN 1832 BY HARVEY PARKE. I BELIEVE BASED ON THE DISTINCT FIELD EVIDENCE THAT AN ERROR WAS MADE WITH RESPECT TO THE RECORDING OF THE "DIRECTION" OF THE OFFSET IN THE ORIGINAL FIELD NOTES.

DESCRIPTION OF CORNER EVIDENCE FOUND:

I SET THE CORNER AT THE RECORDED OFFSET IN THE OPPOSITE DIRECTION. THIS LOCATION FIT THE OCCUPATIONAL EVIDENCE. VERIFIED THIS LOCATION USING E.D.M. AND G.P.S. METHODS.

DESCRIPTION OF CORNER AND WITNESS MONUMENTS, REFERENCES AND ACCESSORIES USED TO PERPETUATE THE ORIGINAL OR RE-ESTABLISHED LOCATION OF THIS CORNER:

WITNESS TO THE CORNER LOCATION: BOBBY SEDGWICK : SHELBY BLINDERT

SKETCH:

