

REC'D AUG 19 1997


GRANT COUNTY U.S. PUBLIC LAND SURVEY MONUMENT RECORD

TYPE OF MONUMENT: 3/4" REBAR
TIES ARE AS INDICATED ON SKETCH

WITNESSES TO CORNER LOCATION

REGINALD JAQUISH

CHRISTOPHER RUETTEN

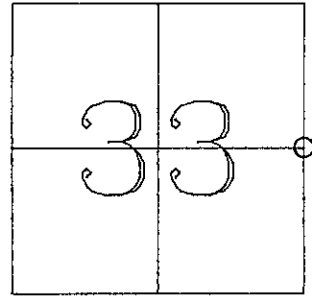


CORNER LOCATION

BASIS FOR MONUMENT LOCATION

EAST 1/4 CORNER SEC 33, T8N, R2W

I could not find any remaining evidence of any previous survey, therefore I re-established this corner at this location of physical occupation.

This information is correct and true to the best of my knowledge and belief.

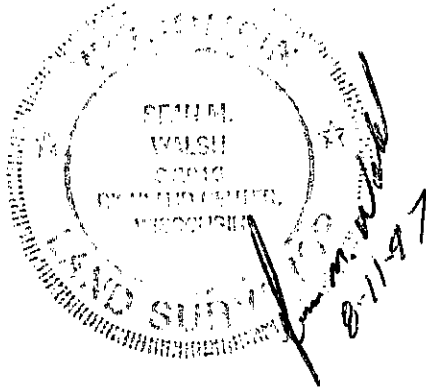

TIE SKETCH

