

U. S. PUBLIC LAND SURVEY MONUMENT RECORD

REC'D MAY 12 1997

INSTRUCTIONS:


This record shall show the location of the corner and shall include all of the following nine elements (a through i).

(a) Identify the corner by reference to the U.S. public land survey system.

⊙ - Corner monument restored

N1/4 CORNER SECTION 24
T8N, R3W, GRANT COUNTY

DATE OF SURVEY:
APRIL 8, 1997

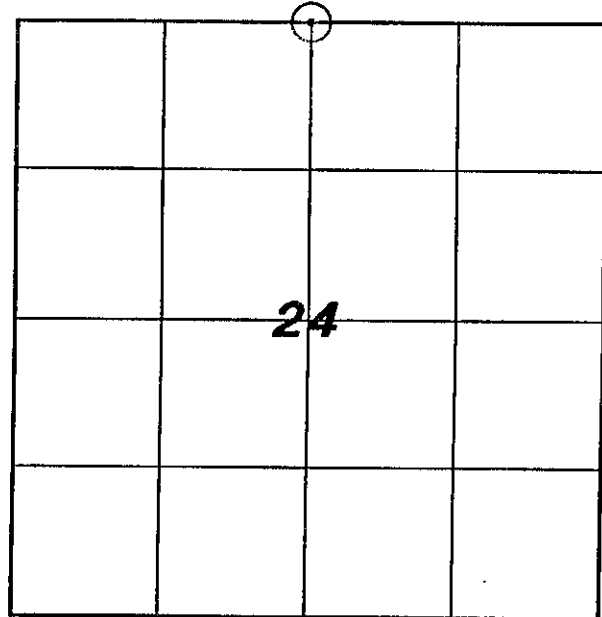

(b) Describe any record evidence, monument evidence, occupational evidence, testimonial evidence or any other material evidence you considered, and whether the monument was found or placed.

I established this corner using several stakes on the N-S1/4 line as shown on a map by David A. Davis, Dated August 17, 1979. This location corresponds to measurements shown on Davis' map to the NE corner of Section 24. I also found a badly disturbed 1/2" square iron bar very close to this location. This iron bar is called for on Davis' survey.

(c) In the plan view drawing below, provide reference ties to at least 4 witness monuments, or, if the location is within a municipality, to at least 2 witness monuments. (Witness monuments shall be made of concrete, natural stone, iron or other equally durable material.) Describe witness monuments.

(d) Show a plan view drawing depicting the relevant monuments and reference ties which is sufficient in detail to enable accurate relocation of the corner monument if the corner monument is disturbed. Indicate north.

LEGEND
 ⊙ 1 1/4" REBAR SET
 ○ 3/4" REBAR SET

