


RECORDED FEB 18 1997

GRANT COUNTY U.S. PUBLIC LAND SURVEY MONUMENT RECORD

TYPE OF MONUMENT: 3/4" Iron Rod
TIES ARE AS INDICATED ON SKETCH

WITNESSES TO CORNER LOCATION

Sean M. Walsh
Christopher G. Reedy

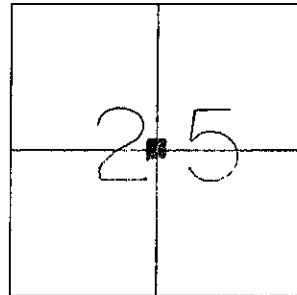


CORNER LOCATION

Center 1/4 Corner
Section 25
Town 8 North, Range 3 West
Boscobel Township

BASIS FOR MONUMENT LOCATION

This location was established by Richard Marks in 1989 at a point determined by straight line intersection between Quarter corners which I have accepted and perpetuated as shown hereon.

This information is correct and true to the best of my knowledge and belief.

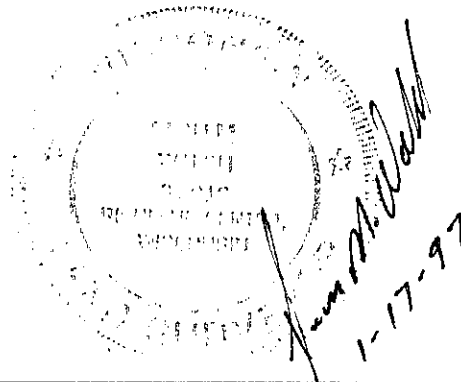

■ - 3/4" Iron Rod at Corner

TIE SKETCH

Tree ties are a 60d common pole spike set in a blaze at the base of the tree as indicated.

Tie distances were taped horizontally.

This corner is surrounded by woodlands.

