

GRANT COUNTY CERTIFIED LAND CORNER

CORNER NUMBER 98

CERTIFICATE:


I, Larry L. Austin, do hereby certify that on the 22nd day of March, 2000, I found evidence of the West 1/4 corner of Section 26, Town 8 North, Range 3 West, of the 4th Principal Meridian, and I re-established said corner according to the Wisconsin statutes as shown and described hereon.

Dated this 23rd day of June, 2000

Larry L. Austin
Larry L. Austin S-1903



SEAL

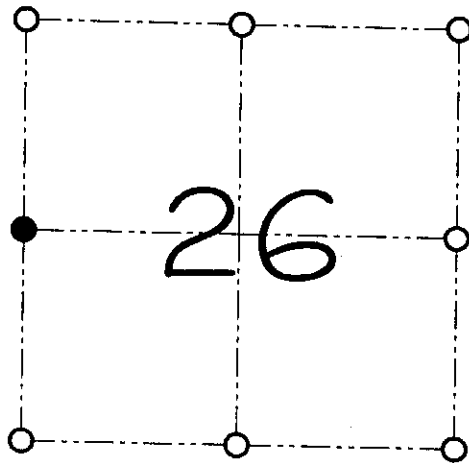

● = CORNER LOCATION

WEST 1/4 CORNER OF
SECTION 26, T 8 N R 3 W
TOWN OF BOSCOBEL

HISTORY OF ORIGINAL CORNER ESTABLISHMENT:

Corner was originally set in 1833 by Harvey Parke.
In 1977 Larry Schmitt set City of Boscobel Aluminum monument.
Many other recent surveys in the area have used the corner.

DESCRIPTION OF CORNER EVIDENCE FOUND:

I found and accepted the Boscobel Aluminum monument as the corner.
Verified this location using EDM & GPS methods.

DESCRIPTION OF CORNER AND WITNESS MONUMENTS, references and accessories used to perpetuate the original or re-established location of this corner

WITNESS TO THE CORNER LOCATION: SHANE AUSTIN & SHELBY BLINDERT & BOBBY SEDGWICK

SKETCH:

