


GRANT COUNTY

U.S. PUBLIC LAND SURVEY MONUMENT RECORD

TYPE OF MONUMENT: 3/4" X24" Iron Rod
 TIES ARE AS INDICATED ON SKETCH

WITNESSES TO CORNER LOCATION

Sean M. Walsh
Christopher G. Reedy
Derrick Tracey

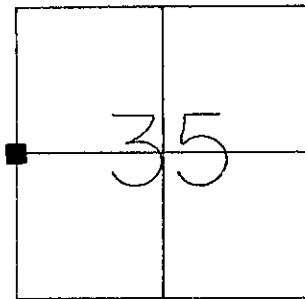

CORNER LOCATION
 Section 35, T 8 N, R 3 W
 Town of Boscobel

BASIS FOR MONUMENT LOCATION

Corner was re-established by L. Schmitt in 1977. The monument which was set in 1977 was used again in 1987 by R. Marks for his preparation of CSM #267.

Subsequent to the preparation of CSM #267 the monument was destroyed during street reconstruction. Prior to the street reconstruction the corner was tied by the City Engineer.

I re-established the position for the corner from the ties taken by the City Engineer which fit very well with the data recorded by L. Schmitt in 1977 and the data recorded by R. Marks in 1987.

I have monumented and perpetuated this corner in accordance with the information contained hereon and this information is correct and true to the best of my knowledge and belief.

- - 3/4" X 24" Iron Rod set at corner
- - 3/4" X 24" Iron Rod set as tie

Tie distances were measured horizontally by E.D.M.

TIE SKETCH

