

GRANT COUNTY

REC'D MAY 7 1996

Survey Monument Record

CORNER NO. 123
 SECTION 35
 TOWN 8N
 RANGE 3W

TYPE OF MONUMENT BOSC. Alum CITY Mon.


STATE PLANE COORDINATES: N _____
E _____

ELEVATION — M.S.L. DATUM: _____

THETA ANGLE: _____

FIELD BOOK: 95-15

PAGE _____

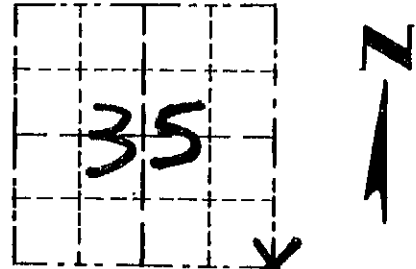

LOCATION
(Indicated by "X")

BASIS FOR MONUMENT LOCATION

(Use reverse side if necessary)

FOUND AND ACCEPTED CITY
 OF BOSCOBEL ALUMINUM SEAL:
 MONUMENT AFTER VERIFICATION
 BY EDM TRAVERSE OF THE
 AREA.

CORNER WAS ORIGINALLY SET BY
SIBLEY IN 1832.



CERTIFIED CORRECT

Larry L. Austin
 Registered Land Surveyor

DATE: 2/16/96

TIE SKETCH

Show at least three (3) ties and monument

NOTE: ALL TIES = 3/4" x 12"
IRON BAR SET

