RELOCATION ORDER
BY
COUNTY HIGHWAY COMMITTEE OF GRANT COUNTY, WISCONSIN

THE GRANT COUNTY HIGHWAY COMMITTEE FINDS AND DETERMINES THAT:

The proper establishment, laying out, widening, enlarging, extending, constructing, improving, or maintaining a portion of highway currently designated as County Trunk Highway "B" from a point 25 feet east of the west quarter-corner of Section 13, Township 3 North, Range 3 West, thence extending easterly to a point 30 feet west and 1280 feet north of the south quarter-corner of Section 10, Township 3 North, Range 2 West, and from a point 30 feet west and 1280 feet north of the south quarter-corner of Section 10, Township 3 North, Range 2 West; thence extending easterly to a point 470 feet south and 430 feet east of the northwest corner of Section 16, Township 3 North, Range 1 West, and on roads or lands in and about and along and leading to the same, requires certain relocations or change and the acquisition of lands or interests in lands as shown on the map or copy thereof, marked, PLAT OF RIGHT OF WAY REQUIRED, PROJECT S 0205(4 & 5), PROJECT IDENTIFICATION NUMBER 5945-1-00, United States Highway 61 - Platteville Road, County Trunk Highway "B", Grant County, dated November 16, 1972, the same being sheet no. 4 through sheet no. 4.20 inclusive and

Pursuant to its authority under Section 83.08, Wisconsin Statutes, THE GRANT COUNTY HIGHWAY COMMITTEE ORDERS THAT:

(1) The said highway is hereby laid out and established to the lines and widths as shown on this plat.

(2) The required lands and interests in lands as shown on the plat shall be acquired by the County Highway Committee.

(3) This order supersedes and amends the previous order issued by the county on September 14, 1972.

The foregoing order was issued by the County Highway Committee and entered in the minutes of its meeting on Dec. 14, 1972.

Chas. A. Becker
Wendell Beetham
Bernard Wiste
Clarence J. Schauff
Nelson J. Hilke


Grant County Highway Committee

SHEET NUMBER	TOTAL SHEETS
4	


GRANT COUNTY

U. S. H. 61 – PLATTEVILLE ROAD

(C. T. H. "B")

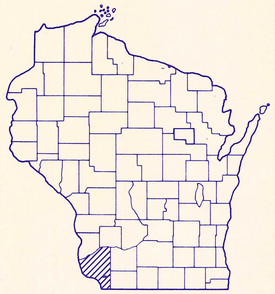

PROJECT IDENTIFICATION NUMBER	FEDERAL PROJECT DESIGNATION
5945-1-00	S 0205 (4,5)

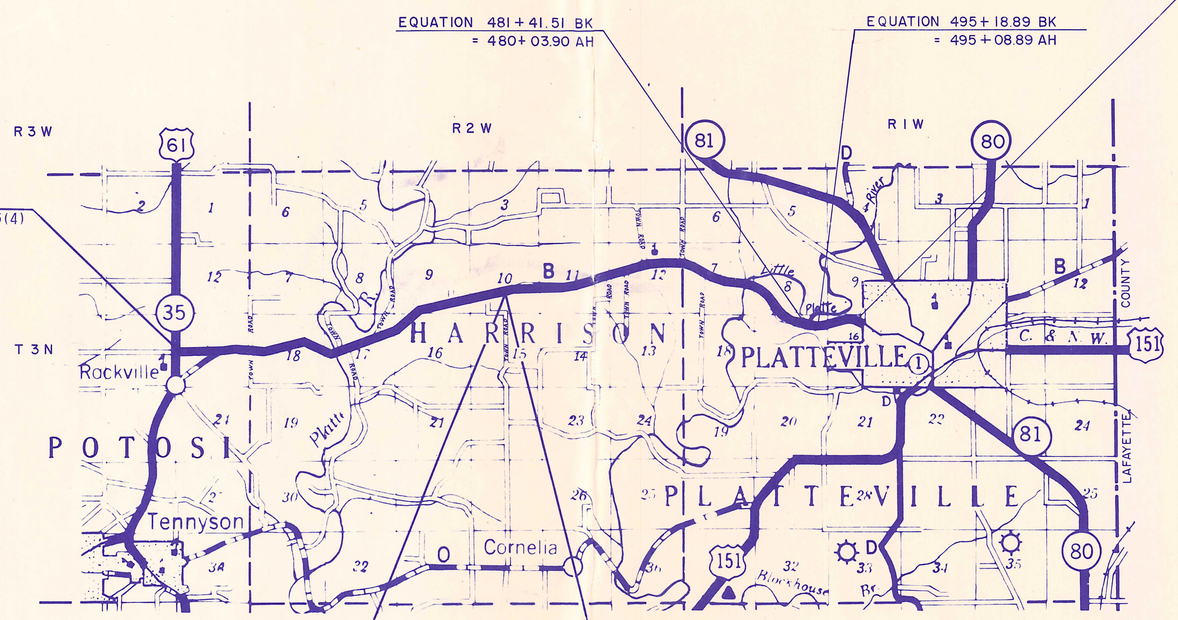

BEGIN RELOCATION ORDER – SECTION 1
PROJECT IDENTIFICATION NUMBER 5945-1-00/PROJECT S 0205(4)
STA. 0+00 = STA. 984+19, F. A. P. 3765
25' E. of the W 1/4 Cor., Sec. 13, T 3 N, R 3 W.

END RELOCATION ORDER – SECTION 1
PROJECT IDENTIFICATION NUMBER 5945-1-00/PROJECT S 0205(4)
STA. 252+00
30' W. & 1280' N. of the S 1/4 Cor., Sec. 10, T 3 N, R 2 W.

BEGIN RELOCATION ORDER – SECTION 2
PROJECT IDENTIFICATION NUMBER 5945-1-00/PROJECT S 0205(5)
STA. 252+00
30' W. & 1280' N. of the S 1/4 Cor., Sec. 10, T 3 N, R 2 W.

END RELOCATION ORDER – SECTION 2
PROJECT IDENTIFICATION NUMBER 5945-1-00/PROJECT S 0205(5)
STA. 511 + 88.86
470' S. & 430' E. OF THE NW. COR., SEC. 16, T 3 N, R 1 W.

LAYOUT
SCALE
0 2
MILES

TOTAL NET LENGTH OF CENTERLINE = 9.722 MILES

REVISION DATE
5/13/71
6/7/72
8/24/72
11/16/72

STATE OF WISCONSIN
COUNTY OF GRANT

GRANT COUNTY HIGHWAY COMMITTEE
PLAT OF RIGHT OF WAY REQUIRED

DATED MARCH 11, 1971

CONVENTIONAL SIGNS

STATE LINE
COUNTY LINE
TOWNSHIP AND RANGE LINES
SECTION LINE
QUARTER LINE
SIXTEENTH LINE
NEW CENTERLINE
NEW R.W. LINE
OLD R.W. LINE
PROPERTY LINE — P.L. +00.0
CORPORATE LIMITS — (NAME)
SLOPE INTERCEPTS — slope intercept
LOT, TIE AND OTHER MINOR DASHED LINES
UNDERGROUND FACILITY (POWER, TELEPHONE, TELEGRAPH, GAS, ETC.) — (Name or Type)
NO ACCESS
*LIMITED HIGHWAY EASEMENT
*(Shading omitted on Aerial Halftones)

*HIGHWAY HIGHWAY SEPARATION
HIGHWAY OVERPASS
*RAIL LINE OVERPASS
ALL OTHER BRIDGES
STREAM OR RIVER — (name)
LAKE — (name)
CATTLE PASS
RELOCATED STREAM OR RIVER
*TRAVELED WAY (Shown only in area of Frontage Roads, Interchanges or Dual Lanes)

CEMETERY — Cem.
FOUNDATION — Fdn.
GAS PUMP ISLAND — Gas Pump
BUILDING — type
IRON PIN — I.P.
POWER POLE
TELEPHONE POLE
RAIL LINE
TRANSMISSION TOWER AND LINE
UNDERGROUND CABLE MARKER
WELL
STONE MONUMENT
SEPTIC TANK
WINDMILL

STANDARD ABBREVIATIONS

ACRE	AC.
ABANDON	ABDN.
BARN	B.
CONCRETE	CONC.
CORN CRIB	C. C.
GARAGE	G.
HOUSE	H.
LIMITED HIGHWAY EASEMENT	L. H. E.
PROPERTY LINE	P. L.
REMAINING	REM.
SHED	S.
TANGENT	TAN.
TEMPORARY	TEMP.

REVISION DATE		PROJECT I.D.	SHEET NUMBER	TOTAL SHEETS
5/13/71		5945 – 1 – 00		
6/7/72		FEDERAL PROJECT DESIGNATION	4.1	
8/24/72				
11/16/72				
		U.S.H. 61 – PLATTEVILLE ROAD		
		C.T.H. "B" GRANT COUNTY		
		DATE MARCH 11, 1971		
CONST. PROJECT				

SCHEDULE OF LANDS AND INTERESTS REQUIRED

PARCEL NUMBER	SHEET NUMBER	OWNER	INTERESTS REQUIRED	ACRES	OPERATIONS PROJECT I.D.
1	4.2	JESSIE WOLF EST.	FEE	1.95	
2	4.2	CARLYLE J. KUSTER	FEE	1.62	
3	4.2	WISCONSIN POWER & LIGHT CO.	RELEASE OF RIGHTS	-	
4	4.2 4.3	KENNETH R. MORSEHEAD	FEE	2.51	
5					
6	4.2 4.3	NICKSON P. WUNDERLIN, VENDOR VINCENT W. KLEIN, VENDEE	FEE	5.95	
7	4.3	ISABELLE WHITE, VENDOR WALTER A. KEENE, VENDEE	FEE	1.54	
8	4.3, 4.4 & 4.5	FARMERS TELEPHONE CO.	RELEASE OF RIGHTS	-	
9	4.3, 4.4, 4.5, 4.9 & 4.10	GRANT ELECTRIC CO-OP.	RELEASE OF RIGHTS	-	
10					
11					
12	4.4	ARCHIE WOLF, VENDOR ROBERT BROGLEY, VENDEE	FEE	1.71	
13	4.4 4.5	WILLIAM WEBER	FEE & L.H.E.	4.19	
14	4.5	WESLEY HOOKS		0.01	
15					
16	4.5 4.6	RUDOLPH E. CRAPP	FEE & L.H.E.	0.88	
17	4.5 4.6	PAUL R. KLEIN	FEE	0.22	
18	4.6	CLEO I. FRIEDRICH	FEE	0.08	
19					
20					
21					
22		HAROLD BROGLEY, VENDOR ROBERT V. BROGLEY, VENDEE	FEE & L.H.E.	3.36	
23	4.6 4.7	CASPER FISHNICK	FEE	2.52	
24	4.7, 4.8, 4.9 & 4.10	PLATTEVILLE TELEPHONE CO.	RELEASE OF RIGHTS	-	
25					
26					
27	4.7	WILLIAM EDWARD BELL	FEE & L.H.E.	2.09	
28					
29	4.8	GEORGE STANTON	FEE	1.37	
30					
31	4.8	NICHOLAS F. BRUNTON, ET AL	FEE & L.H.E.	1.21	
32					
33					
34	4.8	WILLIAM MARGAN	FEE & L.H.E.	0.08	
35					

PARCEL NUMBER	SHEET NUMBER	OWNER	INTERESTS REQUIRED	ACRES	OPERATIONS PROJECT I.D.
36					
37	4.9	RALPH EASTLICK	FEE & L.H.E.	1.42	
38	4.9 4.10	JOSEPH KLEIN, ET AL, VENDOR FRANCIS KLEIN, VENDEE	FEE & L.H.E.	3.28	
39	4.10	EVA H. WEINBERGEN, ET AL, VENDOR JOHN HUNTINGTON, VENDEE	FEE	1.13	
40	4.11, 4.12, 4.13, 4.14, 4.16, 4.17, 4.19	GRANT ELECTRIC CO-OP.	RELEASE OF RIGHTS	-	
41	4.11, 4.12, 4.13, 4.14, 4.15, 4.16, 4.17 & 4.18	PLATTEVILLE TELEPHONE CO.	RELEASE OF RIGHTS	-	
42	4.11	EVA H. WEINBERGEN, ET AL, VENDOR JOHN HUNTINGTON, VENDEE	FEE	1.56	
43	4.11 4.12	MAPLEWOOD, INC.	FEE & L.H.E.	6.99	
44	4.13	EDWARD J. NOEL	FEE	0.71	
45	4.13	DOUGLAS A. STEINBACH	FEE	0.64	
46	4.13 4.14	LESTER A. WEINBERGEN, ET AL, VENDOR NICHOLAS F. BRUNTON, VENDEE	FEE	1.03	
47	4.14	ROBERT S. MC FALL	FEE	1.00	
48					
49	4.14 4.15	CHRIS W. HEER, ET AL	FEE & L.H.E.	4.37	
50	4.11	DAIRYLAND POWER CO-OP	RELEASE OF RIGHTS	——	
51	4.15	DEXTER LEROY STEINBACH	FEE & L.H.E.	1.60	
52					
53	4.15 4.16	KENNETH OLSON	FEE	2.24	
54	4.16	BEN C. CAMPBELL	FEE	0.11	
55	4.16	RICHARD HUEHNE, VENDOR JOHN W. HUEHNE, VENDEE	FEE & L.H.E.	0.42	
56	4.17	ANTHONY H. HYING, VENDOR LEO P. HYING, VENDEE	FEE	1.38	
57	4.17	HOMER J. DIETZMAN	FEE	0.44	
58	4.17	STANLEY E. EWING	FEE	0.14	
59	4.17	JOHN H. RISIC	FEE	0.21	
60	4.18	NORTHERN NATURAL GAS CO.	RELEASE OF RIGHTS	——	
61	4.18	ERVIN JOHNSEN	FEE	0.53	
62	4.18	DONALD N. MILES	FEE	2.25	
63	4.18 4.19	BLANCHE B. SHEPARD	FEE	2.83	
64	4.19	BURTON NODORFT	FEE	0.72	
65	4.19	WILFRED B. SOWLS	FEE	0.23	
66	4.20	REZA REZAZADEH	FEE	0.25	
67	4.20	BLANCHE E. KARRMAN TRUST	FEE	0.14	
68					
69					
70					

REVISION DATE		PROJECT I.D.	SHEET NUMBER	TOTAL SHEETS
5/13/71		5945-1-00	4.2	
6/7/72		FEDERAL PROJECT DESIGNATION		
8/24/72				
11/16/72				

PLAT OF RIGHT OF WAY REQUIRED
C.T.H. "B" GRANT COUNTY

SCALE 0 100 200 Ft.

DATE MARCH 11, 1971

CONST. PROJECT

NOTE:
BEARINGS SHOWN ON THIS PLAT ARE THE TRUE BEARINGS OF EACH TANGENT TO THE NEAREST MINUTE.

TOWN OF POTOSI

P.I. = 17+40.9
I. = 195°-31'
Δ. = 15°-31'
D. = 2°-00'
T. = 390.3
L. = 775.8
E. = 26.45'
R. = 2,864.8'

P.I. = 26+78.7
I. = 155°-48'
Δ. = 24°-12'
D. = 4°-00'
T. = 307.1'
L. = 605.0'
E. = 32.5'
R. = 1432.4'

N

SW-NW

SE-NW

NW-SW

NE-SW

U.S.H. 61

2 CARLYLE J. KUSTER
160.0 AC. TOTAL
158.2 AC. REM.

3 WISCONSIN POWER & LIGHT CO.

6 NICKSON P. WUNDERLIN, VENDOR
VINCENT W. KLEIN, VENDEE
FOR AC. SEE SHEET 4.3

4 KENNETH R. MORSEHEAD
122.6 AC. IN OTHER FARM
84.4 AC. TOTAL THIS FARM
80.9 AC. REM. THIS FARM

1 JESSIE WOLF EST.
40.0 AC. TOTAL
37.8 AC. REM.

6"A" + 00 = 0+00

8"A" + 00

9+00

11+00

P.L. 13+04

P.I. 17+40.9

S 89°-34' E

P.L.

P.I. 13+71.6

P.T. 29+76.6

SILO

SHED

10"B" + 00 = 25+00

S 74°-02' E

P.I. 25.65

P.I. 21+09

P.I. 9"B" + 45.5

6"B" + 00

P.C. 13+50.6

P.C. 5°18' + 71.2

P.T. 21+26.4

P.I. 7"B" + 61.7

N 54°-36' E

P.I. 26+78.7

BEGIN RELOCATION ORDER
PROJECT IDENTIFICATION NUMBER
5945-1-00, STA. 0+00

4"A" + 00 = 2+00

0"A" + 00 = 0+00

5"A"

IN 0°-18' W

U.S.H. 61 — TO ROCKVILLE = 0.5 MILES

P.L. 0+00

SLOPE INTERCEPTS

EXISTING C.T.H. "B"

P.I. = 7"B" + 61.7
I. = 153°-48'
Δ. = 26°-12'
D. = 7°-00'
T. = 190.5'
L. = 374.3'
E. = 21.9'
R. = 818.5'

REVISION DATE		PROJECT I.D. 5945-1-00	SHEET NUMBER	TOTAL SHEETS
5/13/71				
6/7/72		FEDERAL PROJECT DESIGNATION	4.3	
8/24/72				
11/16/72				

PLAT OF RIGHT OF WAY REQUIRED
C.T.H. "B" GRANT COUNTY

SCALE 0 100 200 Ft.

DATE MARCH 11, 1971

CONST. PROJECT

NOTE:
BEARINGS SHOWN ON THIS PLAT ARE THE TRUE BEARINGS OF EACH TANGENT TO THE NEAREST MINUTE.

TOWN OF POTOSI

P.I. = 26 + 78.7
I. = 155° + 48'
Δ. = 24° - 12'
D. = 4° - 00'
T. = 307.1'
L. = 605.0'
E. = 32.5'
R. = 1,432.4'

P.I. = 43 + 83.7
I. = 192° - 42'
Δ. = 12° - 42'
D. = 2° - 00'
T. = 318.8'
L. = 635.0'
E. = 17.7'
R. = 2,864.8'

N

SW - NE

SE - NE

NW - SE

NE - SE

P.I. = 1"C" + 50
I. = 180° - 47'
Δ. = 0° - 47'

P.I. = 2"D" + 50
I. = 177° - 49'
Δ. = 2° - 11'

P.I. = 7"B" + 61.7
I. = 153° - 48'
Δ. = 26° - 12'
D. = 7° - 00'
T. = 190.5'
L. = 374.3'
E. = 21.9'
R. = 818.5'

(4) KENNETH R. MORSEHEAD
FOR AC. SEE SHEET 4.2

(6) NICKSON P. WUNDERLIN, VENDOR
VINCENT W. KLEIN, VENDEE
285.0 AC. TOTAL
275.8 AC. REM.

(7) ISABELLE WHITE, VENDOR
WALTER A. KEENE, VENDEE
65.6 AC. TOTAL
63.9 AC. REM.

(8) FARMERS TELEPHONE CO.

(9) GRANT ELECTRIC CO-OP

C. T. H. "B"

TOWN ROAD

SLOPE INTERCEPTS

CONC. PLATFORM

P.C. 23 + 71.6
P.T. 29 + 76.6
P.T. 9"B" + 44.5
P.C. 30 + 56.9
P.T. 46 + 99.9
P.C. 30 + 64.9
P.T. 46 + 99.9
P.C. 4"C" + 00 = P.C. 0"C" + 00 = 52 + 80
P.C. 0"D" + 00
P.I. 7"B" + 61.7
P.I. 26 + 78.7
P.I. 43 + 83.7
P.I. 1"C" + 50
P.I. 2"D" + 50
P.I. 39 + 17.5
P.L. 52 + 80
P.L. 30 + 50
P.L. 38 + 00
P.L. 39 + 00
P.L. 49 + 00
P.L. 51 + 30
10"B" + 00 = 25 + 00
N 54°-36' E
S 74° - 02' E
N 28° - 24' E
N 81° - 47' E
N 09° - 50' W
N 11° - 37' W
N 10° - 34' E
S 65° - 30' E

REVISION DATE		PROJECT I.D	SHEET NUMBER	TOTAL SHEETS
5/13/71		5945-1-00		
6/7/72		FEDERAL PROJECT DESIGNATION	4.4	
8/24/72				
11/16/72				

PLAT OF RIGHT OF WAY REQUIRED
C.T.H. "B" GRANT COUNTY

SCALE 0 100 200 Ft.

DATE MARCH 11, 1971

CONST. PROJECT

NOTE:
BEARINGS SHOWN ON THIS PLAT ARE THE TRUE BEARINGS OF EACH TANGENT TO THE NEAREST MINUTE.

P.I. = 62 + 75.0
I. = 156° - 34'
Δ. = 23° - 26'
D. = 4° - 30'
T. = 264.1'
L. = 520.7'
E. = 27.1'
R. = 1,273.2'

P.I. = 73 + 50.0
I. = 189° - 00'
Δ. = 9° - 00'
D. = 1° - 30'
T. = 300.6'
L. = 600.0'
E. = 11.8'
R. = 3,819.7'

P.I. = 83 + 98.9
I. = 207° - 44'
Δ = 27° - 44'
D. = 2° - 30'
T. = 565.8'
L. = 1,109.3'
E. = 68.8'
R. = 2,291.8'

TOWN OF HARRISON

N

TOWN ROAD

P.I. = 1"C" + 50
I. = 180° - 47'
Δ. = 0° - 47'

P.L. 52 + 80

N 0° - 50' W

66'

4"C"

T 3 N R 3 W | 13 18 | R 2 W T

P.I. 1"C" + 50

54 + 30

75'

55 + 00

75'

57 + 00

50

S 85° - 30' E

60

36

70

P.I. = 2"D" + 50
I. = 177° - 49'
Δ. = 2° - 11'

N 1° - 37' W

N 0° - 34' E

0"C" + 00 = 52 + 80

P.I. 2"D" + 50

55 + 00

70

57 + 00

60

66'

P.L. 52 + 80

TOWN ROAD

P.L. 66 + 42

P.C. 60 + 10.9

P.I. 65 + 31.6

SW-NW

(12) ARCHIE WOLF, VENDOR
ROBERT BROGLEY, VENDEE

(9) GRANT ELECTRIC CO-OP

P.I. 73 + 50.0

73 + 00

70

70 + 49.4

55 + 00

50

N 71° - 05' E

SE-NW

(13) WILLIAM WEBER
158.0 AC. TOTAL
148.4 AC. REM.

P.I. 83 + 98.9

15 + 00

50

50

35

CONC. STEP

168' ON TAN

80

C.T.H. "B"

N 80° - 06' E

166'

50

50

90

L.H.E. DRAINAGE
0.4 AC. TEMP.

423' TO TAN.

78 + 00

50

P.C. 78 + 33

P.T. 75 + 49.4

(13) WILLIAM WEBER

P.L.

T 3 N R 2 W | 18 | T

ASSUMED P.L.

N

65 + 21

60

55 + 00

60

P.C. 70 + 49.4

SLOPE INTERCEPTS

P.I. 62 + 75.0

(8) FARMERS TELEPHONE CO.

NW-SW

(12) ARCHIE WOLF, VENDOR
ROBERT BROGLEY, VENDEE
120.6 AC. TOTAL
116.8 AC. REM.

P.L. 66 + 42

NE-SW

CARLYLE J. KUSTER

REVISION DATE		PROJECT I.D.	SHEET NUMBER	TOTAL SHEETS
5/13/71		5945-1-00	4.5	
6/7/72		FEDERAL PROJECT DESIGNATION		
8/24/72				
11/16/72				

PLAT OF RIGHT OF WAY REQUIRED
C.T.H. "B" GRANT COUNTY

SCALE 0 100 200 Ft.

DATE MARCH 11, 1971

CONST. PROJECT

NOTE:
BEARINGS SHOWN ON THIS PLAT ARE THE TRUE BEARINGS OF EACH TANGENT TO THE NEAREST MINUTE.

TOWN OF HARRISON

P.I. = 83+98.9
I. = 207°-44'
Δ. = 27°-44'
D. = 2°-30'
T. = 565.8'
L. = 1,109.3'
E. = 68.8'
R. = 2,291.8'

P.I. = 100+15.0
I. = 200°-35'
Δ. = 20°-35'
D. = 3°-30'
T. = 297.3'
L. = 588.1'
E. = 26.8'
R. = 1,637.0'

P.I. = 108+98.1
I. = 136°-43'
Δ. = 43°-17'
D. = 6°-00'
T. = 378.9'
L. = 721.4'
E. = 72.4'
R. = 954.9'

N

P.I. 83+98.9

397.8 ON TAN

IN 80°-06' E

80

50'

66'

50

90'

90

82+00

87+00 50

89+42.4 75

SLOPE INTERCEPTS

SW-NE

SE-NE

13 WILLIAM WEBER

WILLIAM WEBER

9 GRANT ELECTRIC CO-OP

95+00 75

97+17.7 60

P.I. 100+15.0

75'

P.I.

S 72°-09' E

66'

C.T.H. "B"

WELL 9

92+41 33

93+33 33

14 WESLEY HOOKS 0.5 AC. TOTAL 0.4 AC. REM.

L.H.E. DRAINAGE FOR AC. SEE SHEET 4.4

L.H.E. DRAINAGE 0.5 AC. TEMP.

P.C. 78+33.1

423' TO TAN

T 3 N R 2 W 18

ASSUMED

P.I. 89+42.4

P.I. 92+38.6

P.I. 93+63.4

P.L.

P.L. 100+29

8 FARMERS TELEPHONE CO.

94+05 217

17 PAUL R. KLEIN FOR AC. SEE SHEET 4.6

T 3 N R 2 W 18 17

P.C. 105+19.2

P.C. 97+17.7

98+70

S 31°-33' E

100'

50'

P.I. 103+25

103+34

P.T. 103+05.8

16 RUDOLPH E. CRAPP 74.0 AC. TOTAL 71.9 AC. REM.

NW-SE

NE-SE

CARLYLE J. KUSTER

L.H.E. DRAINAGE 0.2 AC. TEMP.

105+98

108+00

P.I. 108+98.1

110

N 85°-11 E

100

PLATTE RIVER

REVISION DATE		PROJECT I.D.	SHEET NUMBER	TOTAL SHEETS
5/13/71		5945-1-00		
6/7/72		FEDERAL PROJECT DESIGNATION	4.6	
8/24/72				
11/16/72				

PLAT OF RIGHT OF WAY REQUIRED
C.T.H. "B" GRANT COUNTY

SCALE 0 100 200 Ft.

DATE MARCH 11, 1971

CONST. PROJECT

NOTE:
BEARINGS SHOWN ON THIS PLAT ARE THE TRUE BEARINGS OF EACH TANGENT TO THE NEAREST MINUTE.

P.I. = 108 + 98.1
I. = 136° - 43'
Δ. = 43° - 17'
D. = 6° - 00'
T. = 378.9'
L. = 721.4'
E. = 72.4'
R. = 954.9'

P.I. = 121 + 00
I. = 138° - 09'
Δ. = 41° - 51'
D. = 6° - 00'
T. = 365.1'
L. = 697.5'
E. = 67.4'
R. = 954.9'

P.I. = 132 + 00
I. = 214° - 55'
Δ. = 34° - 55'
D. = 4° - 30'
T. = 400.5'
L. = 775.9'
E. = 61.5'
R. = 1,273.2'

P.I. = 141 + 00
I. = 163° - 54'
Δ = 16° - 06'
D. = 2° - 30°
T. = 324.2'
L. = 644.0'
E. = 22.8'
R. = 2,291.8'

P.I. = 1"F" + 80.5
I. = 157° - 44'
Δ. = 22° - 16'
D. = 14° - 00'
T. = 80.5'
L. = 159.0'
E. = 7.9'
R. = 244.3'

TOWN OF HARRISON

SW-NW

SE-NW

NW-SW

NE-SW

PLATTE RIVER

TOWN ROAD

BENJAMIN C. CAMPBELL, VENDOR
PAUL R. KLEIN, VENDEE

HAROLD BROGLEY, VENDOR
ROBERT V. BROGLEY, VENDEE

CASPER FISHNICK
56.0 AC. TOTAL
48.1 AC. REM.

PAUL R. KLEIN
7.0 AC. TOTAL
4.7 AC. REM.

CLEO F. FRIEDRICH
1.3 AC. TOTAL
1.0 AC. REM.

ABDN. H

BARN REMOVED

L. H. E. DRAINAGE
FOR AC. SEE SHEET 4.5

RUDOLPH E. CRAPP
FOR AC. SEE SHEET 4.5

HAROLD BROGLEY, VENDOR
ROBERT V. BROGLEY, VENDEE
FOR AC. SEE SHEET 4.8

SLOPE INTERCEPTS

P.C. 105 + 19.2
P.I. 108 + 98.1
P.T. 112 + 40.6
P.C. 117 + 35.9
P.I. 112 + 00
P.C. 119 + 80
P.I. 121 + 00
P.C. 123 + 80
P.C. 127 + 99.5
P.C. 1"F" + 00
P.T. 1"F" + 59
P.T. 124 + 32.4
P.I. 124 + 00
P.C. 125 + 82
P.C. 126 + 30
P.I. 126 + 28
P.I. 132 + 00
P.C. 137 + 75.8
P.I. 137 + 60
P.I. 135 + 75.4
P.I. 141 + 00
3"F" + 37.45 = 128 + 30
9"E" + 89.82 = 121 + 80
11"E" + 89.82
10"E" = 16 W
135 + 75.4
133 + 00
130 + 30
N 78° - 16' E.
N 55° - 17' W.
N 43° - 21' E.
N 23° - 01' W.
S 51° - 33' E.
N 85° - 11' E.
P.L. 100 + 29
P.L. 126 + 28
T. 3 N. R. 2 W. 18 17
T. 3 N. R. 2 W. 17
22
23
17
16
18

TOWN

N OF HARRISON

P.I.	=	141+00
I.	=	163°-54'
Δ.	=	16°-06'
D.	=	2°-30'
T.	=	324.2'
L.	=	644.0'
E.	=	22.8'
R.	=	2,291.8'

P.I.	=	153+70
I.	=	208°-30'
Δ.	=	28°-30'
D.	=	3°-00'
T.	=	485.1'
L.	=	950.0'
E.	=	60.6'
R.	=	1,909.9'

P.I.	=	167+92.1
I.	=	130°-42'
Δ.	=	49°-18'
D.	=	7°-00'
T.	=	375.6'
L.	=	704.3'
E.	=	82.1'
R.	=	818.5'

P.I.	=	1"G"+58
I.	=	209°-21'
Δ.	=	29°-21'
D.	=	15°-00'
T.	=	100.0'
L.	=	195.7'
E.	=	12.9'
R.	=	381.97'

NW-NE

NE-NE

SW-NE

SE-NE

NW-SE

NE-SE

PLATTE RIVER

6" TOWN ROAD

DOROTHY BURKHOLDER

HAROLD BROGLEY, VENDOR
ROBERT V. BROGLEY, VENDEE
FOR AC. SEE SHEET 4.8

L.H.E. DRAINAGE
0.8 AC. TEMP

CASPER FISHNICK
FOR AC. SEE SHEET 4.6

WILLIAM EDWARD BELL
21 AC. TOTAL
206.9 AC. REM.

L.H.E. DRAINAGE
0.1 AC. TEMP

PLATTEVILLE TELEPHONE CO.

SLOPE INTERCEPTS

C.T.H. "B"

P.C. 164+16.5

P.I. 167+92.1

P.C. 137+75.8

P.T. 114+19.8

P.C. 0"G"+58

P.T. 2"G"+57

P.T. 158+30.9

P.L. 153+70

P.L. 154+60

P.L. 151+95

P.L. 141+00

P.L. 137+80

P.T. 135+75.4

P.L. 165+14

0"G"+00
151+00

N 62°-10' E

N 78°-16' E

N 84°-37' E

S 69°-20' E

T 30 N
R 2 W
17

T 30 N
R 2 W
17 16

REVISION DATE		PROJECT I.D. 5945-1-00	SHEET NUMBER 4.7	TOTAL SHEETS
5/13/71				
6/7/72		FEDERAL PROJECT DESIGNATION		
8/24/72				
11/16/72				

PLAT OF RIGHT OF WAY REQUIRED
C.T.H. "B" GRANT COUNTY

SCALE 0 100 200 Ft.

DATE MARCH 11, 1971

CONST. PROJECT

NOTE:
BEARINGS SHOWN ON THIS PLAT ARE THE TRUE BEARINGS OF EACH TANGENT TO THE NEAREST MINUTE.

REVISION DATE		PROJECT I.D.	SHEET NUMBER	TOTAL SHEETS
5/13/71		5945-1-00	4.8	
6/7/72		FEDERAL PROJECT DESIGNATION		
8/24/72				
11/16/72				

PLAT OF RIGHT OF WAY REQUIRED
C.T.H. "B" GRANT COUNTY

SCALE 0 100 200 Ft.

DATE MARCH 11, 1971

CONST. PROJECT

NOTE:
BEARINGS SHOWN ON THIS PLAT ARE THE TRUE BEARINGS OF EACH TANGENT TO THE NEAREST MINUTE.

P.I. = 167 + 92.1
I. = 130°-42'
Δ. = 49°-18'
D. = 7°-00'
T. = 375.6'
L. = 704.3'
E. = 82.1'
R. = 818.5'

P.I. = 183 + 56
I. = 206°-38'
Δ. = 26°-38'
D. = 4°-30'
T. = 301.3'
L. = 591.9'
E. = 35.2'
R. = 1,273.2'

TOWN OF HARRISON

SW-SW | SE-SW | NW-NW | NE-NW | SW-NW | SE-NW

RAYMOND W. HARTZ

ROBERT V. BROGLEY

P.I. 197 + 46

P.I. 193 + 56

P.I. 183 + 56

P.I. 171 + 20.8

P.I. 167 + 92.1

P.C. 180 + 54.7

P.T. 186 + 46.6

P.C. 164 + 16.5

P.L. 182 + 88

P.L. 165 + 14

P.L. 190 + 22
190 + 38
45°

N 68°-00 E.

N 41°-22' E.

S 89°-20' E.

C.T.H. "B"

SLOPE INTERCEPTS

L.H.E. DRAINAGE
0.1 AC. TEMP.

L.H.E. DRAINAGE
0.8 AC. TEMP.

L.H.E. DRAINAGE
FOR AC. SEE
SHEET 4.7

(22) HAROLD BROGLEY, VENDOR
ROBERT V. BROGLEY, VENDEE
37.7 AC. TOTAL
36.7 AC. REM.

(31) NICHOLAS F. BRUNTON, ET AL
39 AC. TOTAL
36.8 AC. REM.

(9) GRANT ELECTRIC CO.-OR

(24) PRAIRIEVILLE TELEPHONE CO.

(29) GEORGE STANTON
33.2 AC. TOTAL
32.9.7 AC. REM.

(34) WILLIAM MARSAN
FOR AC. SEE SHEET 4.9

P.I. =	211 + 79
I. =	212°-09'
Δ. =	32°-09'
D. =	4°-30'
T. =	366.9'
L. =	714.4'
E. =	51.8'
R. =	1,273.2'

P.I. =	227 + 70
I. =	157°-00'
Δ. =	23°-00'
D. =	3°-30'
T. =	333.1'
L. =	657.1'
E. =	33.5'
R. =	1,637.0'

TOWN OF HARRISON

N

REVISION DATE		PROJECT I.D	SHEET NUMBER	TOTAL SHEETS
5/13/71		5945-1-00	4.9	
6/7/72		FEDERAL PROJECT DESIGNATION		
8/24/72				
11/16/72				

PLAT OF RIGHT OF WAY REQUIRED
C.T.H. "B" GRANT COUNTY

SCALE 0 100 200 Ft.

DATE MARCH 11, 1971

CONST. PROJECT

NOTE:
BEARINGS SHOWN ON THIS PLAT ARE THE TRUE BEARINGS OF EACH TANGENT TO THE NEAREST MINUTE.

(37) RALPH EASTLICK
241 AC. TOTAL
237.5 AC. REM.

(38) JOSEPH KLEIN, ET AL, VENDOR
FRANCIS KLEIN, VENDEE
318 AC. TOTAL
310.7 AC. REM.

P.I. 211 + 79

P.C. 211 + 34 TOWN ROAD

66'

SW-SE

SE-SE

GRANT ELECTRIC CO-OP (9)

L.H.E. DRAINAGE
0.7 AC. TEMP.

SLOPE INTERCEPTS

L.H.E. DRAINAGE
0.7 AC. TEMP.
JOSEPH KLEIN, ET AL, VENDOR
FRANCIS KLEIN, VENDEE

L.H.E. DRAINAGE
0.3 AC. TEMP.

(24) PLATTEVILLE TELEPHONE CO.

(37) RALPH EASTLICK

L.H.E. DRAINAGE
FOR AC. SEE
SHEET 4.8

(34) WILLIAM MARGAN
121 AC. TOTAL
120.8 AC. REM.

GRANT ELECTRIC CO-OP (9)

P.C. 224 + 36.9

P.I. 227 + 70

S 79°-51' E.

42.1' ON TAN.

51.2' TO TAN.

ASSUMED

T 3 N R 2 W — 9 10 16 15

P.L.

REVISION DATE		PROJECT I.D.	SHEET NUMBER	TOTAL SHEETS
5/13/71		5945-1-00		
6/7/72		FEDERAL PROJECT DESIGNATION	4.10	
8/24/72				
11/16/72				

PLAT OF RIGHT OF WAY REQUIRED
C.T.H. "B" GRANT COUNTY

SCALE 0 100 200 Ft.

DATE MARCH 11, 1971

CONST. PROJECT

NOTE:
BEARINGS SHOWN ON THIS PLAT ARE THE TRUE BEARINGS OF EACH TANGENT TO THE NEAREST MINUTE.

TOWN OF HARRISON

NW-SW

NE-SW

SW-SW

SE-SW

N

P.I.	= 227 + 70	P.I.	= 242 + 43.8
I.	= 157°-00'	I.	= 164°-52'
Δ.	= 23°-00'	Δ.	= 15°-08'
D.	= 3°-30'	D.	= 1°-00'
T.	= 333.1'	T.	= 761.1'
L.	= 657.1'	L.	= 1,513.3'
E.	= 33.5'	E.	= 50.3'
R.	= 1,637.0'	R.	= 5,729.6'

PLATTEVILLE TELEPHONE CO. (24)

(38) JOSEPH KLEIN, ET AL, VENDOR
FRANCIS KLEIN, VENDEE
FOR AC. SEE SHEET 4.9

(39) EVA H. WIENBERGEN, ET AL, VENDOR
JOHN HUNTINGTON, VENDEE
240 AC. TOTAL
236.7 AC. REM.

(38) JOSEPH KLEIN, ET AL, VENDOR
FRANCIS KLEIN, VENDEE

(39) EVA H. WIENBERGEN, ET AL, VENDOR
JOHN HUNTINGTON, VENDEE

(9) GRANT ELECTRIC CO-OP

P.C. 224 + 36.9

P.T. 230 + 94.0

P.C. 234 + 82.7

P.I. 227 + 70

P.I. 236 + 10

P.I. 238 + 10

P.I. 242 + 43.8

P.T. 249 + 96.0

3"I" + 50 = 238 + 10

S 79°-51' E.

42.1' ON TAN.

372' TO TAN.

N 77°-09' E.

N 1°-07' W.

N 62°-01' E.

230

228 + 00

230 + 94.0

235 + 60

236 + 28

239 + 50

240

252 + 00

253 + 50

55'

50'

60'

66'

250

616.

C.T.H. "B"

TO PLATTEVILLE ± 5.2 MILES

I S

S

B

H

SILO

S

END RELOCATION ORDER
PROJECT IDENTIFICATION NUMBER
5945-1-00 STA. 252 + 00

SLOPE INTERCEPTS

T 3 N
R 2 W
9 10
16 15

T 3 N
R 2 W
10
15

REVISION DATE	PROJECT I. D.	SHEET NUMBER	TOTAL SHEETS
8/24/72	5945-1-00		
11/16/72	FEDERAL PROJECT DESIGNATION	4.11	

PLAT OF RIGHT OF WAY REQUIRED

C.T.H."B" GRANT COUNTY

SCALE 0 100 200Ft.

DATE JUNE 7, 1972

Const. Project

NOTE:
BEARINGS SHOWN ON THIS PLAT ARE THE TRUE BEARINGS OF EACH TANGENT TO THE NEAREST MINUTE.

P. I. = 267+42.25
I. = 206°-13'-00"
Δ. = 26°-13'-00"
D. = 3°-30'
T. = 381.20'
L. = 749.05'
E. = 43.80'
R. = 1637.02'

T 3 N R 2 W 10

T 3 N R 2 W 10 11

SW - NE

SE - NE

TOWN OF HARRISON

(42) EVA H. WIENBERGEN ET AL VENDOR
JOHN HUNTINGTON VENDEE

(50) DAIRYLAND POWER CO-OP

(43) MAPLEWOOD INC.

L.H.E. DRAINAGE
0.1 AC. PERM.

NE - SW

NW - SE

NE - SE

NOTE:
PROJECT SO 205 (5) TANGENT BEARING N62°-03'E = TANGENT BEARING N 62°-01'E PROJECT SO 205(4)

SLOPE INTERCEPTS

P.I. 267+42.25

P.C. 263+61.05

P.T. 271+10.10

N88°-16'E

N62°-03'E

N62°-01'E

C.T.H. "B"

EXISTING C.T.H. "B"

USH 61
4.8 MILES

(41) PLATTEVILLE TELEPHONE CO.

(40) GRANT ELECTRIC CO-OP

(43) MAPLEWOOD INC.
FOR AC. SEE SHEET 4.12

(42) EVA H. WIENBERGEN ET AL VENDOR
JOHN HUNTINGTON VENDEE
240 AC. AC. TOTAL
~~230~~ 232.8 AC. REM.

SW - SE

SE - SW

SE - SE

BEGIN RELOCATION ORDER SO 205(5)
PROJ. I.D. 5945-1-00, STA. 252+00
= STATION 252+00, PROJECT SO 205 (4)

Catalog No. 2130-D175

REVISION DATE		PROJECT I.D. 5945-1-00	SHEET NUMBER	TOTAL SHEETS
8/24/72				
11/16/72		FEDERAL PROJECT DESIGNATION	4.12	

PLAT OF RIGHT OF WAY REQUIRED


C.T.H."B" GRANT COUNTY

SCALE 0 100 200Ft.

DATE JUNE 7, 1972

Const. Project

NOTE:
BEARINGS SHOWN ON THIS PLAT ARE THE TRUE BEARINGS OF EACH TANGENT TO THE NEAREST MINUTE.

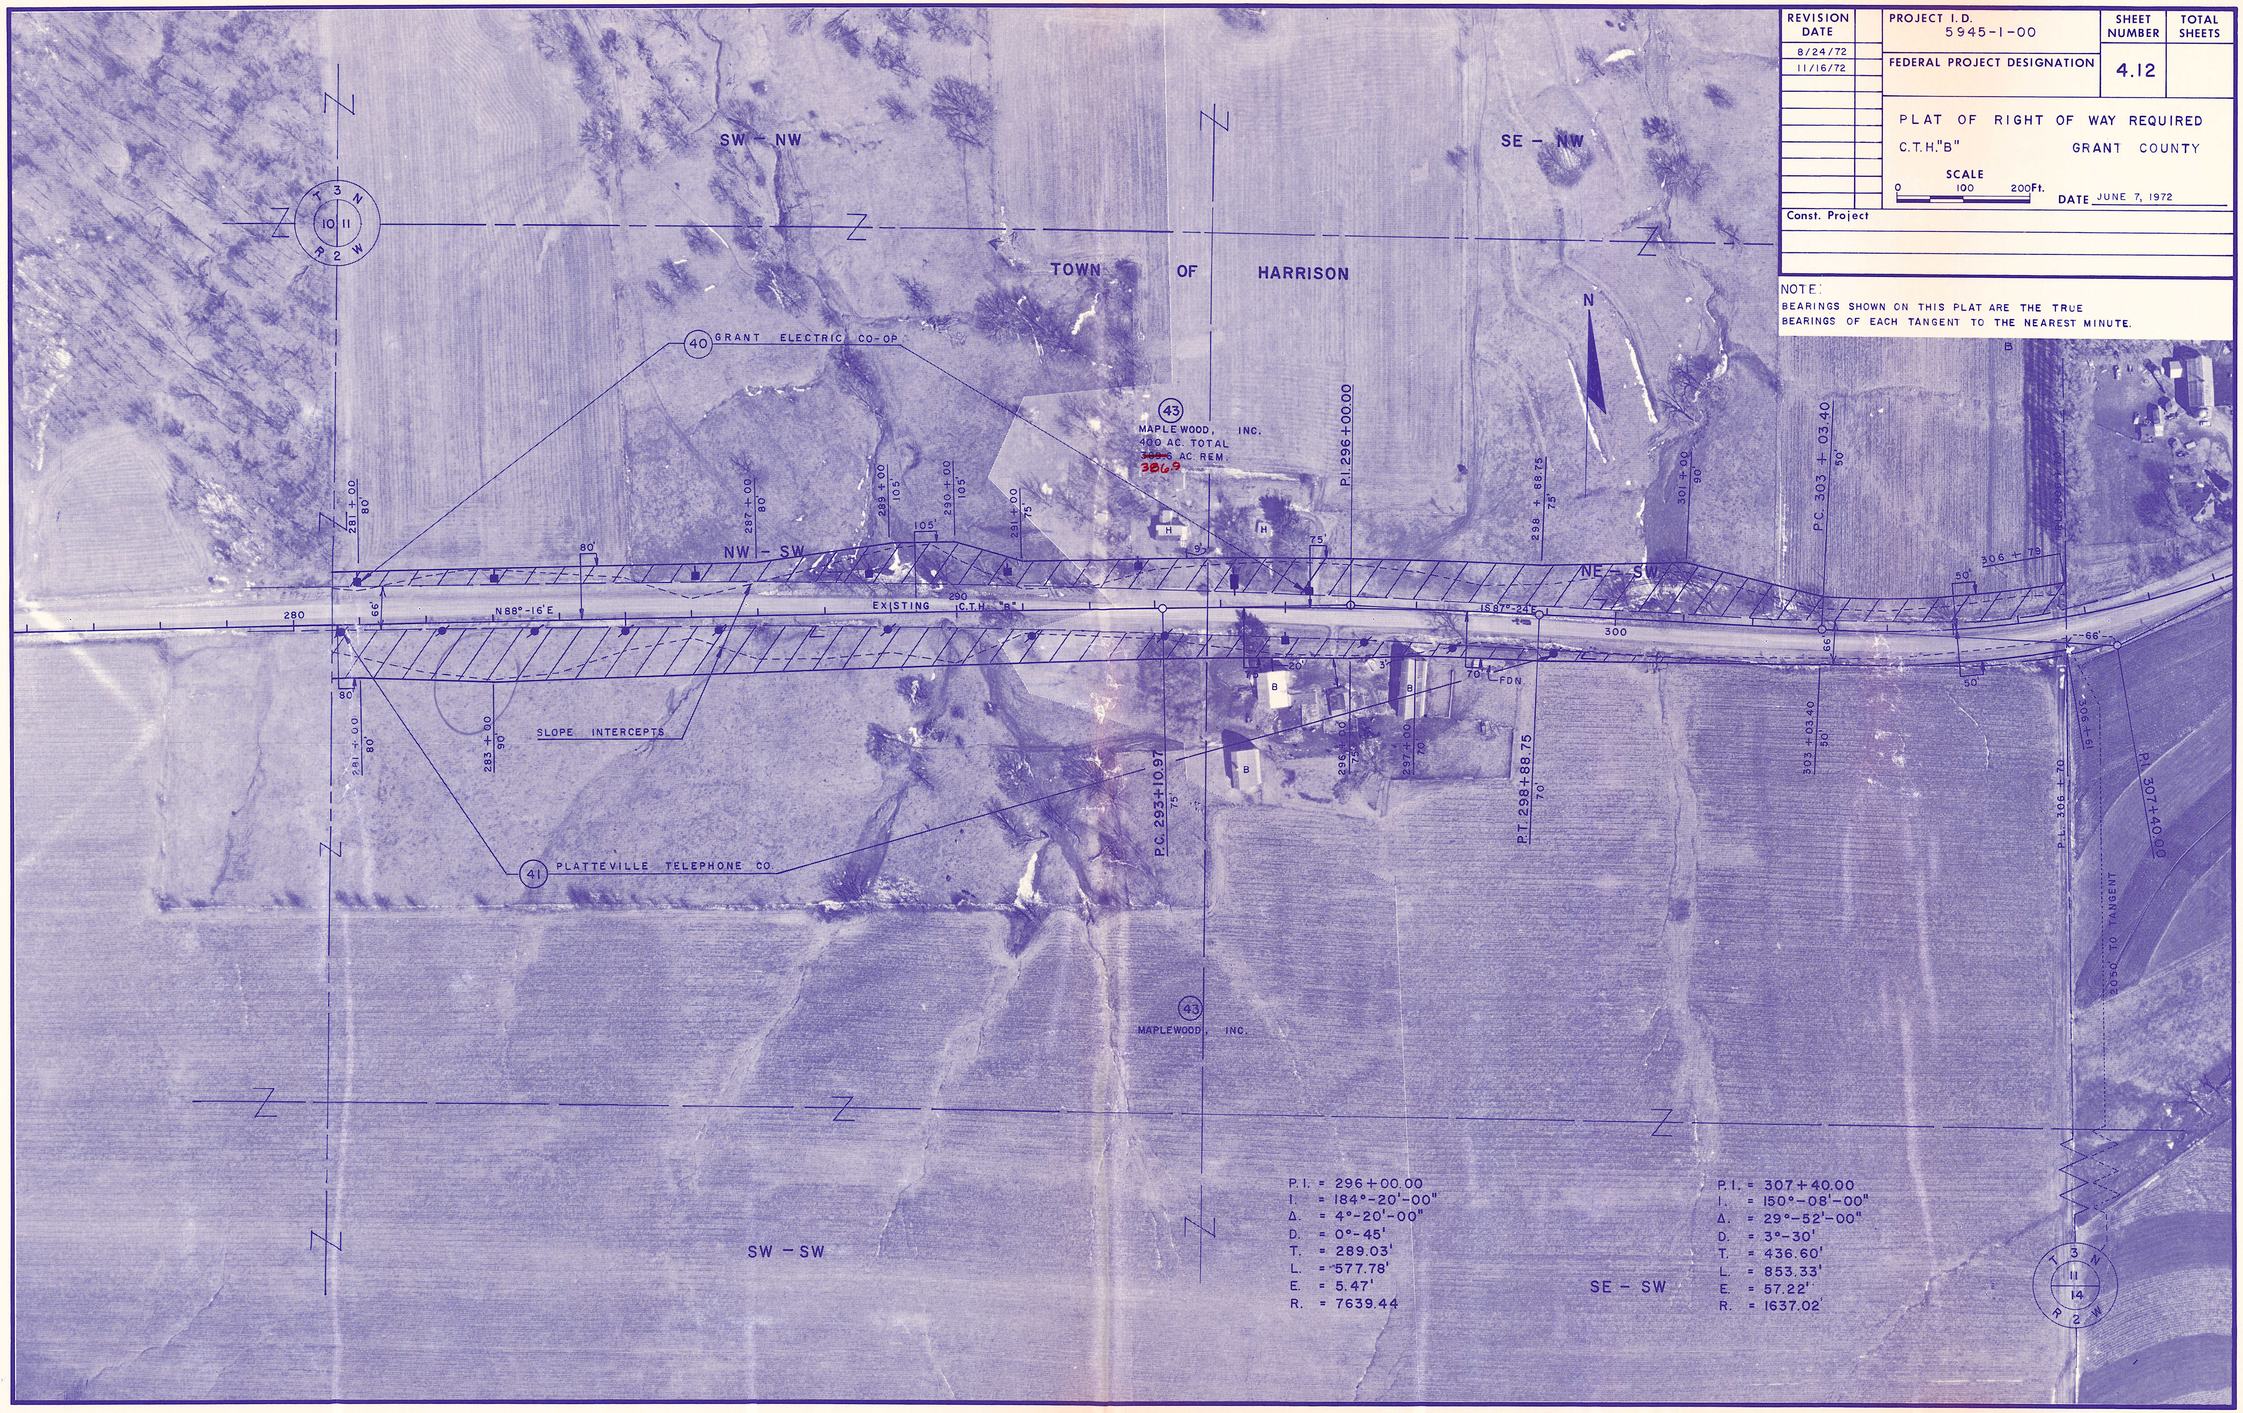

P.I. = 296+00.00
I. = 184°-20'-00"
Δ. = 4°-20'-00"
D. = 0°-45'
T. = 289.03'
L. = 577.78'
E. = 5.47'
R. = 7639.44

P.I. = 307+40.00
I. = 150°-08'-00"
Δ. = 29°-52'-00"
D. = 3°-30'
T. = 436.60'
L. = 853.33'
E. = 57.22'
R. = 1637.02'

T 3 N
11 14
R 2 W

REVISION DATE		PROJECT I.D. 5945-1-00	SHEET NUMBER	TOTAL SHEETS
8/24/72		FEDERAL PROJECT DESIGNATION	4.13	
11/16/72				

PLAT OF RIGHT OF WAY REQUIRED
C.T.H."B" GRANT COUNTY

SCALE 0 100 200Ft.

DATE JUNE 7, 1972

Const. Project

NOTE:
BEARINGS SHOWN ON THIS PLAT ARE THE TRUE BEARINGS OF EACH TANGENT TO THE NEAREST MINUTE.

TOWN OF HARRISON

N

SW – NE

(44) EDWARD J. NOEL
88.8 AC. TOTAL
87.2 AC. REM.

(40) GRANT ELECTRIC CO-OP

(46) LESTER A. WEINBERGEN ET AL VENDOR
NICHOLAS F. BRUNTON, VENDEE
143.3 AC. TOTAL
139.6 AC. REM.

SE-NE

P.I. = 307+40.90
I. = 150°-08'-00"
Δ = 29°-52'-00"
D = 3°-30'
T. = 436.60'
L. = 853.33'
E. = 57.22'
R. = 1637.02'

P.I. = 325 + 50.00
I. = 208°-29'
Δ = 28°-29'
D = 3°-30'
T. = 415.50'
L. = 813.81'
E. = 51.91'
R. = 1637.02'

P.I. = 334+44.35
I. = 161°-48'
Δ = 18°-12'
D = 3°-30'
T. = 262.21'
L. = 520.00'
E. = 20.87'
R. = 1637.02'

P.T. 311+56.73
P.C. 331+82.14
P.T. 329+48.31
P.C. 321+34.50
P.I. 306+40
P.I. 307+40.00
P.I. 325+50.00
P.I. 334+44.35
P.I. 325+59
P.I. 320+97
P.I. 321+32
P.I. 325+49
P.I. 306+79
P.I. 2"J"+58
5"J"+00 334+45
3.3°+50

S 89° 46' E 330
N 62° 44' E
N 73° 08' E
N 2° 30' W

SLOPE INTERCEPTS

C.T.H. "B"

(45) DOUGLAS A. STEINBACH
111.2 AC. TOTAL
108.7 AC. REM.

(41) PLATTEVILLE TELEPHONE CO.

NW – SE

NE – SE

TOWN ROAD

19.9° 90E
2050 TO TANG.

T 3 N
R 2 W
11 12
14

T 3 N
R 2 W
11 12
2

REVISION DATE		PROJECT I.D. 5945-1-00	SHEET NUMBER	TOTAL SHEETS
8/24/72		FEDERAL PROJECT DESIGNATION	4.14	
11/16/72				

PLAT OF RIGHT OF WAY REQUIRED

C.T.H."B" GRANT COUNTY

SCALE 0 100 200Ft.

DATE JUNE 7, 1972

Const. Project

NOTE:
BEARINGS SHOWN ON THIS PLAT ARE THE TRUE BEARINGS OF EACH TANGENT TO THE NEAREST MINUTE

NW – NW

NE – NW

SW – NW

SE – NW

NW – SW

NE – SW

TOWN OF HARRISON

P.I. = 6"L"+44.4
I. = 204° 04'
Δ = 24° 04'
D. = 12° 00'
T. = 101.8'
L. = 200.6'
E. = 10.7'
R. = 477.5'

P.I. = 334 + 44.35
I. = 161° – 48'
Δ = 18° – 12'
D. = 3° – 30'
T. = 262.21'
L. = 520.00'
E. = 20.87'
R. = 1637.02'

(46) LESTER A. WEINBERGEN, ET AL VENDOR
NICHOLAS F. BRUNTON, VENDEE
FOR AC. SEE SHEET 4.13

(49) CHRIS W. HEER, ET AL
280.3 AC. TOTAL
273.2 AC. REM.

(41) PLATTEVILLE TELEPHONE CO.

L.H.E. FOR DRAIN
0.3 AC. TEMP.

WHIG BR.

P.I. 6"L"+44.4

P.I. 361+45.45

P.T. 7"L"+43.2

P.C. 5"L"+42.6

5"L"+00 = 362+00

5"K"+00 = 348+32

(40) GRANT ELECTRIC CO-OP

L.H.E. FOR DRAIN
0.2 AC. TEMP.

C.T.H. "B"

LONE PINE CHEESE AND PRODUCE CO.

CHEESE HOUSE

WELL

SLOPE INTERCEPTS

5"J"+00 = 334+43

P.C. 331+82.14

P.I. = 334+44.35

3"J"+50

3"K"+50

P.C. 354+32.83

(49) CHRIS W. HEER, ET AL

(47) ROBERT S. MCFALL
153 AC. TOTAL
150.8 AC. REM.

TOWN ROAD

P.I. = 350 + 00.00
I. = 168° – 48' – 20"
Δ = 11° – 11' – 40"
D. = 2° – 00'
T. = 280.75'
L. = 559.72'
E. = 13.72'
R. = 2864.79'

P.I. = 361 + 45.45
I. = 207° – 54'
Δ = 27° – 54'
D. = 2° – 00'
T. = 711.62'
L. = 1395.00'
E. = 87.06'
R. = 2864.79'

T 13 N R 12 W

T 13 N R 12 W

Sta warped chart from 355-360
Sta warped long from 360-365 Accord of P.P.

REVISION DATE	
8/24/72	
11/16/72	

PROJECT I.D.	SHEET NUMBER	TOTAL SHEETS
5945-1-00	4.15	

FEDERAL PROJECT DESIGNATION

PLAT OF RIGHT OF WAY REQUIRED

C.T.H."B" GRANT COUNTY

SCALE 0 100 200 Ft.

DATE JUNE 7, 1972

Const. Project

NOTE:
BEARINGS SHOWN ON THIS PLAT ARE THE TRUE BEARINGS OF EACH TANGENT TO THE NEAREST MINUTE.

P.I. = 361+45.45
I. = 207°-54'
Δ = 27°-54'
D. = 2°-00'
T. = 711.62'
L. = 1395.00'
E. = 87.06'
R. = 2864.79'

P.I. = 6"L"+44.4
I. = 204° 04'
Δ = 24°04'
D. = 12° 00'
T. = 101.8'
L. = 200.6'
E. = 10.7'
R. = 477.5'

P.I. = 391+15.00
I. = 215°-29'
Δ = 35°-29'
D = 3°-30'
T = 523.75'
L = 1013.81'
E = 81.74'
R. = 1637.02'

N

TOWN OF HARRISON

NW-NE

NE-NE

SW-NE

SE-NE

C. W. HEER

(53) KENNETH OLSON
194.1 AC. TOTAL
187.6 AC. REM.

(49) CHRIS HEER ET AL
FOR AC. SEE SHEET 4.14

(51) DEXTER LEROY STEINBACH
132 AC. TOTAL
128.9 AC. REM.

(41) PLATTEVILLE TELEPHONE CO.

JT. SCHOOL DIST. NO. 1
TOWNS OF HARRISON,
ELLENBORO, LIMA AND
PLATTEVILLE

SCH.

TOWN ROAD

N 13°-25' W

P.T. 7"L"+43.2

362+80

122'

5"L"+42.6

P.I. 6"L"+44.4

P.I. 361+45.45

N 61° 52' E

N 13° 25' W

N 89° 47' E

C.T.H. "B"

P.L.

P.L. 362+59

P.L. 372+42

P.L. 377+66

P.I. 391+15.00

5"M"

1"M"+50

307+36

0"M"+00
=389+06

389+19

P.C. 385+91.25

P.L. 389+06

395' TO TANGENT

SLOPE INTERCEPTS

L.H.E.

C.T.H. SLOPE

C.T.H. TEMP.

TRAILER

H.H.G. BR.

5"L"+00
=362+00

365+00

367+92

369+28.83

373+00

380+50

382+50

385+00

390

T 13 N
R 12 W
12

T 13 N
R 12 W
7

REVISION DATE		PROJECT I.D. 5945-1-00	SHEET NUMBER	TOTAL SHEETS
8/24/72		FEDERAL PROJECT DESIGNATION	4.16	
11/16/72				

PLAT OF RIGHT OF WAY REQUIRED
C.T.H. "B" GRANT COUNTY

SCALE 0 100 200Ft.

DATE JUNE 7, 1972

Const. Project

NOTE:
BEARINGS SHOWN ON THIS PLAT ARE THE TRUE BEARINGS OF EACH TANGENT TO THE NEAREST MINUTE.

P.I. = 391 + 15.00
I. = 215° - 29'
Δ. = 35° - 29'
D. = 3° - 30'
T. = 523.75'
L. = 1013.81'
E. = 81.74'
R. = 1637.02'

P.I. = 404 + 27.80
I. = 167° - 17'
Δ. = 12° - 43'
D. = 2° - 00'
T. = 319.23'
L. = 635.83'
E. = 17.73'
R. = 2864.79'

P.I. = 423 + 77.00
I. = 169° - 40' - 40"
Δ. = 10° - 19' - 20"
D. = 1° - 00'
T. = 517.51'
L. = 1032.22'
E. = 23.32'
R. = 5729.58'

TOWN OF PLATTEVILLE

NW - NW | NE - NW | SW - NW | SE - NW | NW - SW | NE - SW

1"M" + 50
0"M" + 00 = 389 + 06
3"M"
66'
N 1° 12' W
TOWN RD.
P.I. 391 + 15.00
RESERVOIR
H
B
211'
60'
50'
S.C.
N 89° 47' E
390
HOG HOUSE
66'
389 + 19
390 + 56
P.C. 385 + 91.25
P.I. 389 + 06
1195' TO TANGENT
50'
S 54° 43' E
C.T.H. "B"
400
P.T. 396 + 05.06
P.C. 401 + 08.57
401 + 94
SLOPE INTERCEPTS
401 + 08.57
55'
53
KENNETH OLSON
N
3"N" + 50
P.I. 404 + 27.80
40
GRANT ELECTRIC CO-OP
T 13 N R 2 W 12
P.L. 0"N" + 28
P.L. 0"N" + 09
P.L.
N 0° 01' E
10'
66
TOWN ROAD
NW - SW
41
PLATTEVILLE TELEPHONE CO.
5"N" + 00 = 403 + 44
P.C. 401 + 08.57
P.T. 407 + 44.40
404 + 94
50'
24.75
H
F
54
BEN C. CAMPBELL
1.7 AC. TOTAL
1.6 AC. REM.
407 + 32
P.I. 407 + 22
1P
410
S 67° 26' E
P.L.
50'
66'
55
RICHARD HUEHNE, VENDOR
JOHN W. HUEHNE, VENDEE
221.2 AC. TOTAL
219.6 AC. REM.
414 + 30
L.H.E. SLOPE
0.1 AC. TEMP.
50'
416 + 06
420
P.I.
T 13 N R 1 W 7
N 23° W
TOWN ROAD
P.C. 418 + 59.49
P.L. 1"R" + 06
P.I. 417 + 66
F

REVISION DATE		PROJECT I.D. 5945-1-00	SHEET NUMBER	TOTAL SHEETS
8/24/72		FEDERAL PROJECT DESIGNATION	4.17	
11/16/72				

PLAT OF RIGHT OF WAY REQUIRED


C.T.H."B" GRANT COUNTY

SCALE 0 100 200Ft.

DATE JUNE 7, 1972

Const. Project

NOTE:
BEARINGS SHOWN ON THIS PLAT ARE THE TRUE BEARINGS OF EACH TANGENT TO THE NEAREST MINUTE.

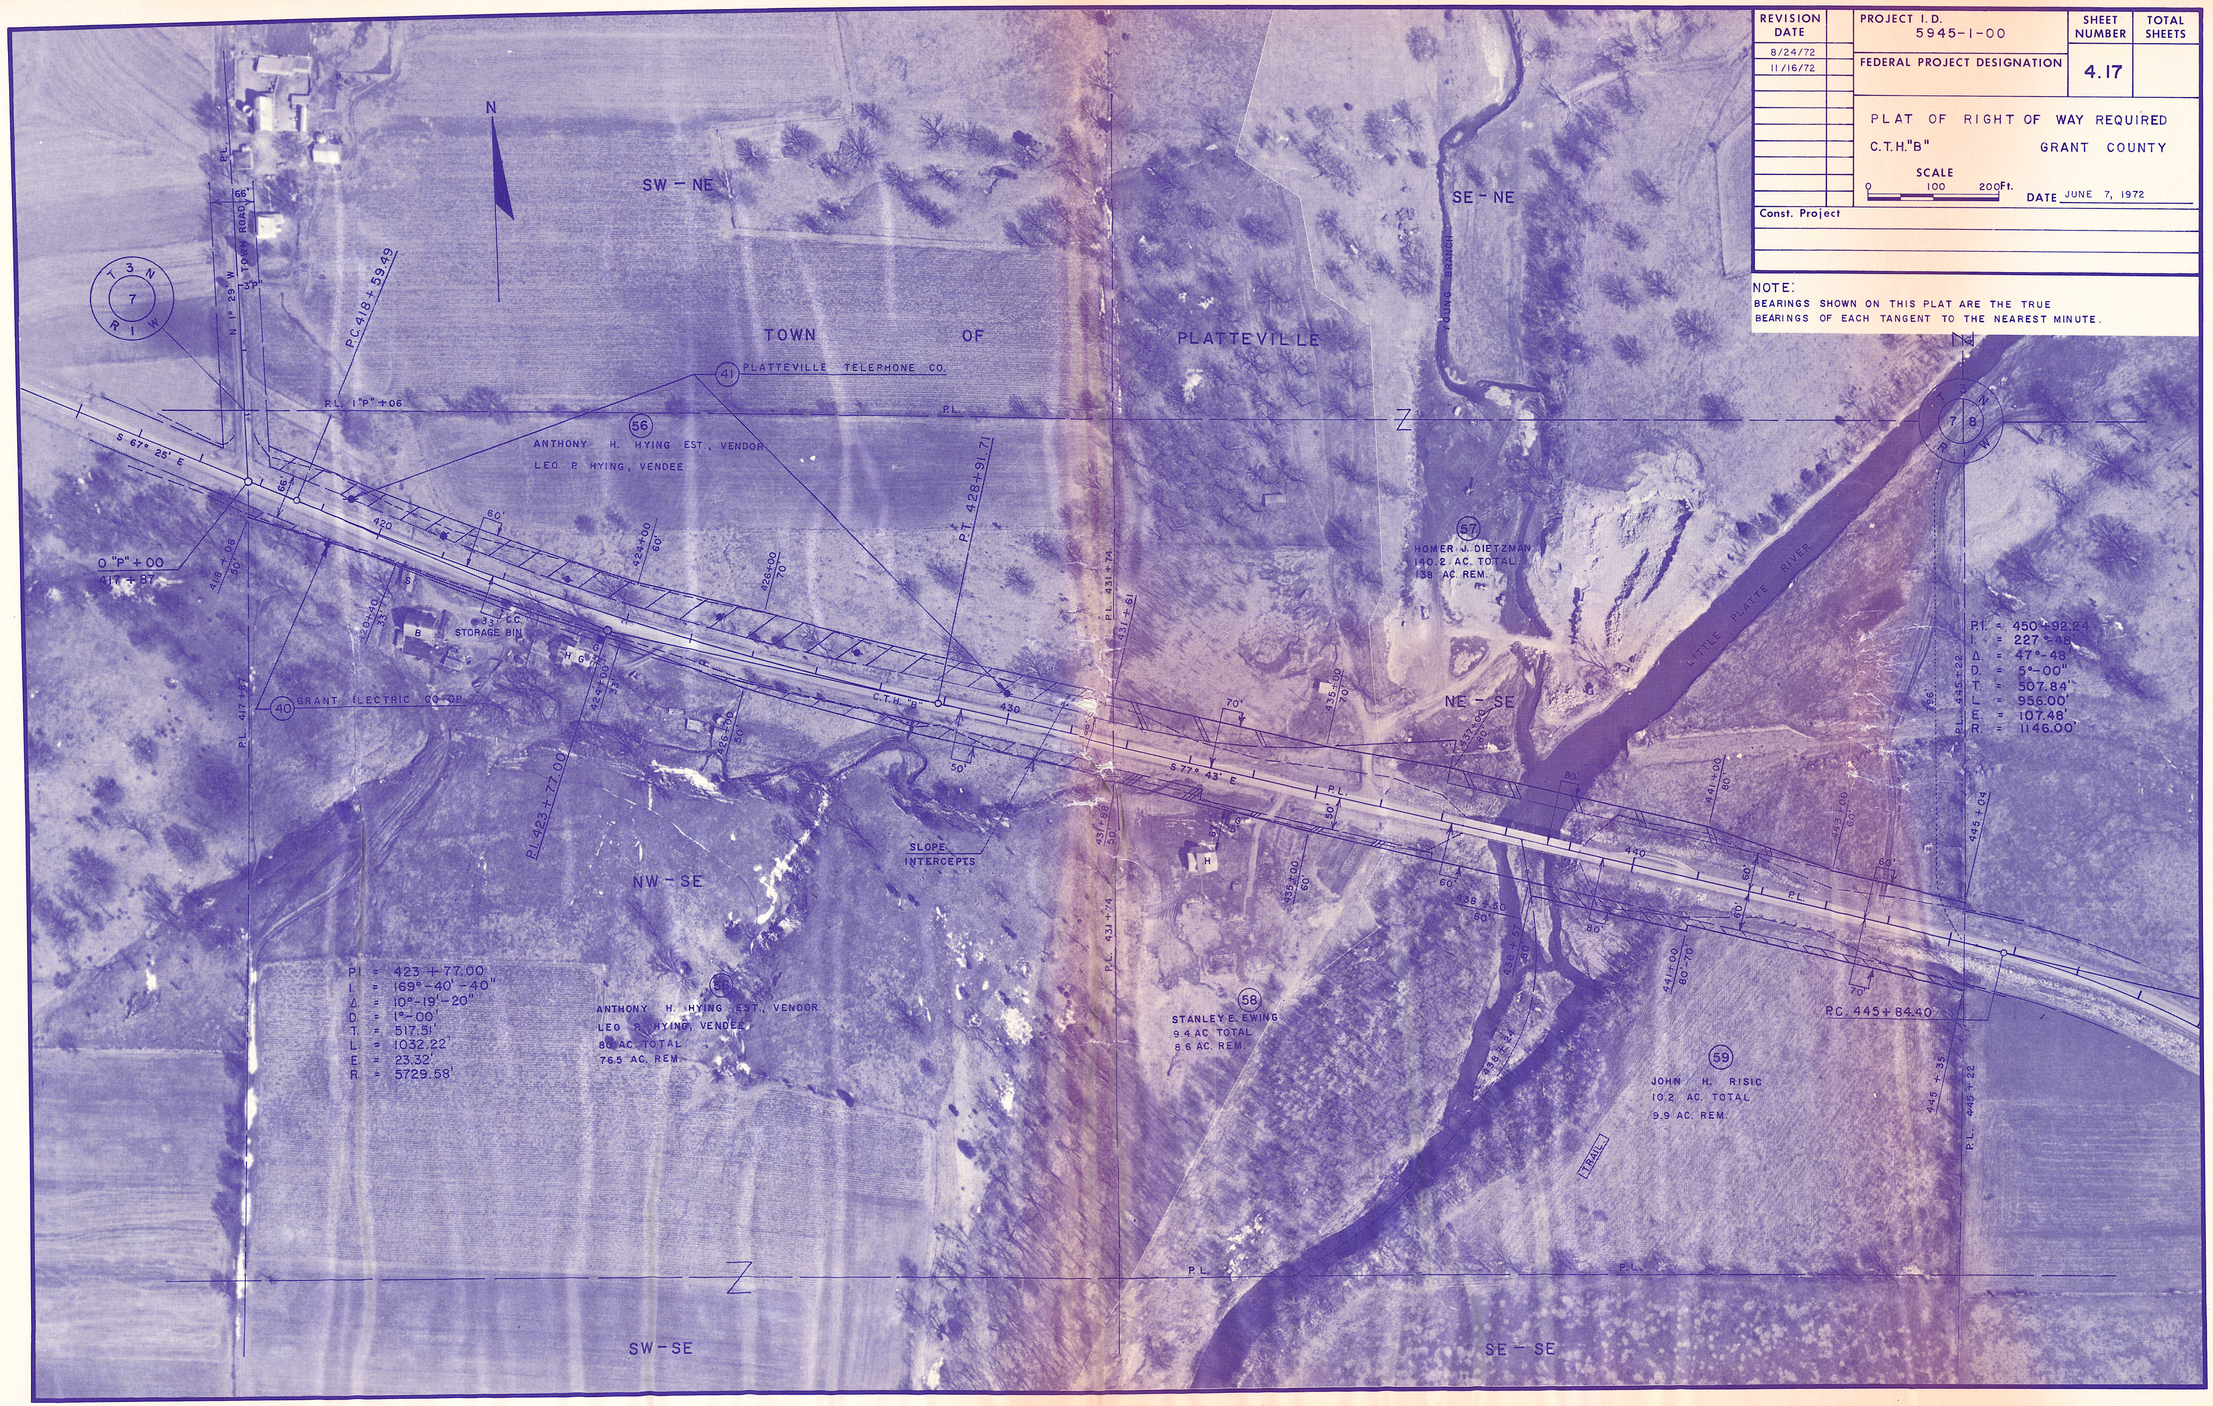

REVISION DATE		PROJECT I.D. 5945-1-00	SHEET NUMBER	TOTAL SHEETS
8/24/72		FEDERAL PROJECT DESIGNATION	4.18	
11/16/72				

PLAT OF RIGHT OF WAY REQUIRED

C.T.H."B" GRANT COUNTY

SCALE 0 100 200Ft.

DATE JUNE 7, 1972

Const. Project

NOTE:
BEARINGS SHOWN ON THIS PLAT ARE THE TRUE BEARINGS OF EACH TANGENT TO THE NEAREST MINUTE.

NW-SW

S 77° 43' E

P.I. 445+04

445

60'

70'

P.I. 450+92.24

P.I. = 450+92.24
I. = 227°-48'
Δ. = 47°-48
D. = 5°-00'
T. = 507.84'
L. = 956.00'
E. = 107.48'
R. = 1146.00'

SLOPE INTERCEPTS

445+35

P.C. 445+84.40

448+00 70'

450

451+00 60'

454+00 60'

454+96 51.6'

50'

60'

8'

P.L. 445+22

P.L. 454+66

454+23 60'

455+40.4 50'

P.T. 455+40.40

50'

66'

460

S 25° 55' E

TOWN OF PLATTEVILLE

N

Z

61

ERVIN JOHNSON
106.5 AC. TOTAL
103.2 AC. REM.

61

ERVIN JOHNSON

62

DONALD N. MILES
51 AC. TOTAL
45.9 AC. REM.

SW-SW

1851'

P.L.

P.L.

P.L.

REVISION DATE		PROJECT I. D.	SHEET NUMBER	TOTAL SHEETS
8/24/72		5945-1-00		
11/16/72		FEDERAL PROJECT DESIGNATION	4.19	

PLAT OF RIGHT OF WAY REQUIRED

C.T.H."B" GRANT COUNTY

SCALE 0 100 200Ft.

DATE JUNE 7, 1972

Const. Project

NOTE:
BEARINGS SHOWN ON THIS PLAT ARE THE TRUE BEARINGS OF EACH TANGENT TO THE NEAREST MINUTE.

(61) ERVIN JOHNSEN

LOREN A. GIPP

T 3 N R 1 W 8 17

SW - SE

TOWN OF PLATTEVILLE

SE - SE

N

P.I. = 490 + 40.00
I. = 128°-17'-20"
Δ. = 51°-42'-40"
D. = 5°-00'
T. = 555.33'
L. = 1034.22'
E. = 127.47'
R. = 1145.92'

P.I. = 478+10.41
P.L. 479+82
P.L. 480+82
479 + 23
100'
160
112'
P.L.
P.L.
P.L.

REVISION DATE
8/24/72
11/16/72

PROJECT I.D. 5945-1-00

FEDERAL PROJECT DESIGNATION 4

PLAT OF RIGHT OF WAY RE

C.T.H. "B" GRANT C

SCALE 0 100 200Ft.

DATE JUNE

Const. Project

NOTE:
BEARINGS SHOWN ON THIS PLAT ARE THE TRUE BEARINGS OF EACH TANGENT TO THE NEAREST MINUTE.

SW – SW

SE – SW

NW – NW

NE – NW

TOWN OF PLATTEVILLE

LITTLE PLATTE RIVER

T 3 N R 1 W
8 9 17 16

67

BLANCHE E. KARRMAN TRUST
4.8 AC. TOTAL
4.4 AC. REM.

CHARLES L. STEIDINGER

ELLIS L. WILLS

WILLIAM L. NIKOLAI

ROY E. SMITH

PAUL W. GAUGER

WILLIAM RECTOR

ALICE H. T. PENNEKAMP

JERRY C. HOOKS

FRED B. STARK

WM. F. STARK

BERNARD T. SCHUSTER

DAVID BURKHOLDER

66

REZA REZAZADEH
95.8 AC. TOTAL
93.7 AC. REM.

P.I. = 527 + 93.00
I. = 227° – 27'
Δ. = 47° – 27'

P.I. = 510 + 00.00
I. = 181° – 53' – 20"
Δ. = 1° – 53' – 20"
D. = 0° – 30'
T. = 188.92'
L. = 377.78'
E. = 1.55'
R. = 11,460'

END RELOCATION ORDER SO 205(5)
PROJECT I.D. 5945-1-00, STA. 511 + 88.86

C.T.H. "B"

WESTERN AVE.

PLATTEVILLE

UNION

W. HILL

CITY OF

TRAILER

P.C. 507 + 39

P.T. 511 + 88.86

P.L. 507 + 52

P.L. 511 + 65

P.L. 516 + 57

P.L. 522 + 99

P.L. 527 + 93.00

P.L. 529 + 82

P.L. 531 + 87

P.L. 536 + 19

N 79° 22' E

N 77° 27' E

S 53° 10' E

S 10° 15' W

50'

55'

66'

330'

664'

N

Z