

RELOCATION ORDER

BY COUNTY HIGHWAY COMMITTEE OF GRANT COUNTY, WISCONSIN

THE GRANT COUNTY HIGHWAY COMMITTEE FINDS AND DETERMINES THAT:

The proper establishing, laying out, widening, enlarging, extending, constructing, reconstructing, improving, or maintaining a portion of the highway now designated as County Trunk Highway "Q" from a point 11 feet south and 1021 feet east of the west quarter corner of Section 20, Township 6 North, Range 2 West, and extending northeasterly to a point 510 feet north and 1727 feet east of the southwest corner of Section 36, Township 7 North, Range 2 West, and on roads or lands in and about and along and leading to same, requires certain relocation or change and the acquisition of lands or interests in lands as shown on the map or copy therefor marked

PLAT OF RIGHT OF WAY REQUIRED, PROJECT S 0210(3), Fennimore-Castle Rock Road, C.T.H. "Q", GRANT COUNTY, dated May 12, 1958, the same being sheets Nos. 4.0-4.5 inclusive of the plans for said project, and

Pursuant to its authority under Section 83.08, Wisconsin Statutes,

THE GRANT COUNTY HIGHWAY COMMITTEE ORDERS THAT:

(1) The said highway is hereby laid out and established to the lines and width as shown on the said plat.

(2) The required lands and interests in lands as shown on the plat shall be acquired by the County Highway Committee, pursuant to the provisions of Section 83.08, Wisconsin Statutes.

(3)

The foregoing order was issued by the County Highway Committee and entered in the minutes of its meeting on May 19, 1958.

County Clerk's office

Grant County

Received for Record

24, 1958

Alvin Appule
County Clerk

W. B. Baird
Chas. A. Berlan
Earl Curtis
Grant County Highway Committee

Wal Petty
John Kelley

REVISED RELOCATION ORDER

BY COUNTY HIGHWAY COMMITTEE OF GRANT COUNTY, WISCONSIN

- - - -

THE GRANT COUNTY HIGHWAY COMMITTEE FINDS AND DETERMINES THAT:

The proper establishing, laying out, widening, enlarging, extending, constructing, reconstucting, improving, or maintaining a portion of the highway now designated as County Trunk Highway "Q" from a point 11 feet south and 1021 feet east of the west quarter corner of Section 20, Township 6 North, Range 2 West, and extending northeasterly to a point 510 feet north and 1727 feet east of the southwest corner of Section 36, Township 7 North, Range 2 West, and on roads or lands in and about and along and leading to same, requires certain relocation or change and the acquisition of lands or interests in lands as shown on the map or copy therefor marked

PLAT OF RIGHT OF WAY REQUIRED, PROJECT S 0210(3), Fennimore-Castle Rock Road, C.T.H. "Q", GRANT COUNTY, dated June 15, 1958, the same being sheets No. 4.0-4.5 inclusive of the plans for said project, and

Pursuant to its authority under Section 83.08, Wisconsin Statutes,

THE GRANT COUNTY HIGHWAY COMMITTEE ORDERS THAT:

- (1) The said highway is hereby laid out and established to the lines and width as shown on the said plat.
- (2) The required lands and interests in lands as shown on the plat shall be acquired by the County Highway Committee, pursuant to the provisions of Section 83.08, Wisconsin Statutes.
- (3) This order supercedes and amends the previous order issued by the Grant County Highway Committee on May 12, 1958.

The foregoing order was issued by the County Highway Committee and entered in the minutes of its meeting on July 12, 1958.

County Clerk's Office

Grant County

Received for Record June 30, 1958.
Alonso Appert
County Clerk

Chas. A. Becker
W. C. Bailey
Earl Curtis
Val Pety

Grant County Highway Committee

RELOCATION ORDER

by County Highway Committee of Grant County, Wisconsin

* * * * *

THE COUNTY HIGHWAY COMMITTEE FINDS AND DETERMINES THAT:

The proper establishing, laying out, widening, enlarging, extending, constructing, reconstructing, improving, or maintaining a portion of the highway now designated as County Trunk Highway "T" from a point

103 feet North of the Northwest Corner Section 34,

Township 7 North, Range 3 West, extending thence

Westerly to a point 4023.8 feet South and 3836.3 feet west of the

North Corner Section 30, Township 7 North, Range 3 West thereof.

"PLAT OF RIGHT OF WAY REQUIRED, PROJECT T-2 for the County Trunk Highway "T" located between U.S.H. #61 and C.T.H. "K", in Grant County, dated December 9, 1954, the same being sheets 1 to 8 inclusive, and

Pursuant to its authority under Section 83.08, Wisconsin Statutes.


THE COUNTY HIGHWAY COMMITTEE ORDERS THAT:

- (1) The said highway is hereby laid out and established to the lines and widths as shown on the said plat.
- (2) The required lands or interests in lands as shown on the plat shall be acquired by the County Highway Committee of the County in which the lands are situated, pursuant to the provision of Section 83.08, Wisconsin Statutes.

* * * * *

* * * * *

The foregoing order was issued by the County Highway Committee and entered in the minutes of its meeting on 12/9, 1954.

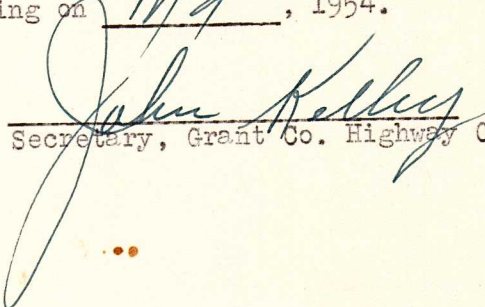
Secretary, Grant Co. Highway Comm.

RELOCATION ORDER

RE3006 LPA-8/97

Project 5957-00-01	Name of Road STH 81 - CTH N Road	Highway CTH U	County Grant
Right of Way Plat Date	Plat Sheet Numbers 4.1, 4.2, 4.3, 4.4, 4.5	Date of Previously Approved Relocation Order None	

Description of Termini of Project

Beginning at a point 339.02 feet north and 1546.68 feet west of the east 1/4 corner of Section 5, T3N, R4W, and continuing 1,062.09 feet along an arc of a curve concave to the north having a radius of 984.25 feet (the chord bears S55°58'17"E, 1011.32 feet); thence S86°53'06"E, 223.86 feet; thence 85.36 feet along the arc of a curve concave to the south having a radius of 984.25 feet (the chord bears S84°24'01"E, 85.33 feet); thence S81°54'57"E, 137.87 feet to a point 266.80 feet south and 263.59 feet west of the east 1/4 corner of Section 5 T3N, R4W, as shown on the plat of right-of-way or a copy thereof marked:

STH 81-CTH N Road
(Grant River Bridge and Approaches)
CTH U
Grant County

The same being Sheets 4.1, 4.2, 4.3, 4.4 and 4.5 of said plat.

To properly establish, lay out, widen, enlarge, extend, construct, reconstruct, improve, or maintain a portion of the highway designated above, it is necessary to relocate or change and acquire certain lands or interests in lands as shown on the right of way plat for the above project.

To effect this change, pursuant to authority granted under Sections 83.07 and 83.08, Wisconsin Statutes, Grant County orders that:

1. The said road is laid out and established to the lines and widths as shown on the plat.
2. The required lands or interests in lands as shown on the plat shall be acquired by Grant County.
3. This order supersedes and amends any previous order issued by Grant County.

Stanley W. Abing
(Commissioner)
(Title)

6/10/99
(Date)


(Title)

(Date)

(Title)

(Date)

COUNTY AND HIGHWAY	ROUTE AND SECTION	CLASS AND AGREEMENT		FEDERAL DIVISION OFFICE	SHEET NUMBER	TOTAL SHEETS
22.6	210.0	STATE	FEDERAL	4	4.2	

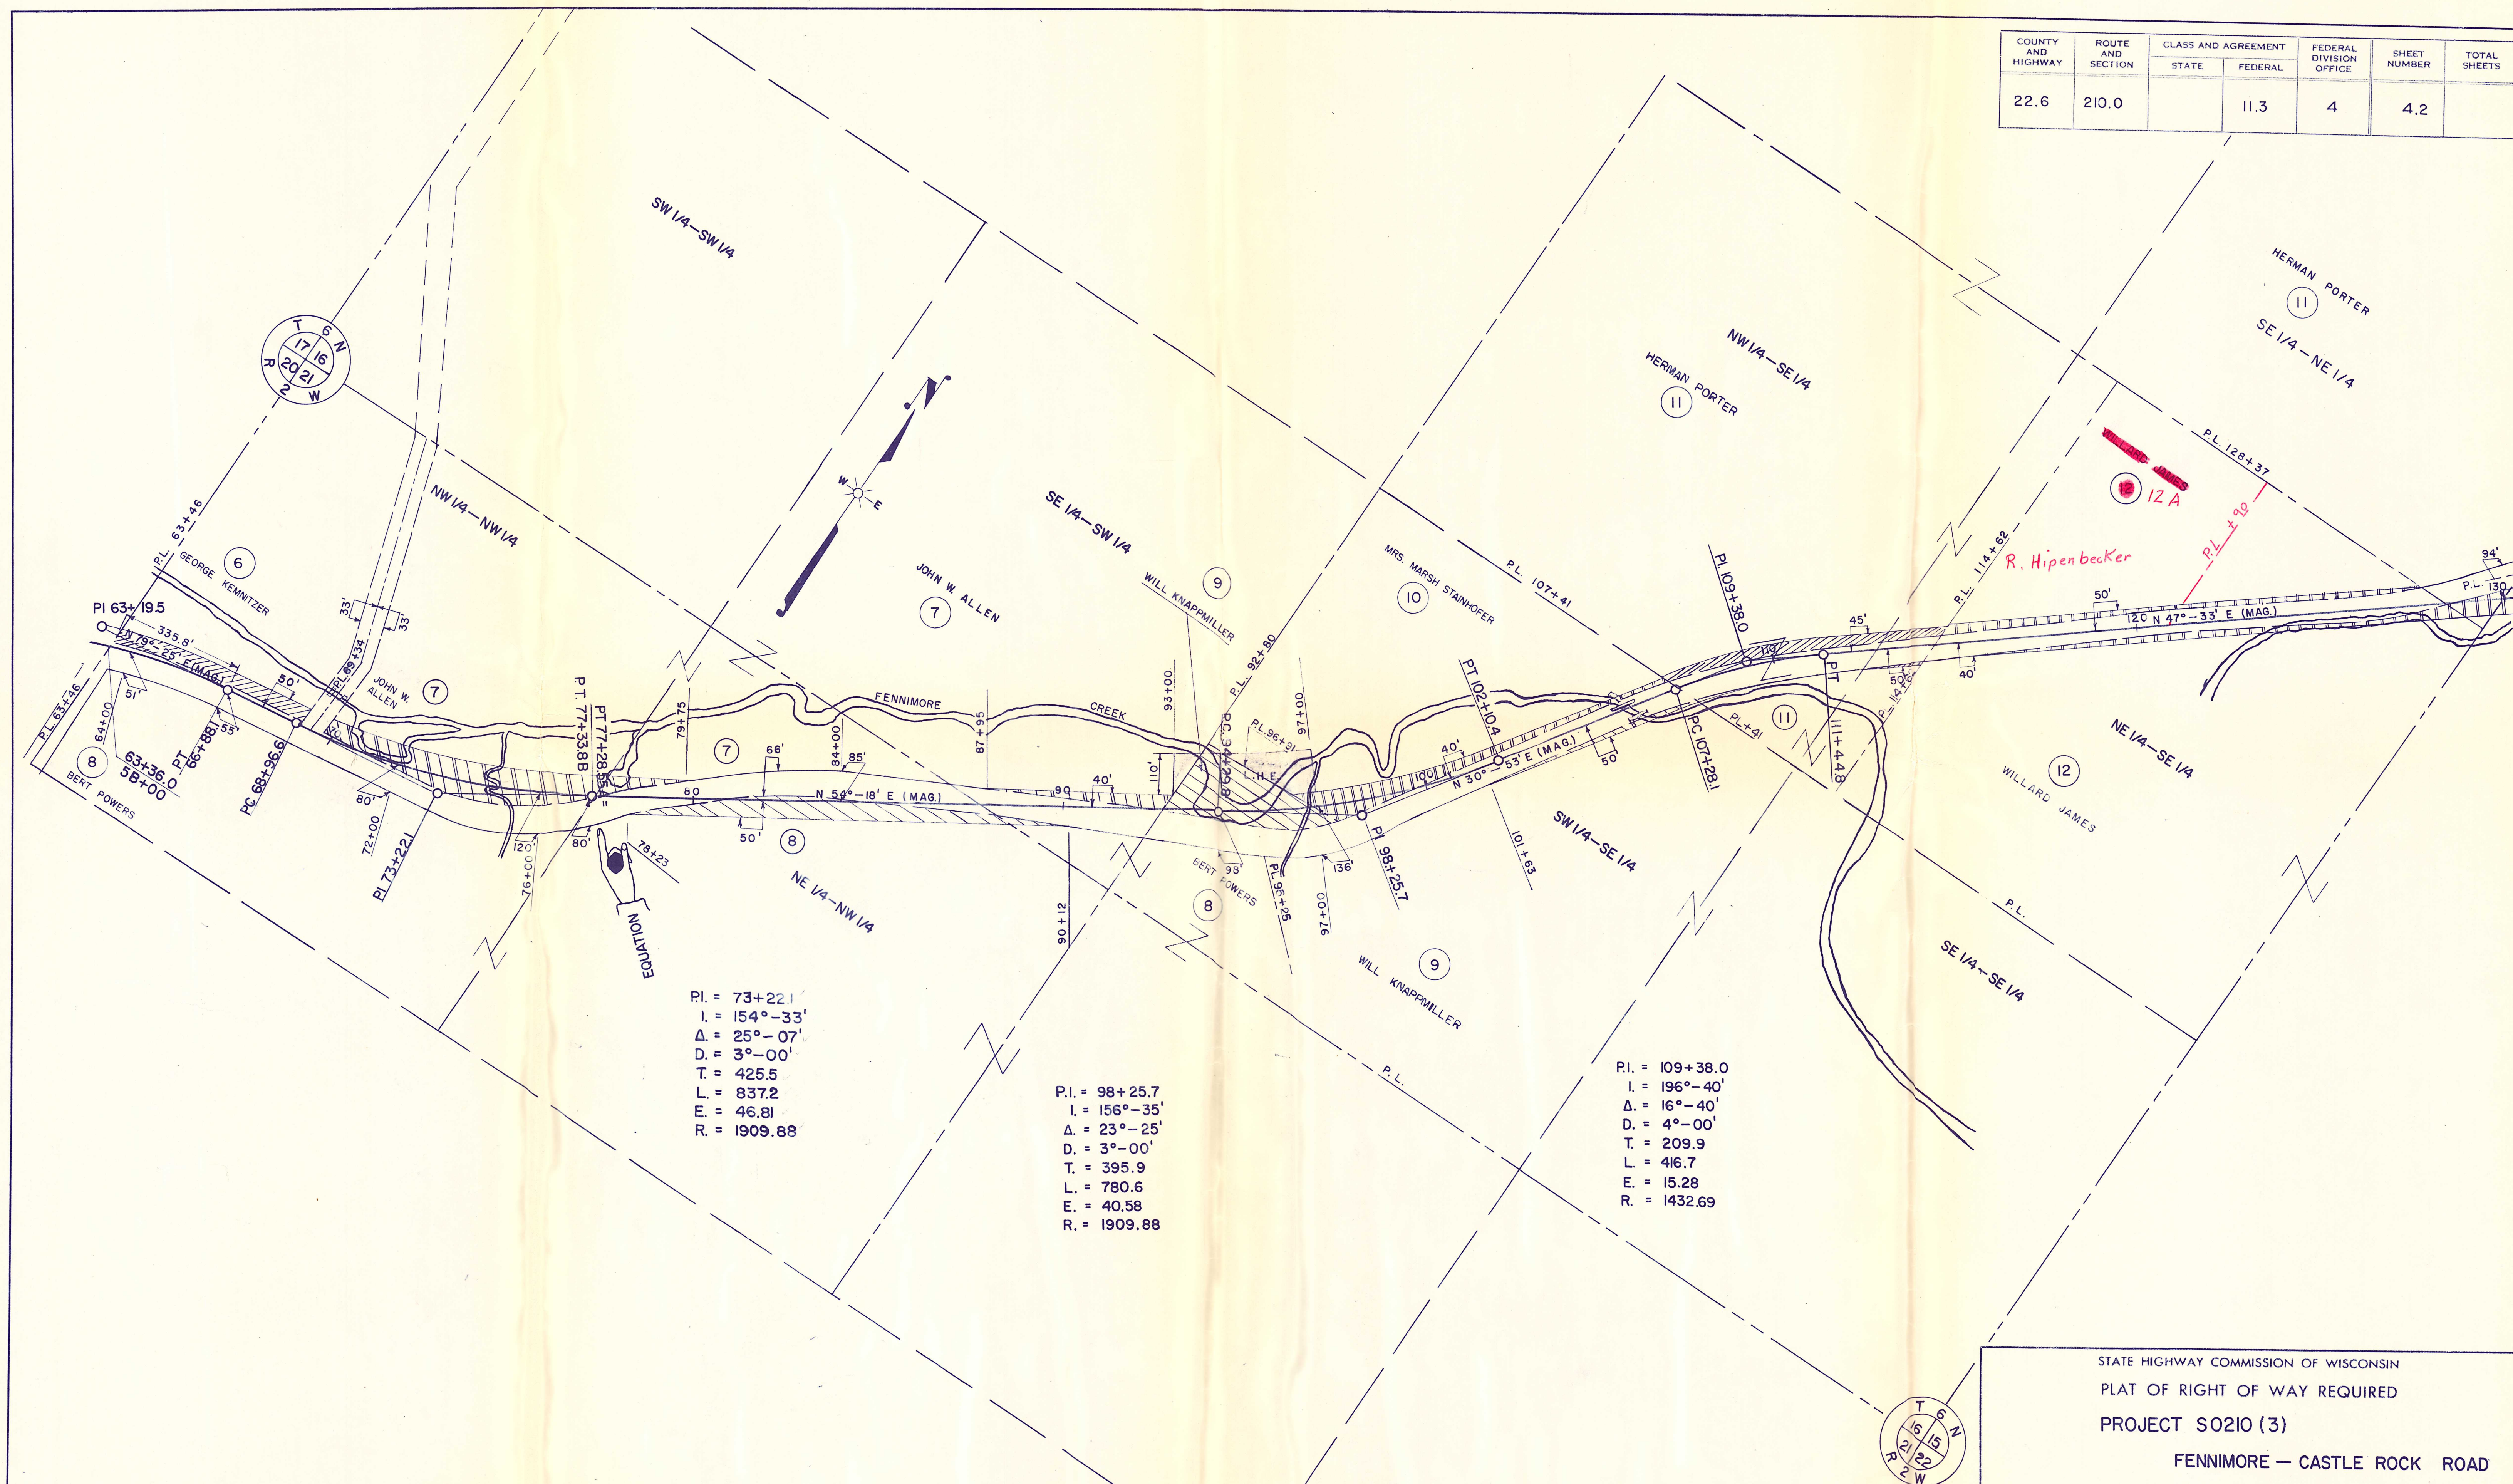

P.I. = 73+22.1
 I. = 154°-33'
 Δ = 25°-07'
 D. = 3°-00'
 T. = 425.5
 L. = 837.2
 E. = 46.81
 R. = 1909.88

P.I. = 98+25.7
 I. = 156°-35'
 Δ = 23°-25'
 D. = 3°-00'
 T. = 395.9
 L. = 780.6
 E. = 40.58
 R. = 1909.88

P.I. = 109+38.0
 I. = 196°-40'
 Δ = 16°-40'
 D. = 4°-00'
 T. = 209.9
 L. = 416.7
 E. = 15.28
 R. = 1432.69

STATE HIGHWAY COMMISSION OF WISCONSIN

PLAT OF RIGHT OF WAY REQUIRED

PROJECT S0210 (3)

FENNIMORE — CASTLE ROCK ROAD

C.T.H. "Q" GRANT COUNTY

SCALE


Revised June 15, 1958

0 200 400

LENGTH 5.94 MILES

DATED MAY 12, 1958

COUNTY AND HIGHWAY	ROUTE AND SECTION	CLASS AND AGREEMENT		FEDERAL DIVISION OFFICE	SHEET NUMBER	TOTAL SHEETS
22.6	210.0	STATE	FEDERAL	11.3	4	4.3

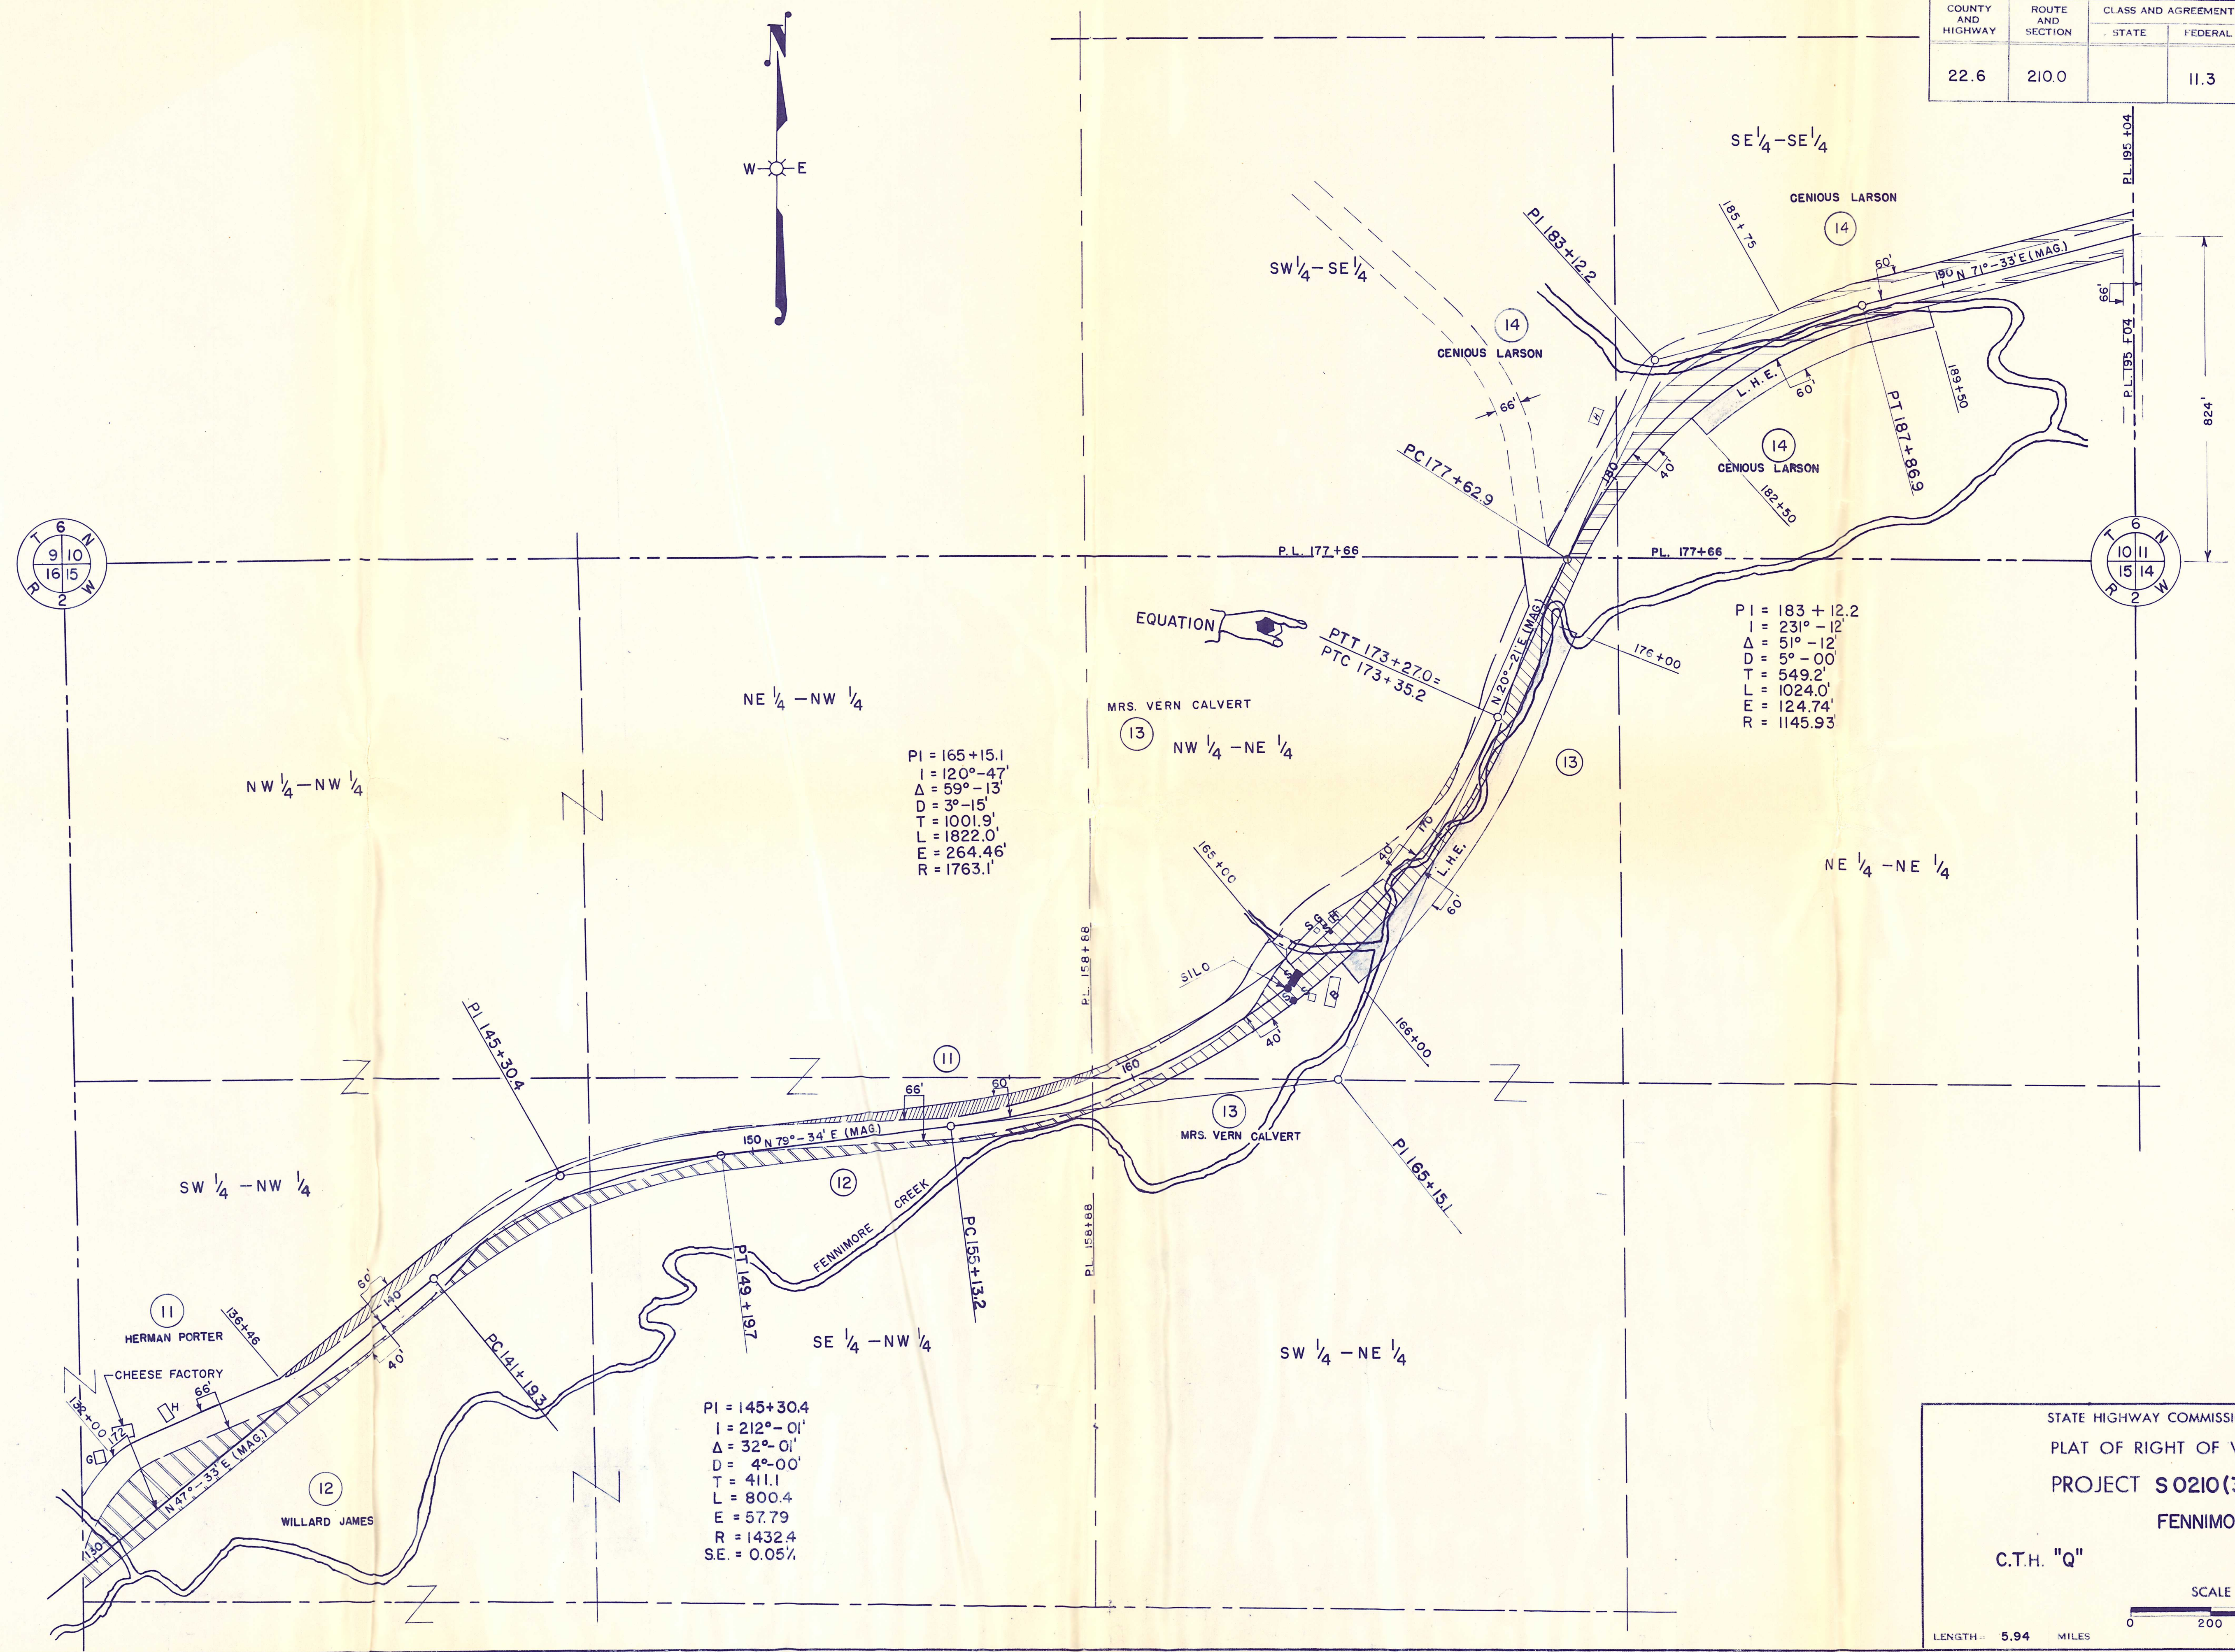

STATE HIGHWAY COMMISSION OF WISCONSIN
 PLAT OF RIGHT OF WAY REQUIRED
 PROJECT S0210(3)
 FENNIMORE—CASTLE ROCK ROAD
 C.T.H. "Q" GRANT COUNTY

SCALE 1" = 200' Revised June 15, 1958
 LENGTH 5.94 MILES DATED MAY 12, 1958

COUNTY AND HIGHWAY	ROUTE AND SECTION	CLASS AND AGREEMENT		FEDERAL DIVISION OFFICE	SHEET NUMBER	TOTAL SHEETS
		STATE	FEDERAL			
22.6	210.0		11.3	4	4.4	

P.I. = 209+20
 I. = 91°-50'
 Δ. = 88°-10'
 D. = 7°-00'
 T. = 793.3
 L. = 1259.5
 E. = 321.16
 R. = 818.52
 S.E. = 0.06'/FT.

P.I. = 230+85.15
 I. = 251°-31'
 Δ. = 71°-31'
 D. = 4°-30'
 T. = 917.2
 L. = 1589.25
 E. = 295.8
 R. = 1273.2

P.I. = 247+44.4
 I. = 147°-19'
 Δ. = 32°-41'
 D. = 5°-00'
 T. = 336.1
 L. = 653.7
 E. = 48.25
 R. = 1145.93

P.I. = 254+82.7
 I. = 211°-22'
 Δ. = 31°-22'
 D. = 5°-00'
 T. = 321.8
 L. = 627.3
 E. = 44.3
 R. = 1145.93




STATE HIGHWAY COMMISSION OF WISCONSIN
 PLAT OF RIGHT OF WAY REQUIRED
 PROJECT S0210 (3)
 FENNIMORE — CASTLE ROCK ROAD
 C.T.H. "Q"
 GRANT COUNTY

SCALE
 LENGTH 5.94 MILES
 0 200 400
 DATED MAY 12, 1958
 Revised June 15, 1958

COUNTY AND HIGHWAY	ROUTE AND SECTION	CLASS AND AGREEMENT		FEDERAL DIVISION OFFICE	SHEET NUMBER	TOTAL SHEETS
22.6	210.0	STATE	FEDERAL	11,3	4	4.5

END OF RELOCATION ORDER
 PROJ. S 0210(3), STA. 329+29.7=
 STA. 5+00, PROJ. S 0210(2)

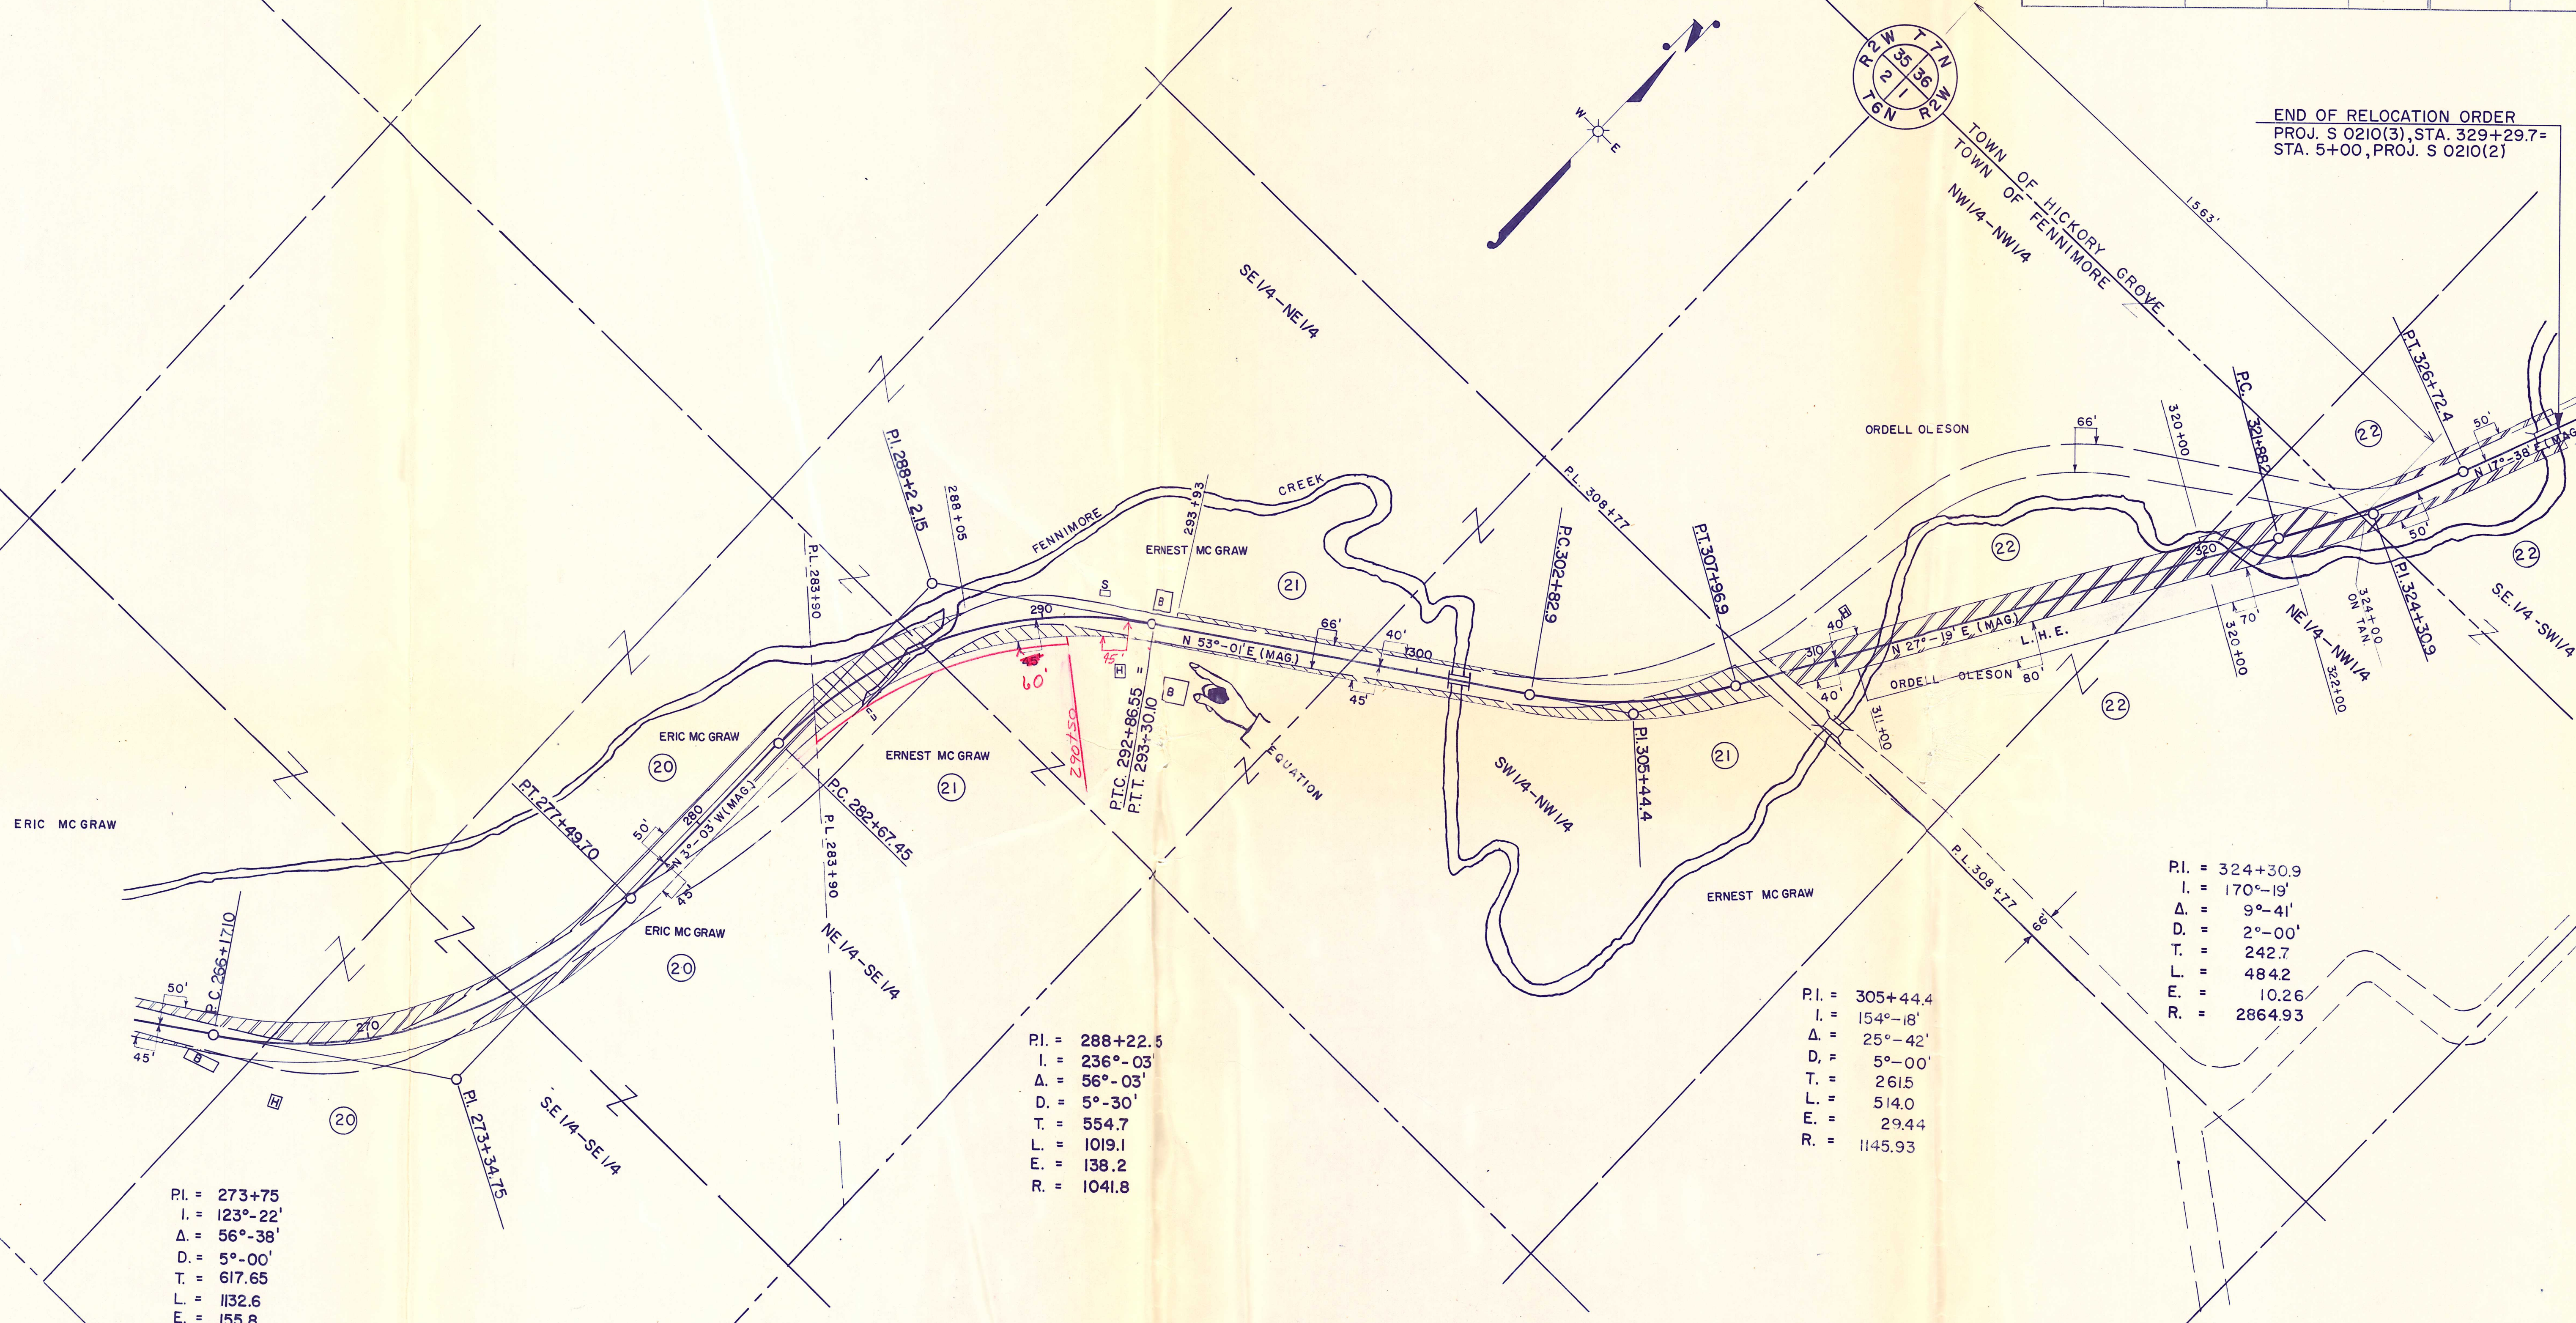

PI. = 273+75
 I. = 123°-22'
 Δ. = 56°-38'
 D. = 5°-00'
 T. = 617.65
 L. = 1132.6
 E. = 155.8
 R. = 1145.93

PI. = 288+22.5
 I. = 236°-03'
 Δ. = 56°-03'
 D. = 5°-30'
 T. = 554.7
 L. = 1019.1
 E. = 138.2
 R. = 1041.8

PI. = 305+44.4
 I. = 154°-18'
 Δ. = 25°-42'
 D. = 5°-00'
 T. = 261.5
 L. = 514.0
 E. = 29.44
 R. = 1145.93

PI. = 324+30.9
 I. = 170°-19'
 Δ. = 9°-41'
 D. = 2°-00'
 T. = 242.7
 L. = 484.2
 E. = 10.26
 R. = 2864.93

STATE HIGHWAY COMMISSION OF WISCONSIN
 PLAT OF RIGHT OF WAY REQUIRED
 PROJECT S 0210 (3)
 FENNIMORE-CASTLE ROCK ROAD
 C.T.H. "Q" GRANT COUNTY

SCALE Revised June 15, 1958
 LENGTH 5.94 MILES
 DATED MAY 15, 1958