

COUNTY AND HIGHWAY	ROUTE AND SECTION	CLASS AND AGREEMENT	FEDERAL DIVISION OFFICE	SHEET NUMBER	TOTAL SHEETS
22.6	210.0	STATE	FEDERAL	4	4

P.I. = 407+88.4
 I. = 239°40'
 Δ. = 59°40'
 D. = 6°00'
 T. = 547.9'
 L. = 994.4'
 E. = 154.9'
 R. = 955.37'

P.I. = 389+33.2
 I. = 211°06'
 Δ. = 31°06'
 D. = 5°00'
 T. = 319.0'
 L. = 622.0'
 E. = 43.54'
 R. = 1145.93'

P.I. = 417+83.7
 I. = 98°37'
 Δ. = 81°23'
 D. = 11°00'
 T. = 448.6'
 L. = 739.9'
 E. = 166.0'
 R. = 520.9'

P.I. = 381+13.8
 I. = 152°06'
 Δ. = 27°54'
 D. = 5°00'
 T. = 284.8'
 L. = 558.0'
 E. = 34.8'
 R. = 1145.93'

P.I. = 363+69
 I. = 227°31'
 Δ. = 43°31'
 D. = 4°34'
 T. = 500.8'
 L. = 952.9'
 E. = 96.27'
 R. = 1253.83'

SCHEDULE OF LAND AND INTERESTS REQUIRED

PAR.	OWNER	INTERESTS REQUIRED	ACRES
1	THOMAS SWENSON	EASEMENT	2.95
2	ENOS JOHNSRUD	"	1.82
3	RUSSELL HANSON	"	0.40
4	THOMAS SWENSON	L.H.E. EASEMENT	2.40 *
5	KENNETH JOHNSRUD	EASEMENT	1.83
6	MRS. ANNIE HELGESON	"	0.08
7	WILLIAM CAMPBELL	"	0.09
8	JOHN KOHOUT	L.H.E. EASEMENT	1.56 *
9	ANTON HRUBES ET AL	L.H.E. EASEMENT	1.27 *
10	PROCHASKA, WENCEL	EASEMENT	6.16
11	FRANK PROCHASKA	"	1.63
12	ANTON HRUBES, ET AL JOSEPH	"	0.09
6 A	WILLIAM CAMPBELL		0.21
5 A	EMMA L. KOTRBA		0.08

* DOES NOT INCLUDE ACREAGE FOR L.H.E.

STATE HIGHWAY COMMISSION OF WISCONSIN

PLAT OF RIGHT OF WAY REQUIRED

PROJECT S 0210(4)

FENNIMORE - C.T.H. G ROAD

C.T.H. Q GRANT COUNTY

SCALE

LENGTH 0 200 400 FEET DATED JULY 14, 1958


LOCATION SKETCH

GRANT COUNTY
 MILES
 SCALE

BEGINNING OF RELOCATION ORDER PROJ. S 0210(4)
 STA. 364+68.2 - STA. P.T.C. 40+43 PROJ. S 0210(2)

END OF RELOCATION ORDER PROJ. S 0210(4)
 STA. 538+73.1

BEGINNING OF RELOCATION ORDER PROJ. S 0210(4)
 STA. 364+68.2 - STA. P.T.C. 40+43 PROJ. S 0210(2)

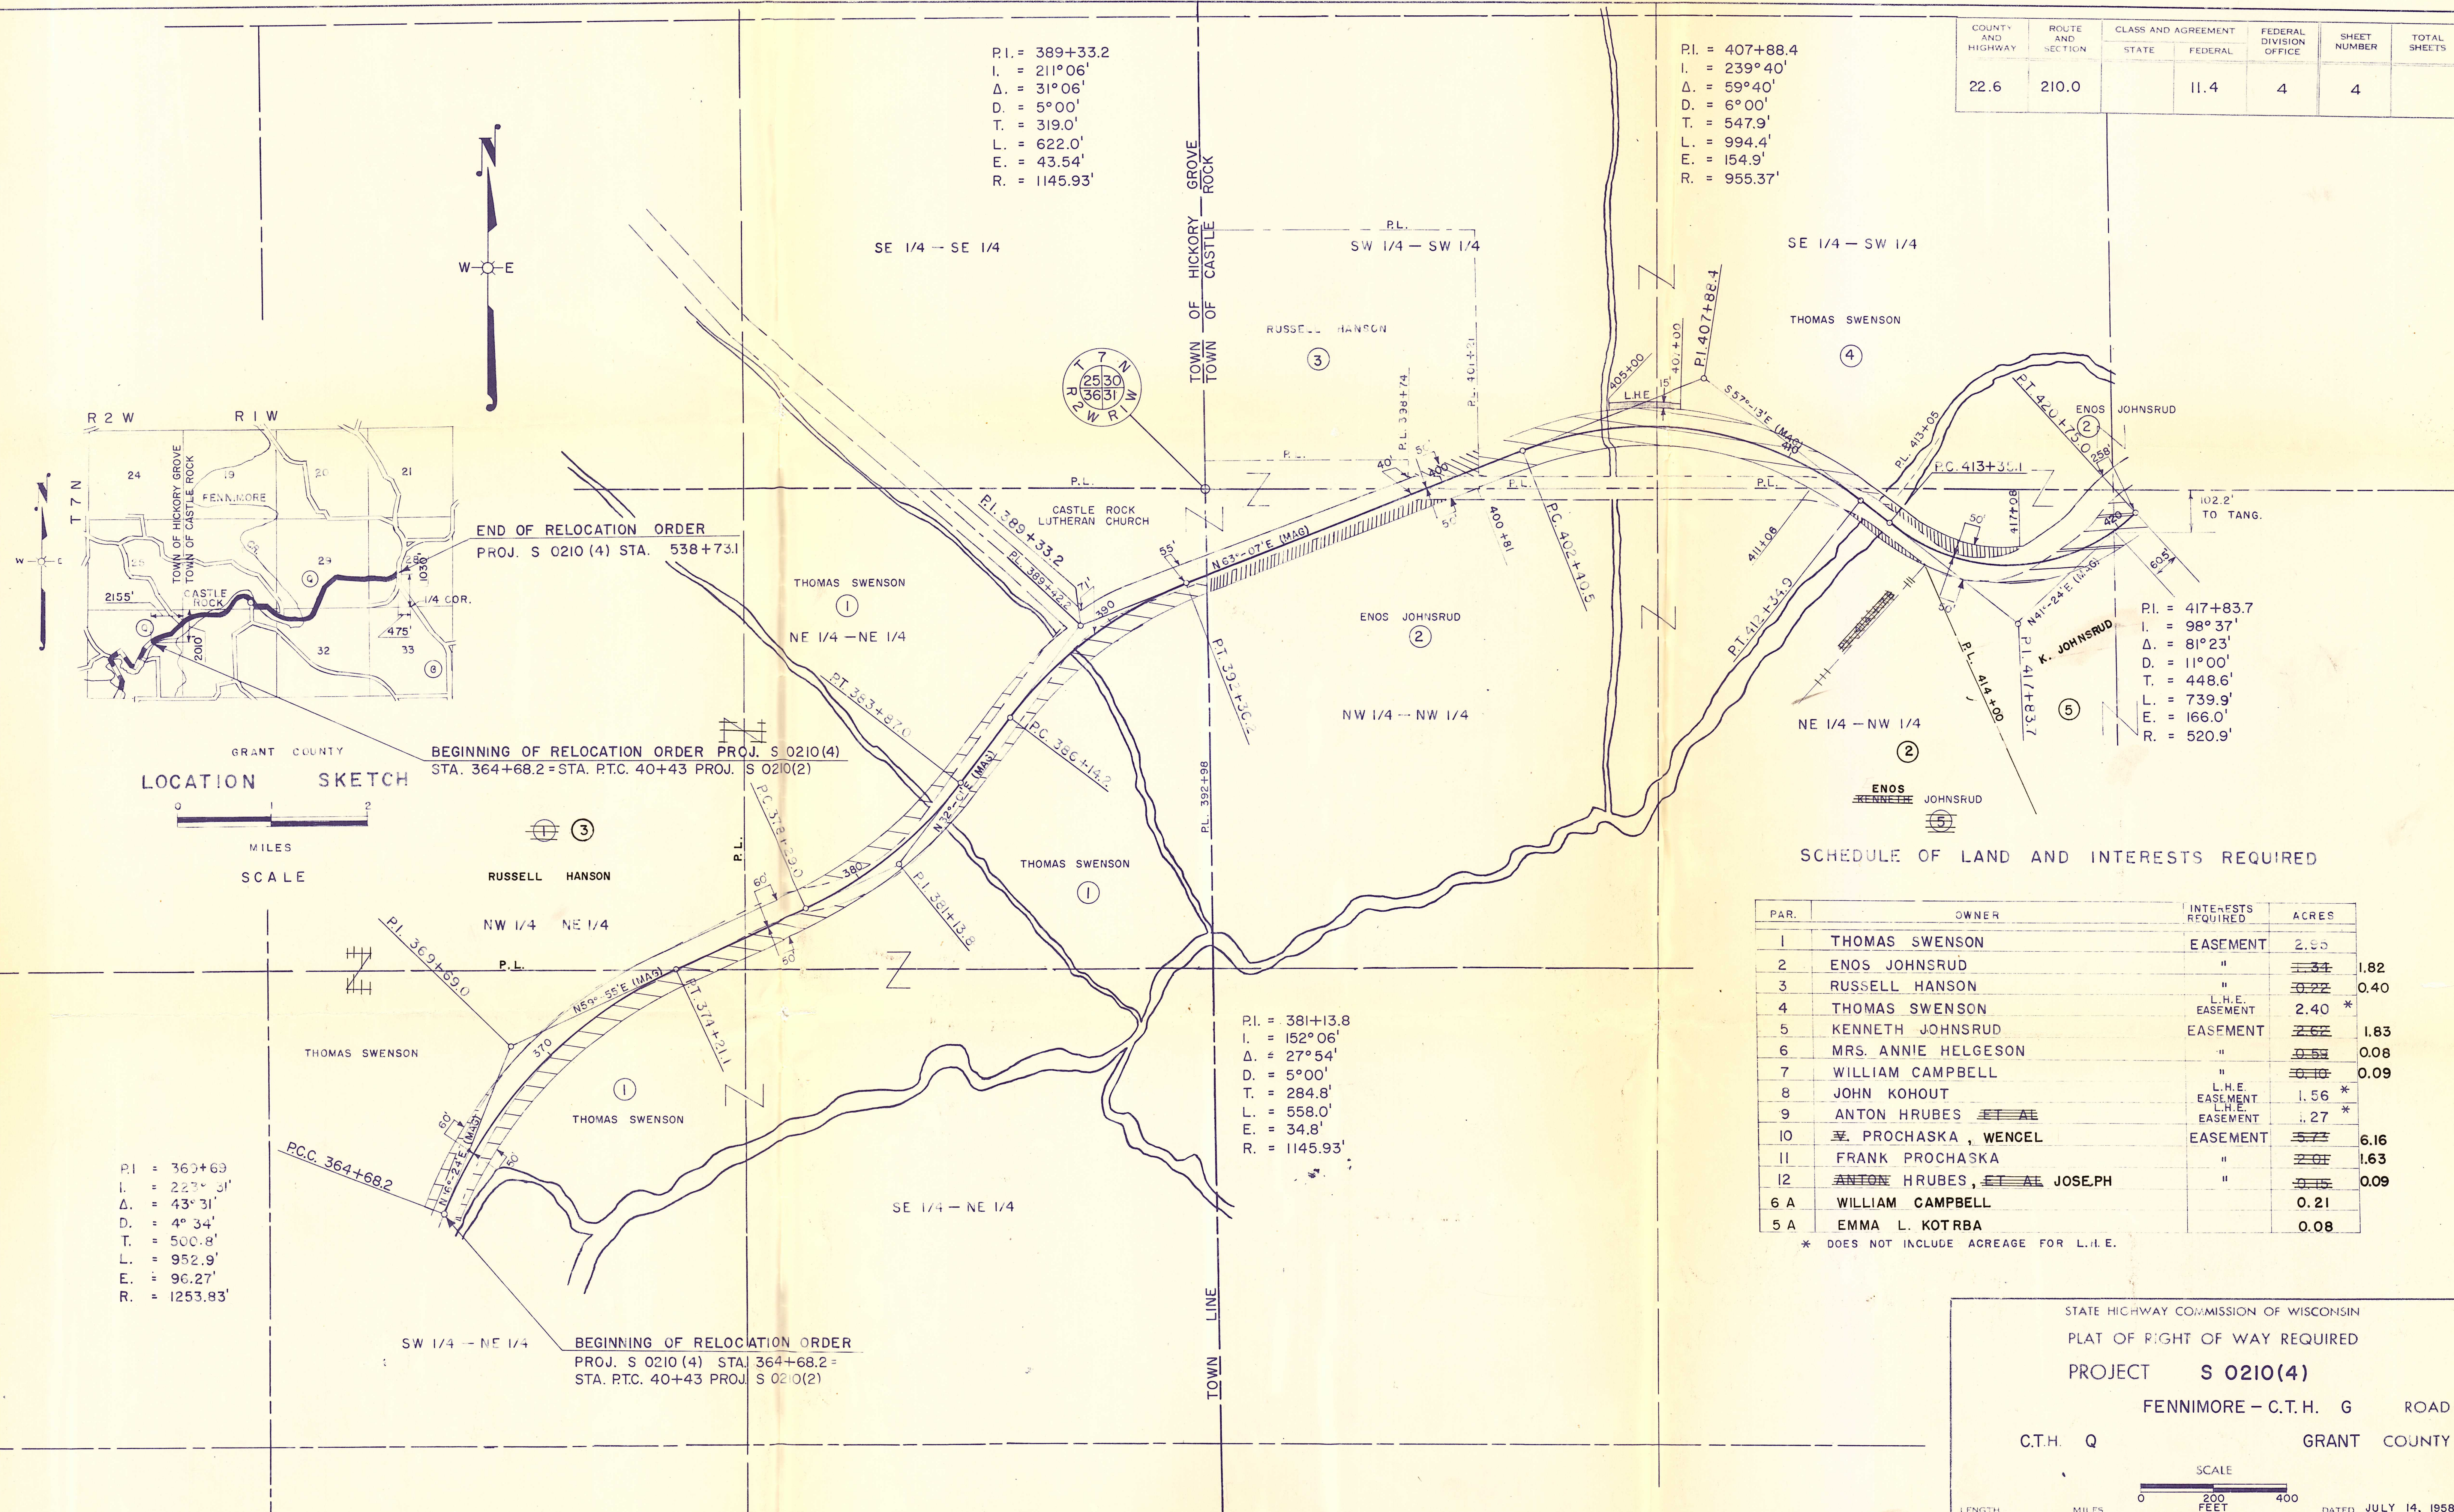


COUNTY AND HIGHWAY	ROUTE AND SECTION	CLASS AND AGREEMENT		FEDERAL DIVISION OFFICE	SHEET NUMBER	TOTAL SHEETS
22.6	210.0	STATE	FEDERAL	11.4	4	4.1

P.I. = 443+50.4
 I. = 310°-55'
 Δ = 130°-55'
 D. = 14°-00'
 T. = 898.5'
 L. = 933.1'
 E. = 577.5'
 R. = 410.28'
 S.E. = 0.06'/FT.

P.I. = 449+43.25
 I. = 119°-18'
 Δ = 60°-42'
 D. = 12°-00'
 T. = 280.1'
 L. = 505.8'
 E. = 75.83'
 R. = 478.34'
 S.E. = 0.06'/FT.

P.I. = 457+76.0
 I. = 133°-44'
 Δ = 46°-16'
 D. = 7°-00'
 T. = 349.9'
 L. = 661.0'
 E. = 71.57'
 R. = 818.72'
 S.E. = 0.06'/FT.

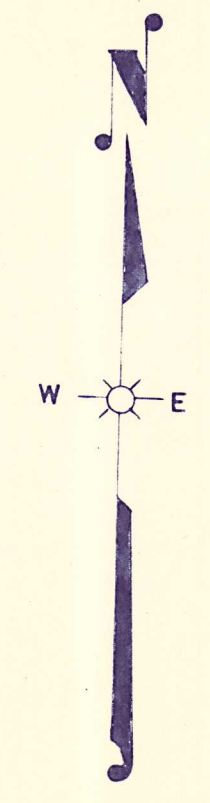

P.I. = 426+87.0
 I. = 165°-46'
 Δ = 14°-14'
 D. = 3°-00'
 T. = 238.5'
 L. = 474.4'
 E. = 14.9'
 R. = 1910.08'
 S.E. = 0.04'/FT.

P.I. = 469+93.8
 I. = 119°-31'
 Δ = 60°-29'
 D. = 5°-00'
 T. = 668.3'
 L. = 1209.6'
 E. = 180.5'
 R. = 1146.28'
 S.E. = 0.06'/FT.

P.I. = 450+02.7
 I. = 213°-45'
 Δ = 33°-45'
 D. = 11°-00'
 T. = 158.2'
 L. = 306.8'
 E. = 23.4'
 R. = 520.9'
 S.E. = 0.06'/FT.

STATE HIGHWAY COMMISSION OF WISCONSIN
 PLAT OF RIGHT OF WAY REQUIRED
 PROJECT S 0210 (4)
 FENNIMORE — C.T.H. G ROAD
 C.T.H. Q GRANT COUNTY

SCALE
 0 200 400
 FEET
 DATED


P.I. = 490+43.5
 I. = 247°-22'
 Δ. = 67°-22'
 D. = 7°-00'
 T. = 545.9'
 L. = 962.4'
 E. = 165.14'
 R. = 473.34'
 S.E. = 0.06'/FT.

P.I. = 510+26.2
 I. = 222°-13'
 Δ. = 42°-13'
 D. = 6°-00'
 T. = 368.8'
 L. = 703.6'
 E. = 68.69'
 R. = 955.37'
 S.E. = 0.06'/FT.

P.I. = 516+81.5
 I. = 153°-18'
 Δ. = 26°-41'
 D. = 7°-00'
 T. = 194.2'
 L. = 381.2'
 E. = 22.7'
 R. = 819.02'
 S.E. = 0.06'/FT.

P.I. = 525+13.5
 I. = 234°-27'
 Δ. = 54°-27'
 D. = 5°-30'
 T. = 536.2'
 L. = 990.0'
 E. = 12.98'
 R. = 1041.8'
 S.E. = 0.06'/FT.

COUNTY AND HIGHWAY	ROUTE AND SECTION	CLASS AND AGREEMENT		FEDERAL DIVISION OFFICE	SHEET NUMBER	TOTAL SHEETS
22.6	210.0	STATE	FEDERAL	11.4	4	4.2

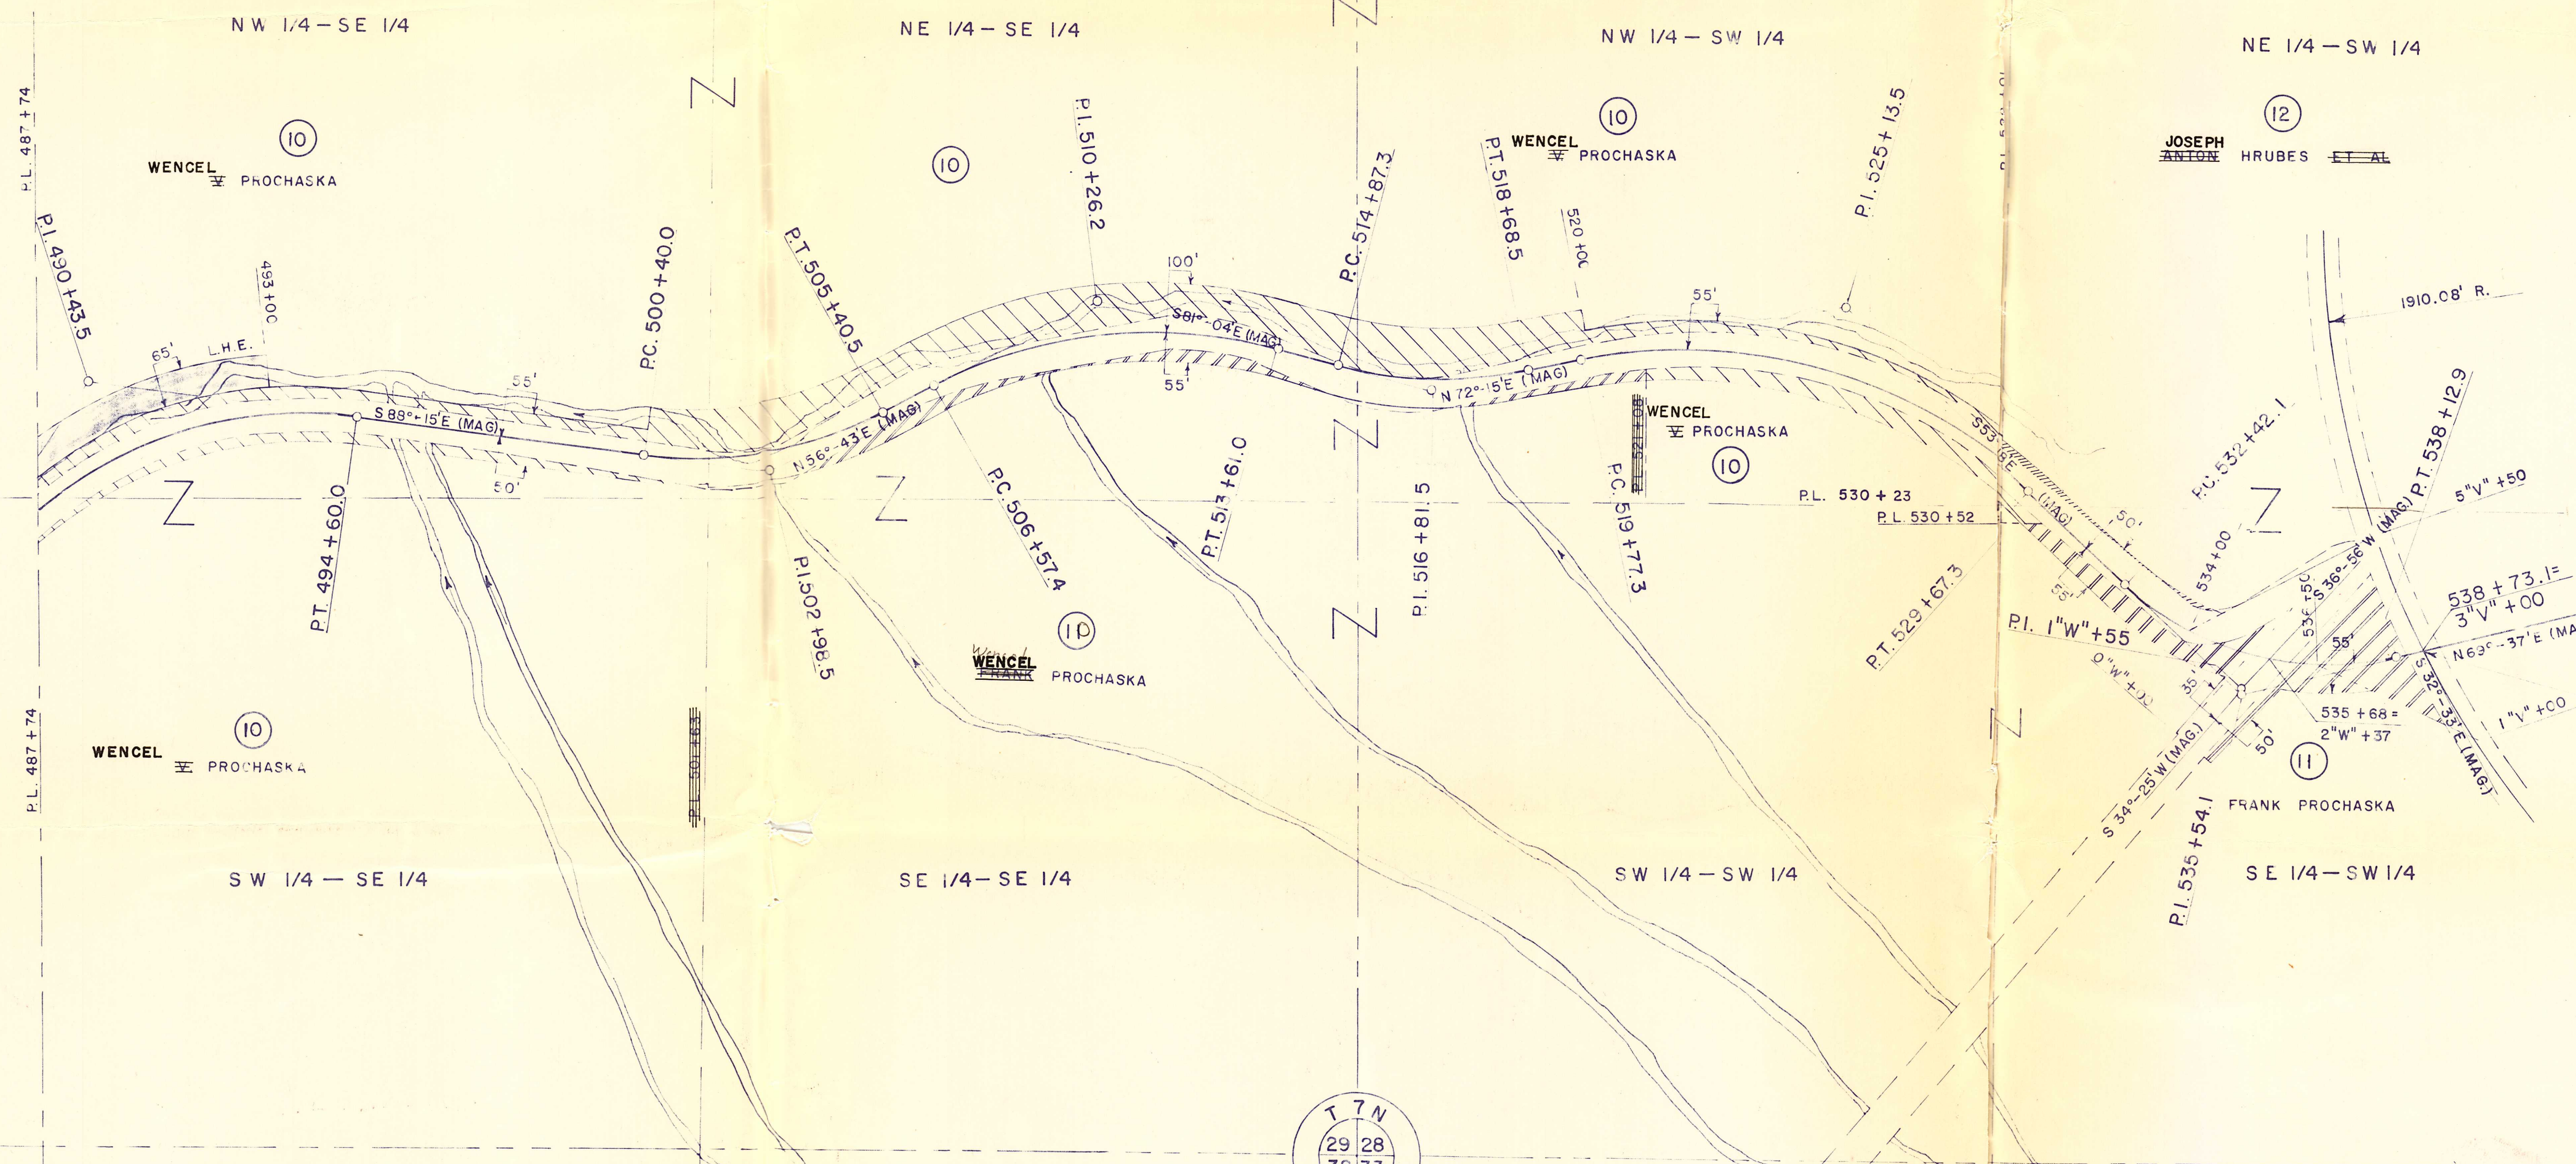

P.I. = 535+54.1
 I. = 122°-55'
 Δ. = 57°-05'
 D. = 10°-00'
 T. = 312.0'
 L. = 570.8'
 E. = 79.26'
 R. = 572.96'
 S.E. = 0.06'/FT.

END OF RELOCATION ORDER
 PROJ. S 0210 (4) STA. 538+73.1

P.I. = 502+98.5
 I. = 144°-58'
 Δ. = 35°-02'
 D. = 7°-00'
 T. = 258.5'
 L. = 500.5'
 E. = 39.81'
 R. = 819.02'
 S.E. = 0.06'/FT.

STATE HIGHWAY COMMISSION OF WISCONSIN
 PLAT OF RIGHT OF WAY REQUIRED
 PROJECT S 0210 (4)
 FENNIMORE — C.T.H. G ROAD
 C.T.H. Q GRANT COUNTY

SCALE
 0 200 400
 FEET

LENGTH MILES DATED