

REVISED RELOCATION ORDER

BY COUNTY HIGHWAY COMMITTEE OF GRANT COUNTY, WISCONSIN

THE GRANT COUNTY HIGHWAY COMMITTEE FINDS AND DETERMINES THAT:

The proper establishing, laying out, widening, enlarging, extending, reconstruction, improving, or maintaining a portion of the highway now designated as County Trunk Highway "S" from a point 1035 feet North and 368 feet East of the West Quarter corner of Section 16, Township 7 North, Range 2 West.,

Thence northwesterly to a point 418 feet West and 315 feet South of the Center of Section 36, Township 8 North, Range 3 West.

And on roads or lands in and about and along and leading to same, requires certain relocation or change and the acquisition of lands or interests in lands as shown on the map or copy therefor marked,

"PLAT OF RIGHT OF WAY REQUIRED, PROJECT S 0988 (1)," C. T. H. "T" ----- Boscobel Road, C. T. H. "S", Grant County, dated Jan. 8, 1961, the same being sheet No. 4 of the plans for the said project, and

Pursuant to its authority under Section 83.08, Wisconsin Statutes,

THE GRANT COUNTY HIGHWAY COMMITTEE ORDERS THAT:

- (1) The said highway is hereby laid out and established to the lines and width as shown on the said plat.
- (2) The required lands and interests in lands as shown on the plat shall be acquired by the County Highway Committee, pursuant to the provisions of Section 83.08, Wisconsin Statutes.
- (3) This order supercedes and amends the previous order issued by the Grant County Highway Committee on January 12, 1961.

The foregoing order was issued by the County Highway Committee and entered in the minutes of its meeting on May 11, 1961.

W. L. Baird

Earl Curtis

Wes Petty

Chas. G. Becker

John Keller

Grant County Highway Committee

RELOCATION ORDER

BY COUNTY HIGHWAY COMMITTEE OF GRANT COUNTY, WISCONSIN

THE GRANT COUNTY HIGHWAY COMMITTEE FINDS AND DETERMINES THAT:

The proper establishing, laying out, widening, enlarging, extending, reconstructing, improving, or maintaining a portion of the highway now designated as County Trunk Highway "M" and "S" from a point 1418 feet West and 315 feet South of the Center of Section 36 Township 8 North, Range 3 West.

Thence North westerly to a point 1075 feet West and 645 feet South of the North Quarter Corner of Section 35., Township 8 North, Range 3 West.

And on roads or lands in and about and along and leading to same, requires certain relocation or change and the acquisition of lands or interests in lands as shown on the map or copy therefor marked,

"PLAT OF RIGHT OF WAY REQUIRED, PROJECT S 1010 (1)," C. T. H. "T"----- Boscobel Road, C. T. H. "M" and "S", Grant County, dated March 8, 1960, the same being sheet No. 4 of the plans for the said project, and

Pursuant to its authority under Section 83.08, Wisconsin Statutes,

THE GRANT COUNTY HIGHWAY COMMITTEE ORDERS THAT:

- (1) The said highway is hereby laid out and established to the lines and width as shown on the said plat.
- (2) The required lands and interests in lands as shown on the plat shall be acquired by the County Highway Committee, pursuant to the provisions of Section 83.08, Wisconsin Statutes.


The foregoing order was issued by the County Highway Committee and entered in the minutes of its meeting on March 10, , 1960 .

W. L. Bailie
Earl Curtis


Val Petty
Chas. E. Becker

John Kelley
Grant County Highway Committee



COUNTY AND HIGHWAY	ROUTE AND SECTION	CLASS AND AGREEMENT		FEDERAL DIVISION OFFICE	SHEET NUMBER	TOTAL SHEETS
		STATE	FEDERAL			
22.6	988.0			4	4.1	

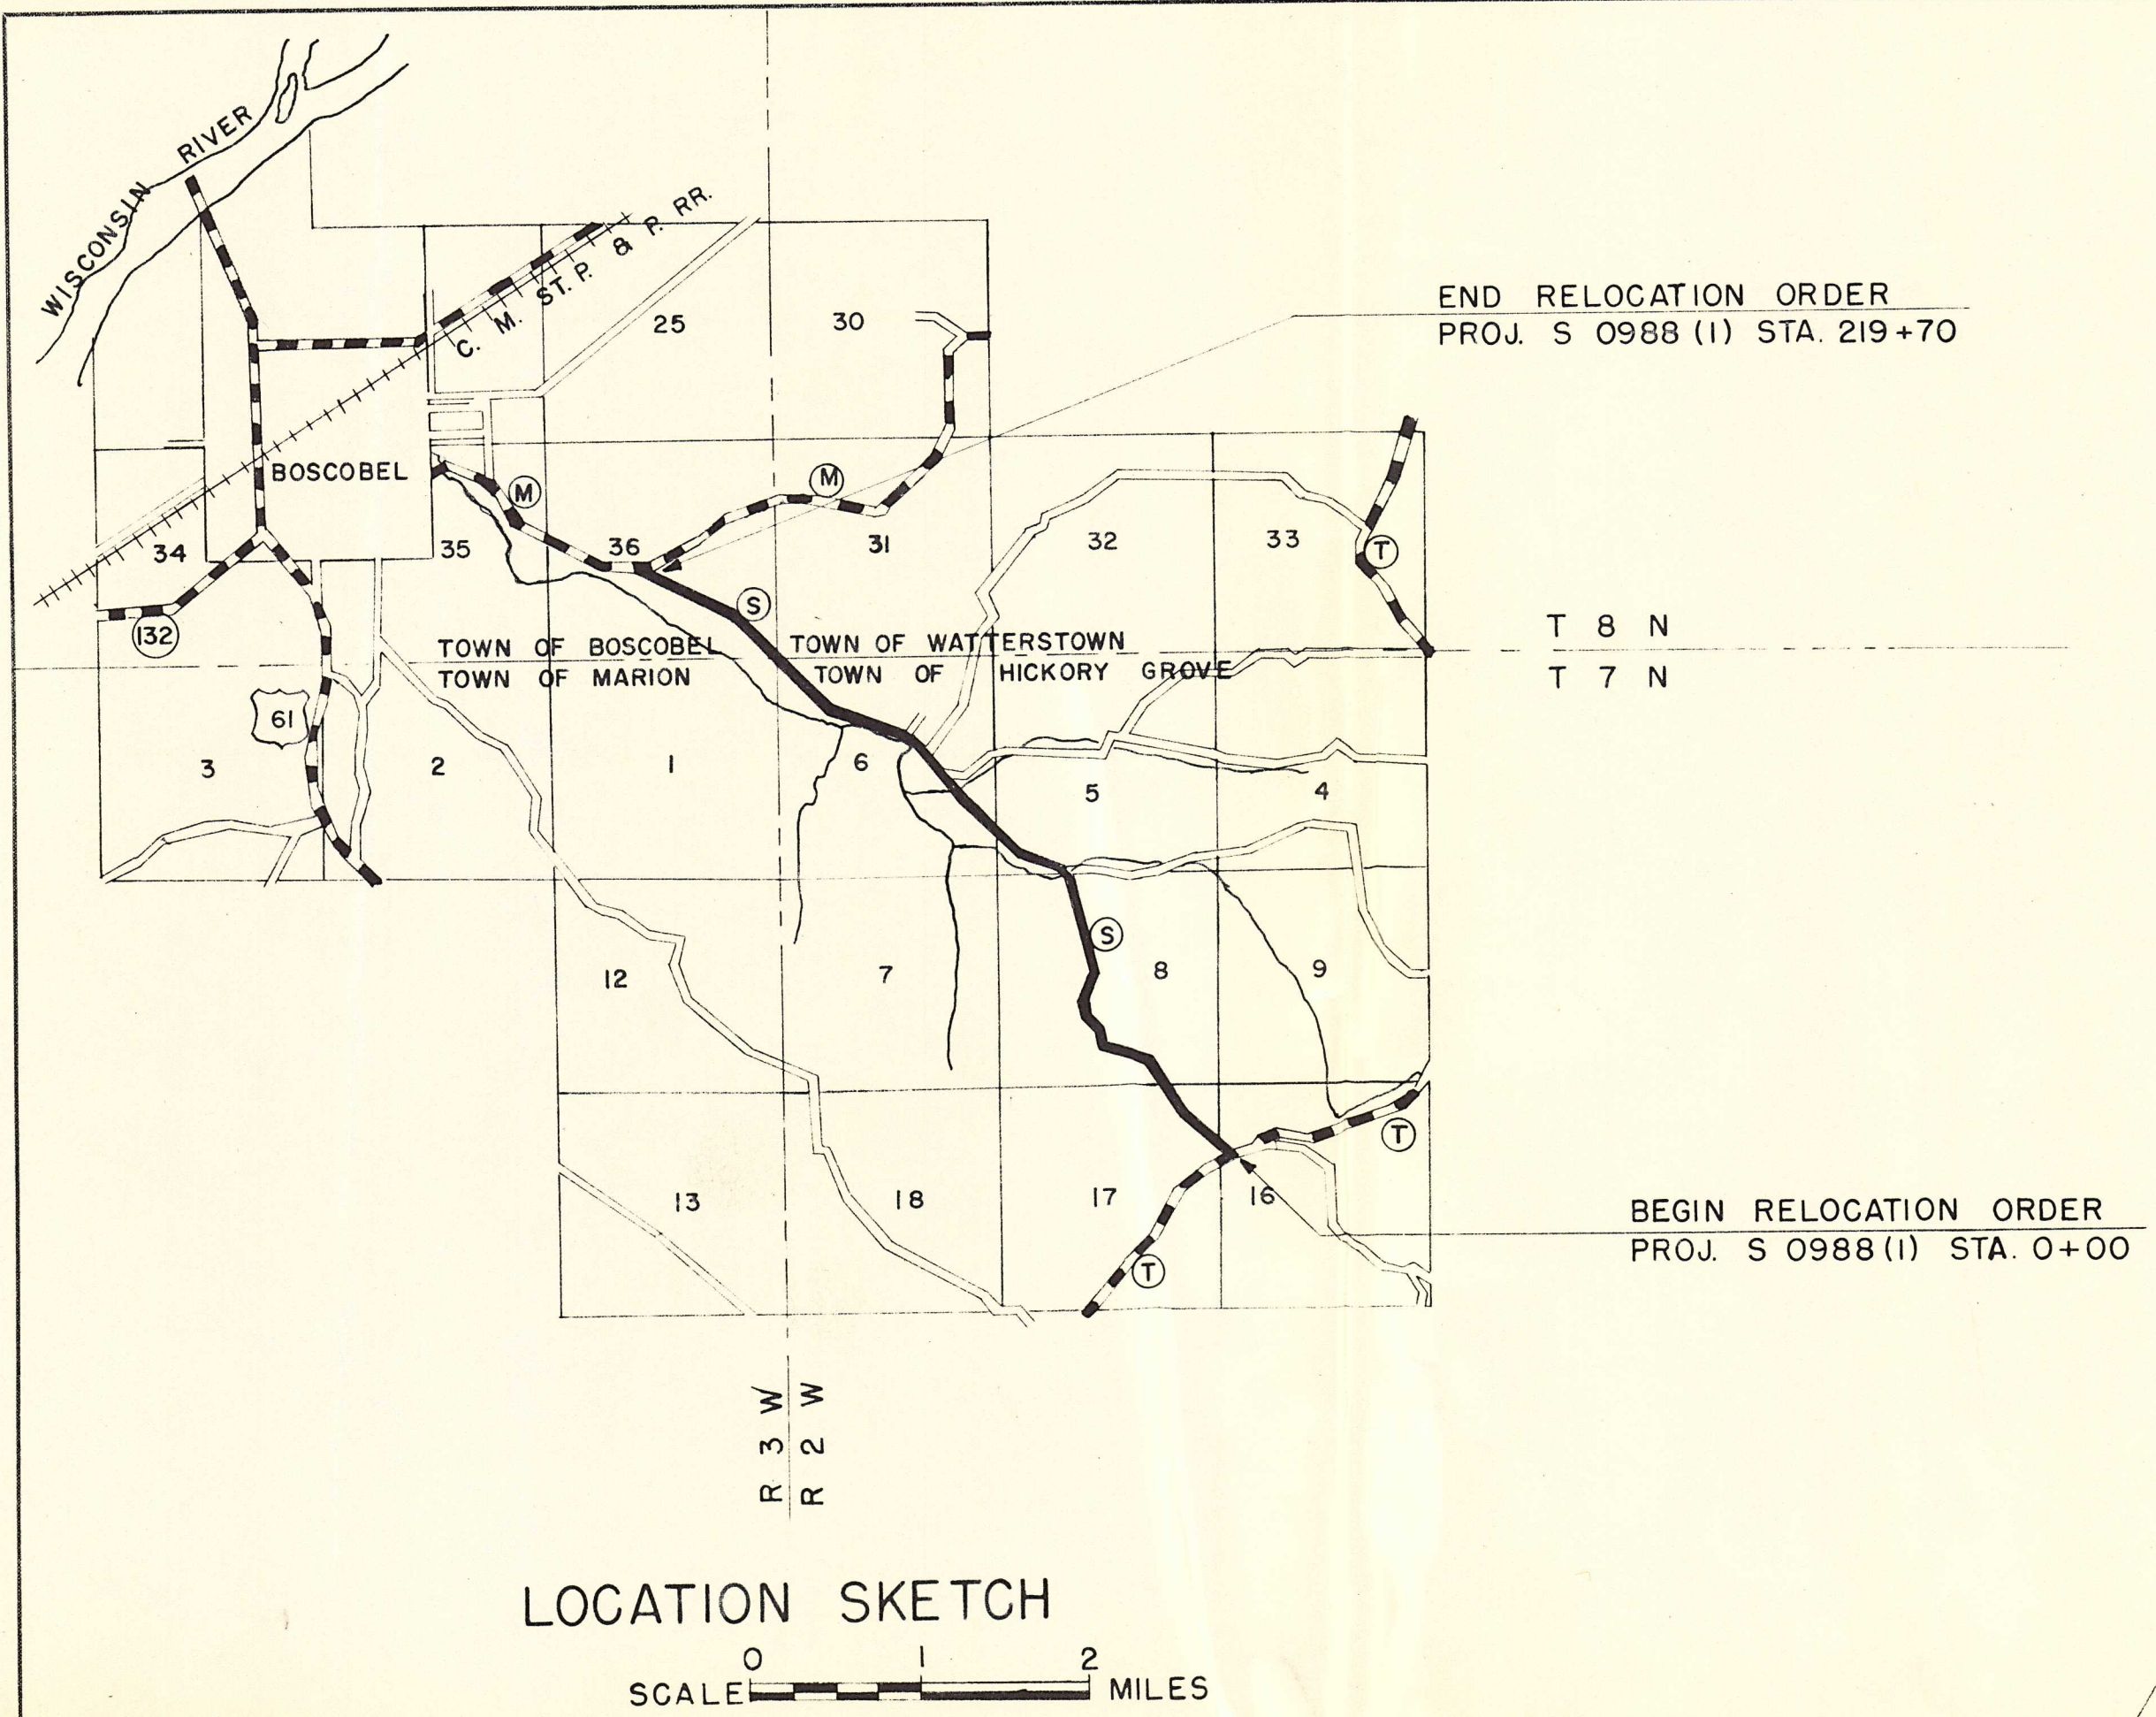

SCHEDULE OF LANDS & INTERESTS REQUIRED						
PARCEL	OWNER	ACRES REQ'D.	RODS BUILD	FENCE MOVE	INTEREST REQUIRED	ACRE
1	GLADYS NELSON	2.80		159	FEE SIMPLE TITLE	
2	CLARENCE FRICKE	3.85		145	" " "	
3	ED. H. SHIMPACH	0.55		41	" " "	
4	BERNARD E. YOUNG	3.82		226	" " "	L.H.E. 0.47
5	JOE STASKAL	1.97		204	" " "	
6	ADOLPH SALZGABER	6.95	179	209	" " "	L.H.E. 0.90
7	LEROY C. BAUMEISTER	0.98		63	" " "	L.H.E. 0.54
8	ELMER RIGGS	2.34		292	" " "	
9	WILLIAM WARD	3.05		85	" " "	L.H.E. 0.07

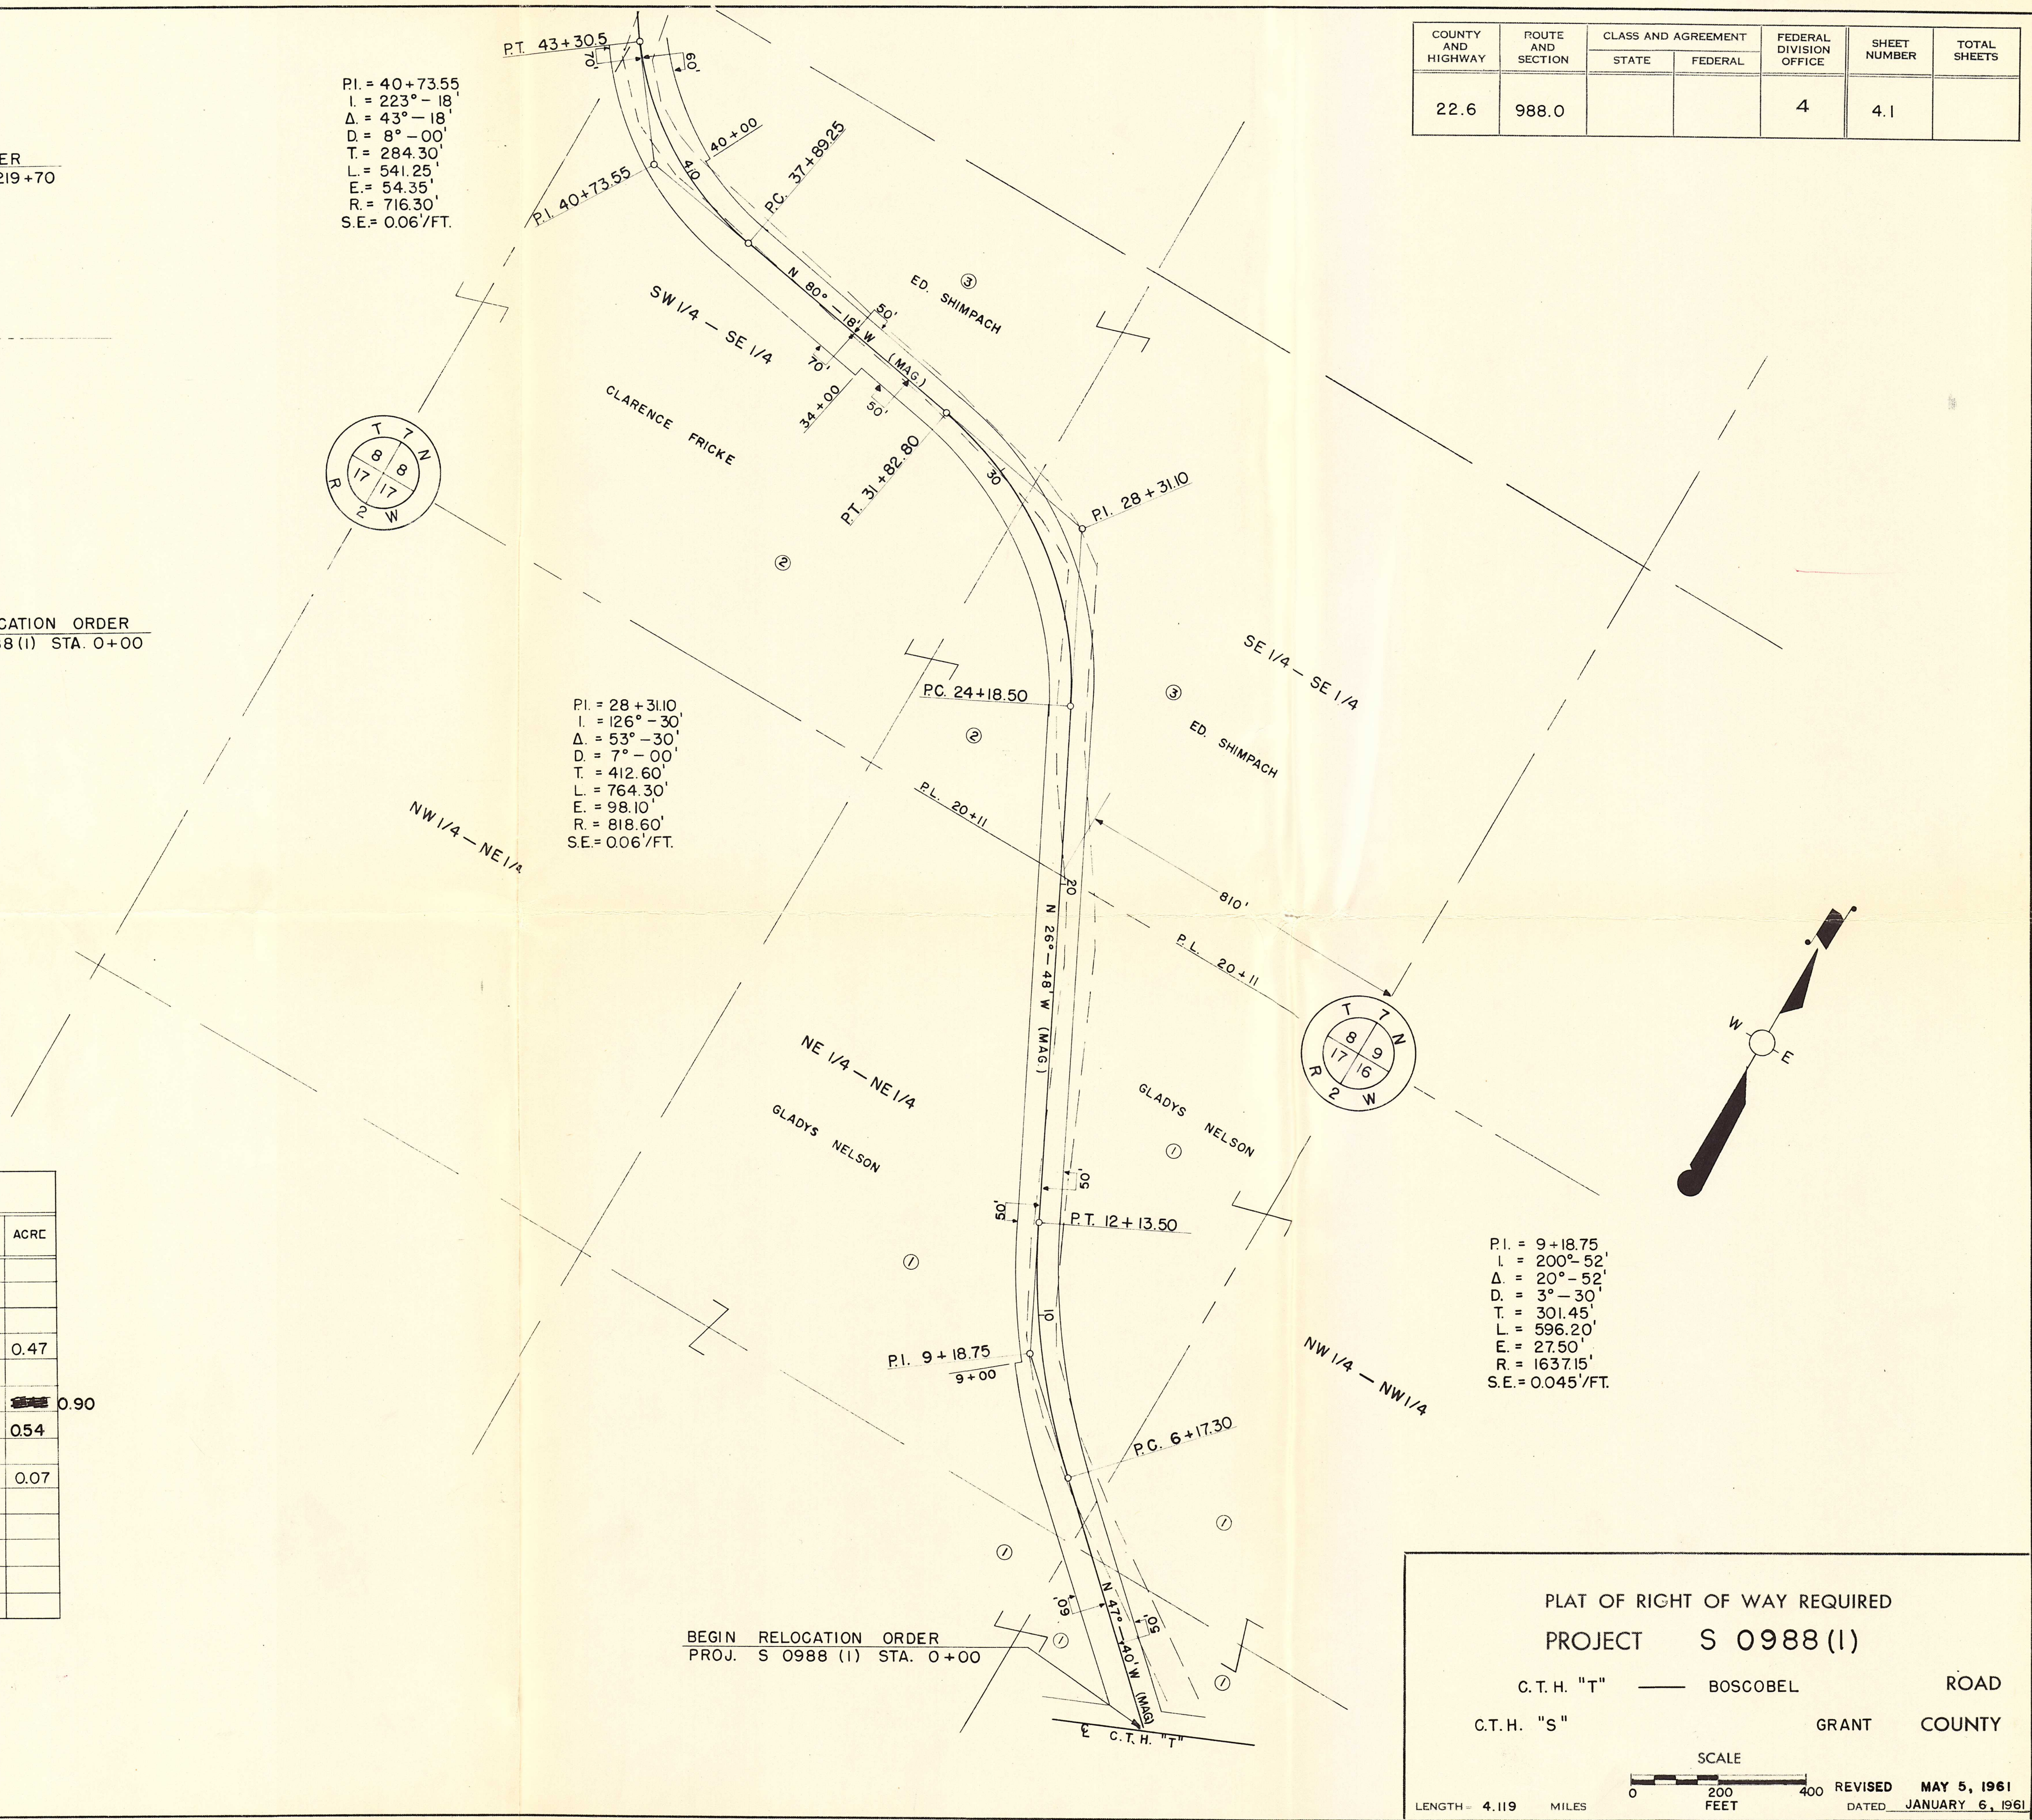

COUNTY AND HIGHWAY	ROUTE AND SECTION	CLASS AND AGREEMENT		FEDERAL DIVISION OFFICE	SHEET NUMBER	TOTAL SHEETS
		STATE	FEDERAL			
22.6	988.0			4	4.2	

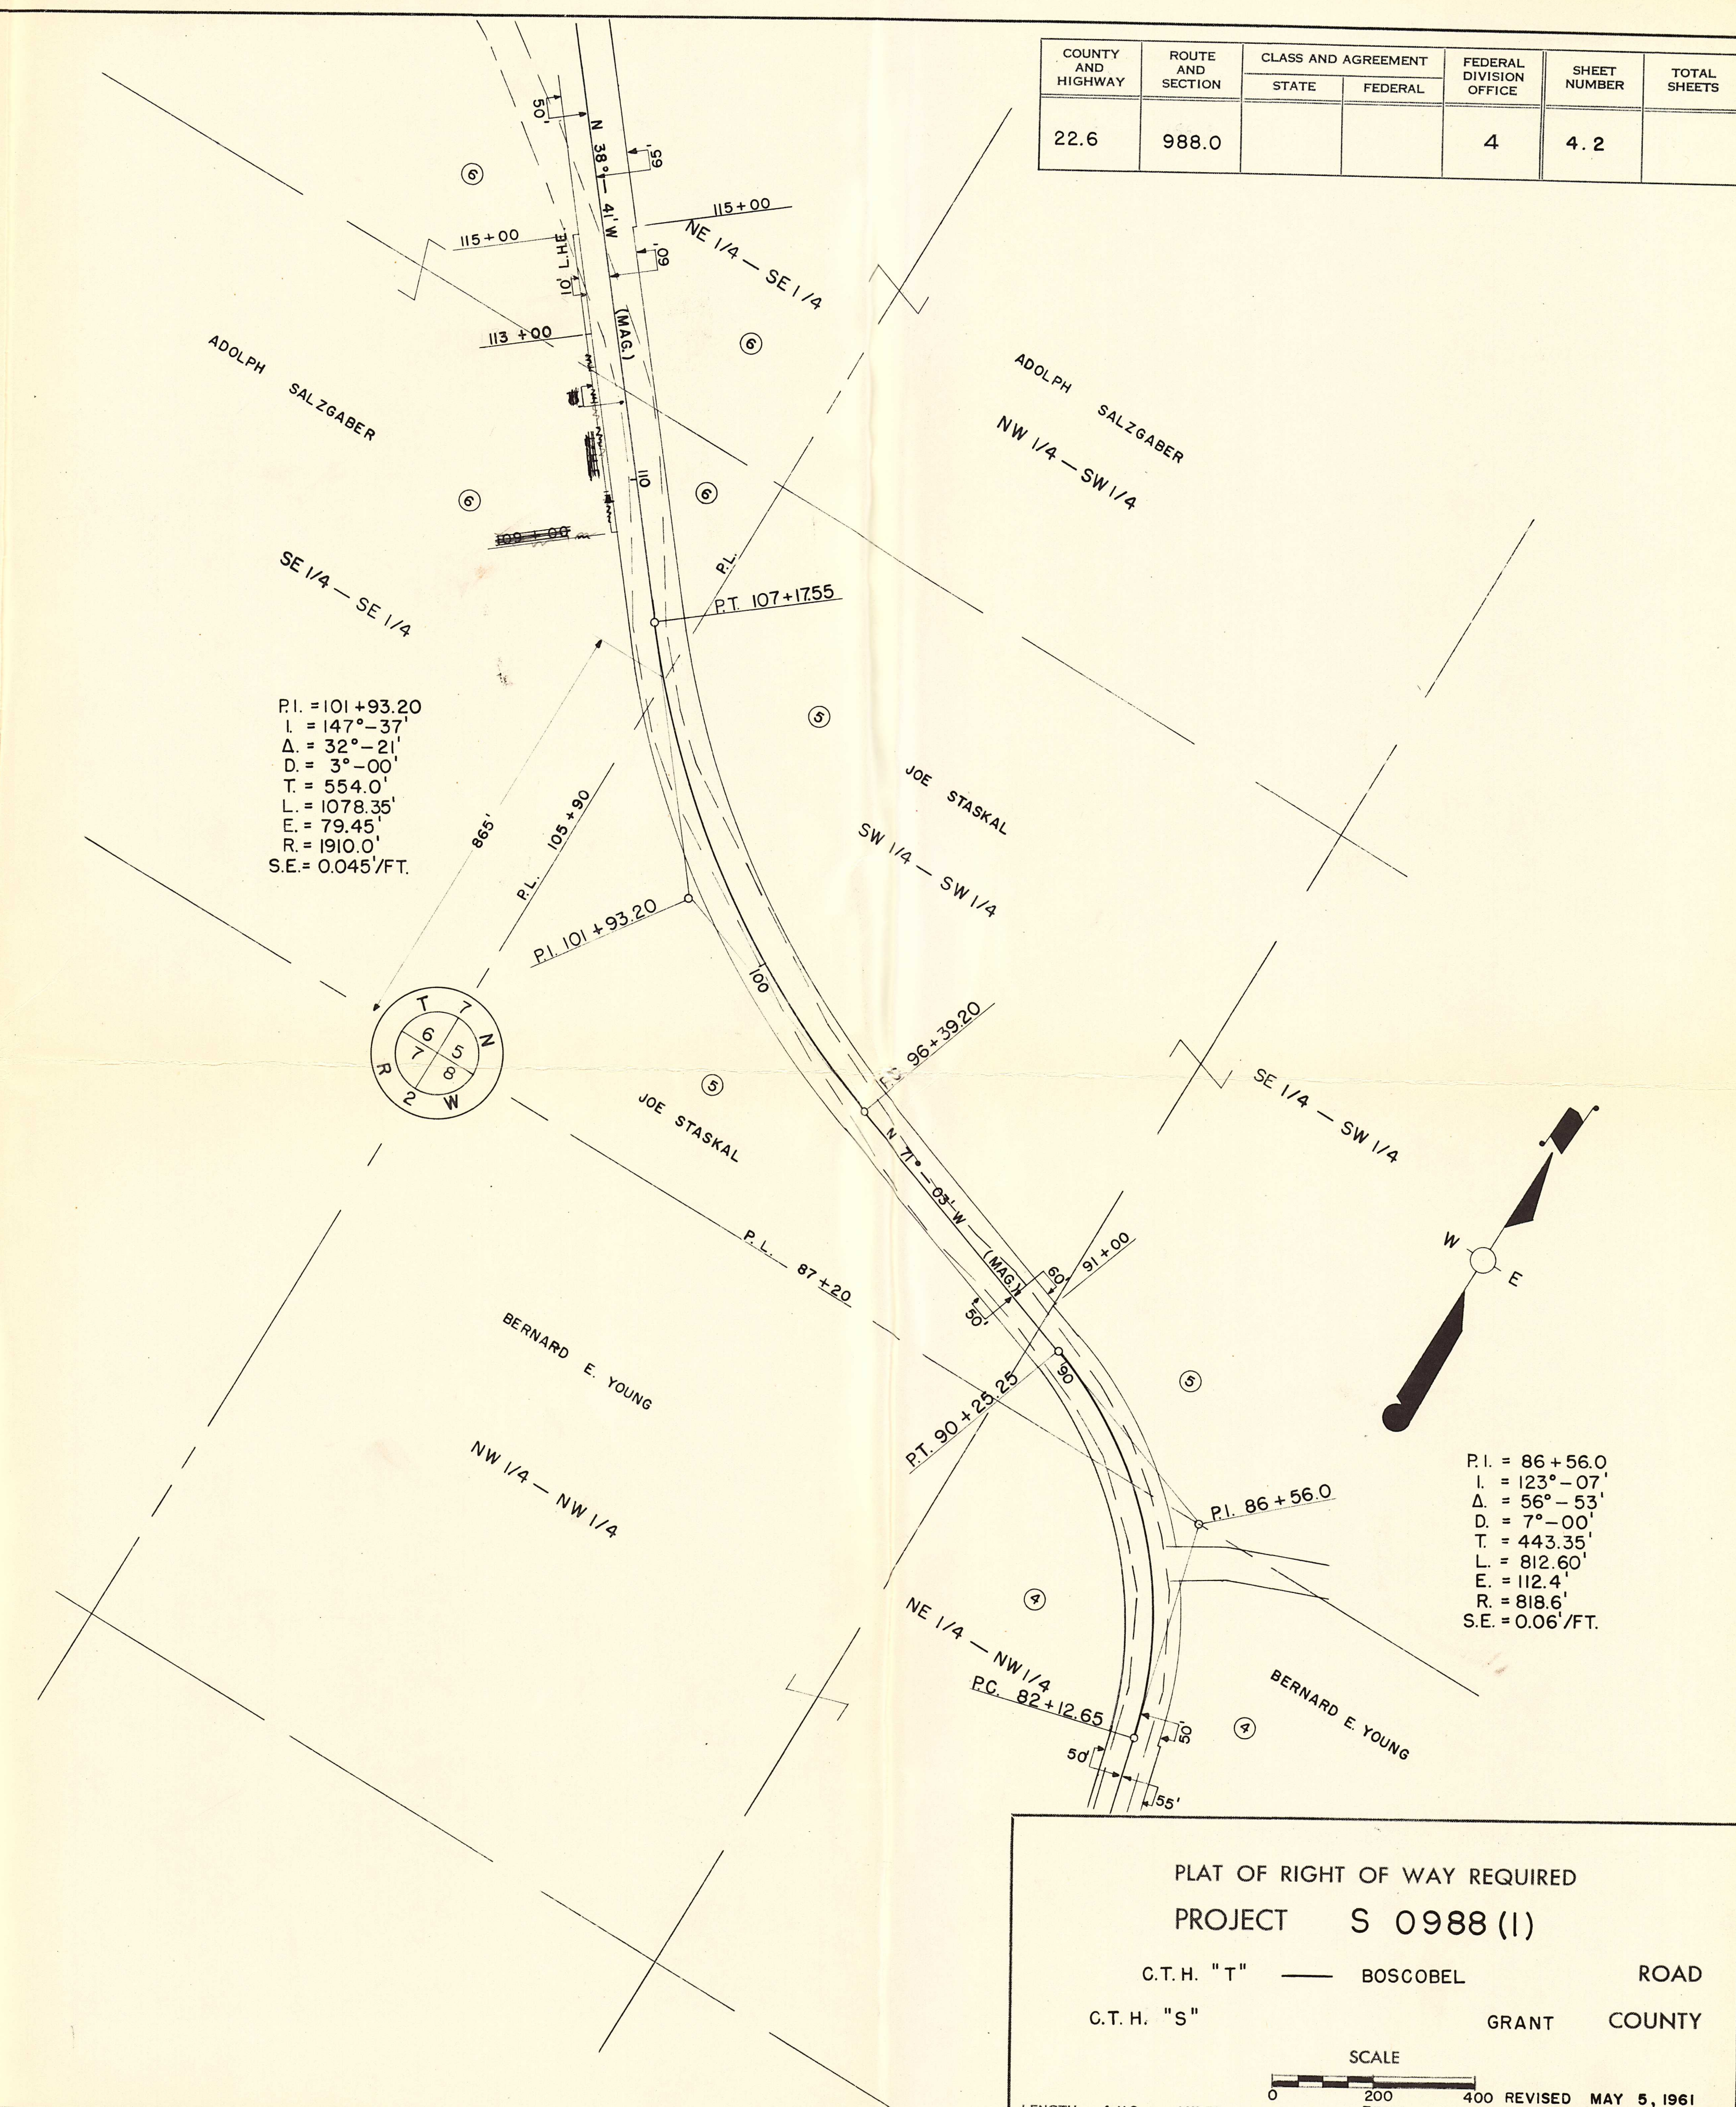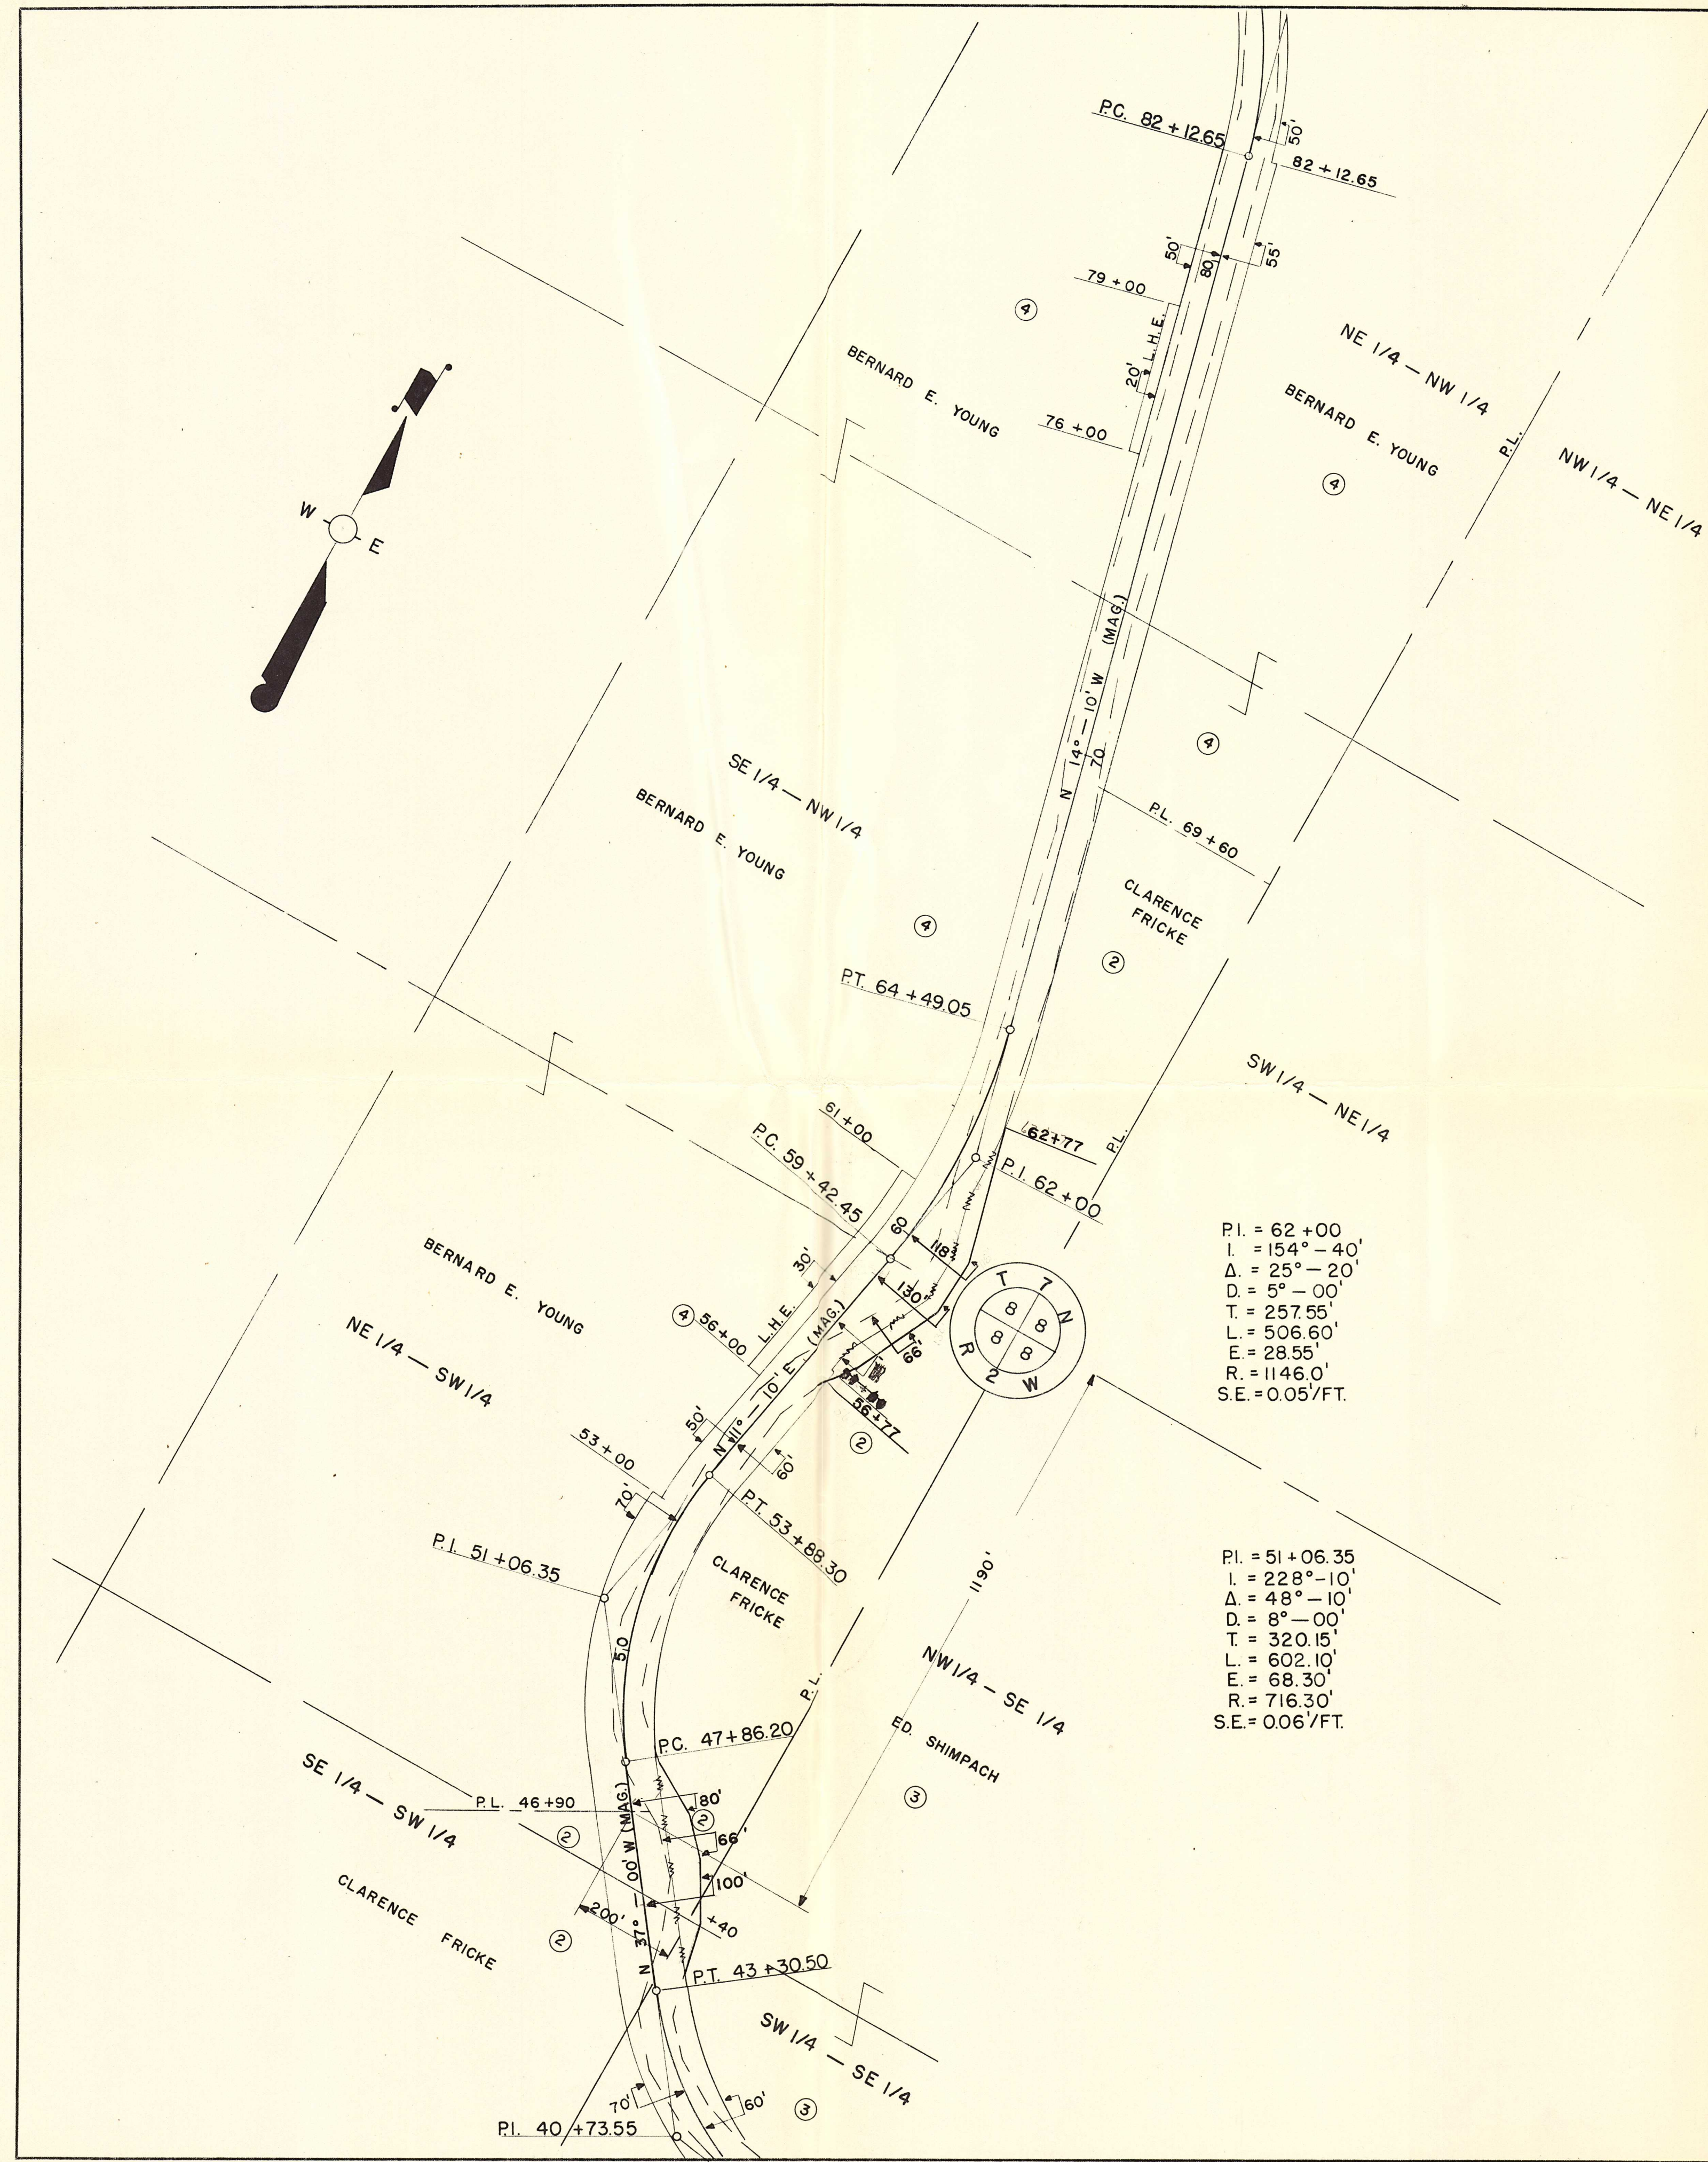



PLAT OF RIGHT OF WAY REQUIRED
PROJECT S 0988 (1)

C.T.H. "T" — BOSCobel ROAD
C.T.H. "S" — GRANT COUNTY

SCALE
0 200 400 FEET
LENGTH 4.119 MILES

REVISED MAY 5, 1961
DATED JANUARY 6, 1961

COUNTY AND HIGHWAY	ROUTE AND SECTION	CLASS AND AGREEMENT		FEDERAL DIVISION OFFICE	SHEET NUMBER	TOTAL SHEETS
		STATE	FEDERAL			
22.6	988.0			4	4.3	

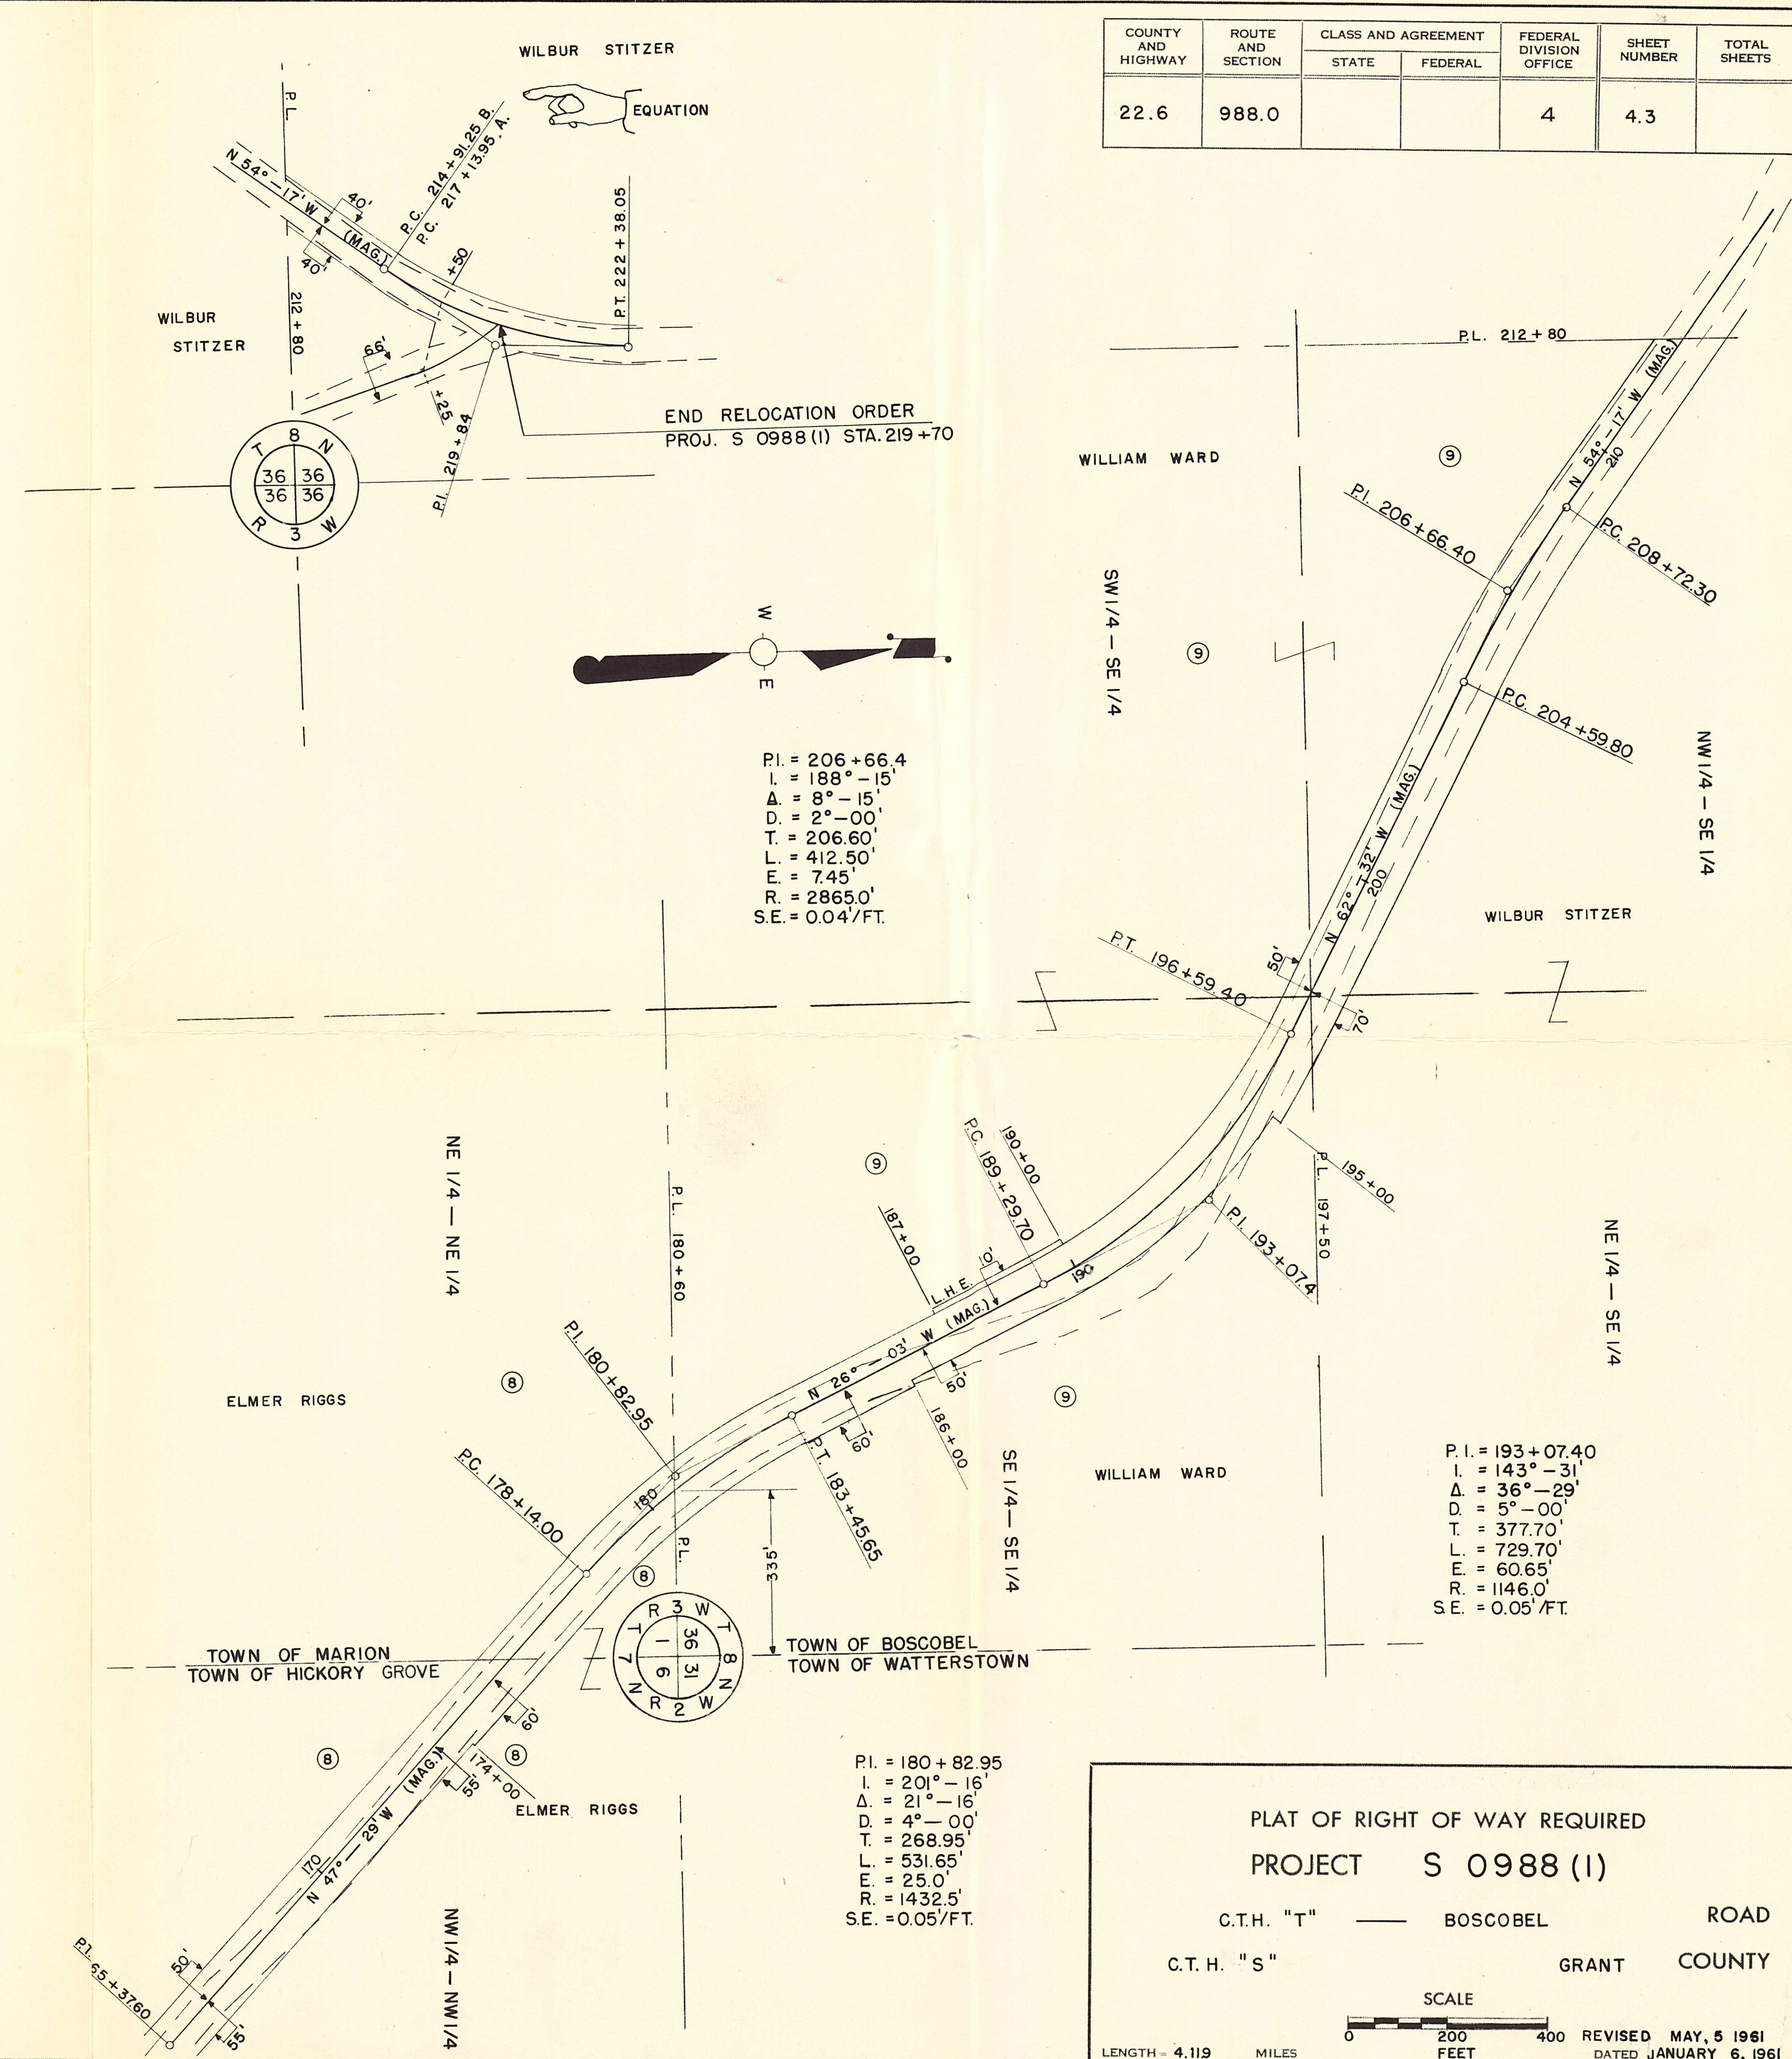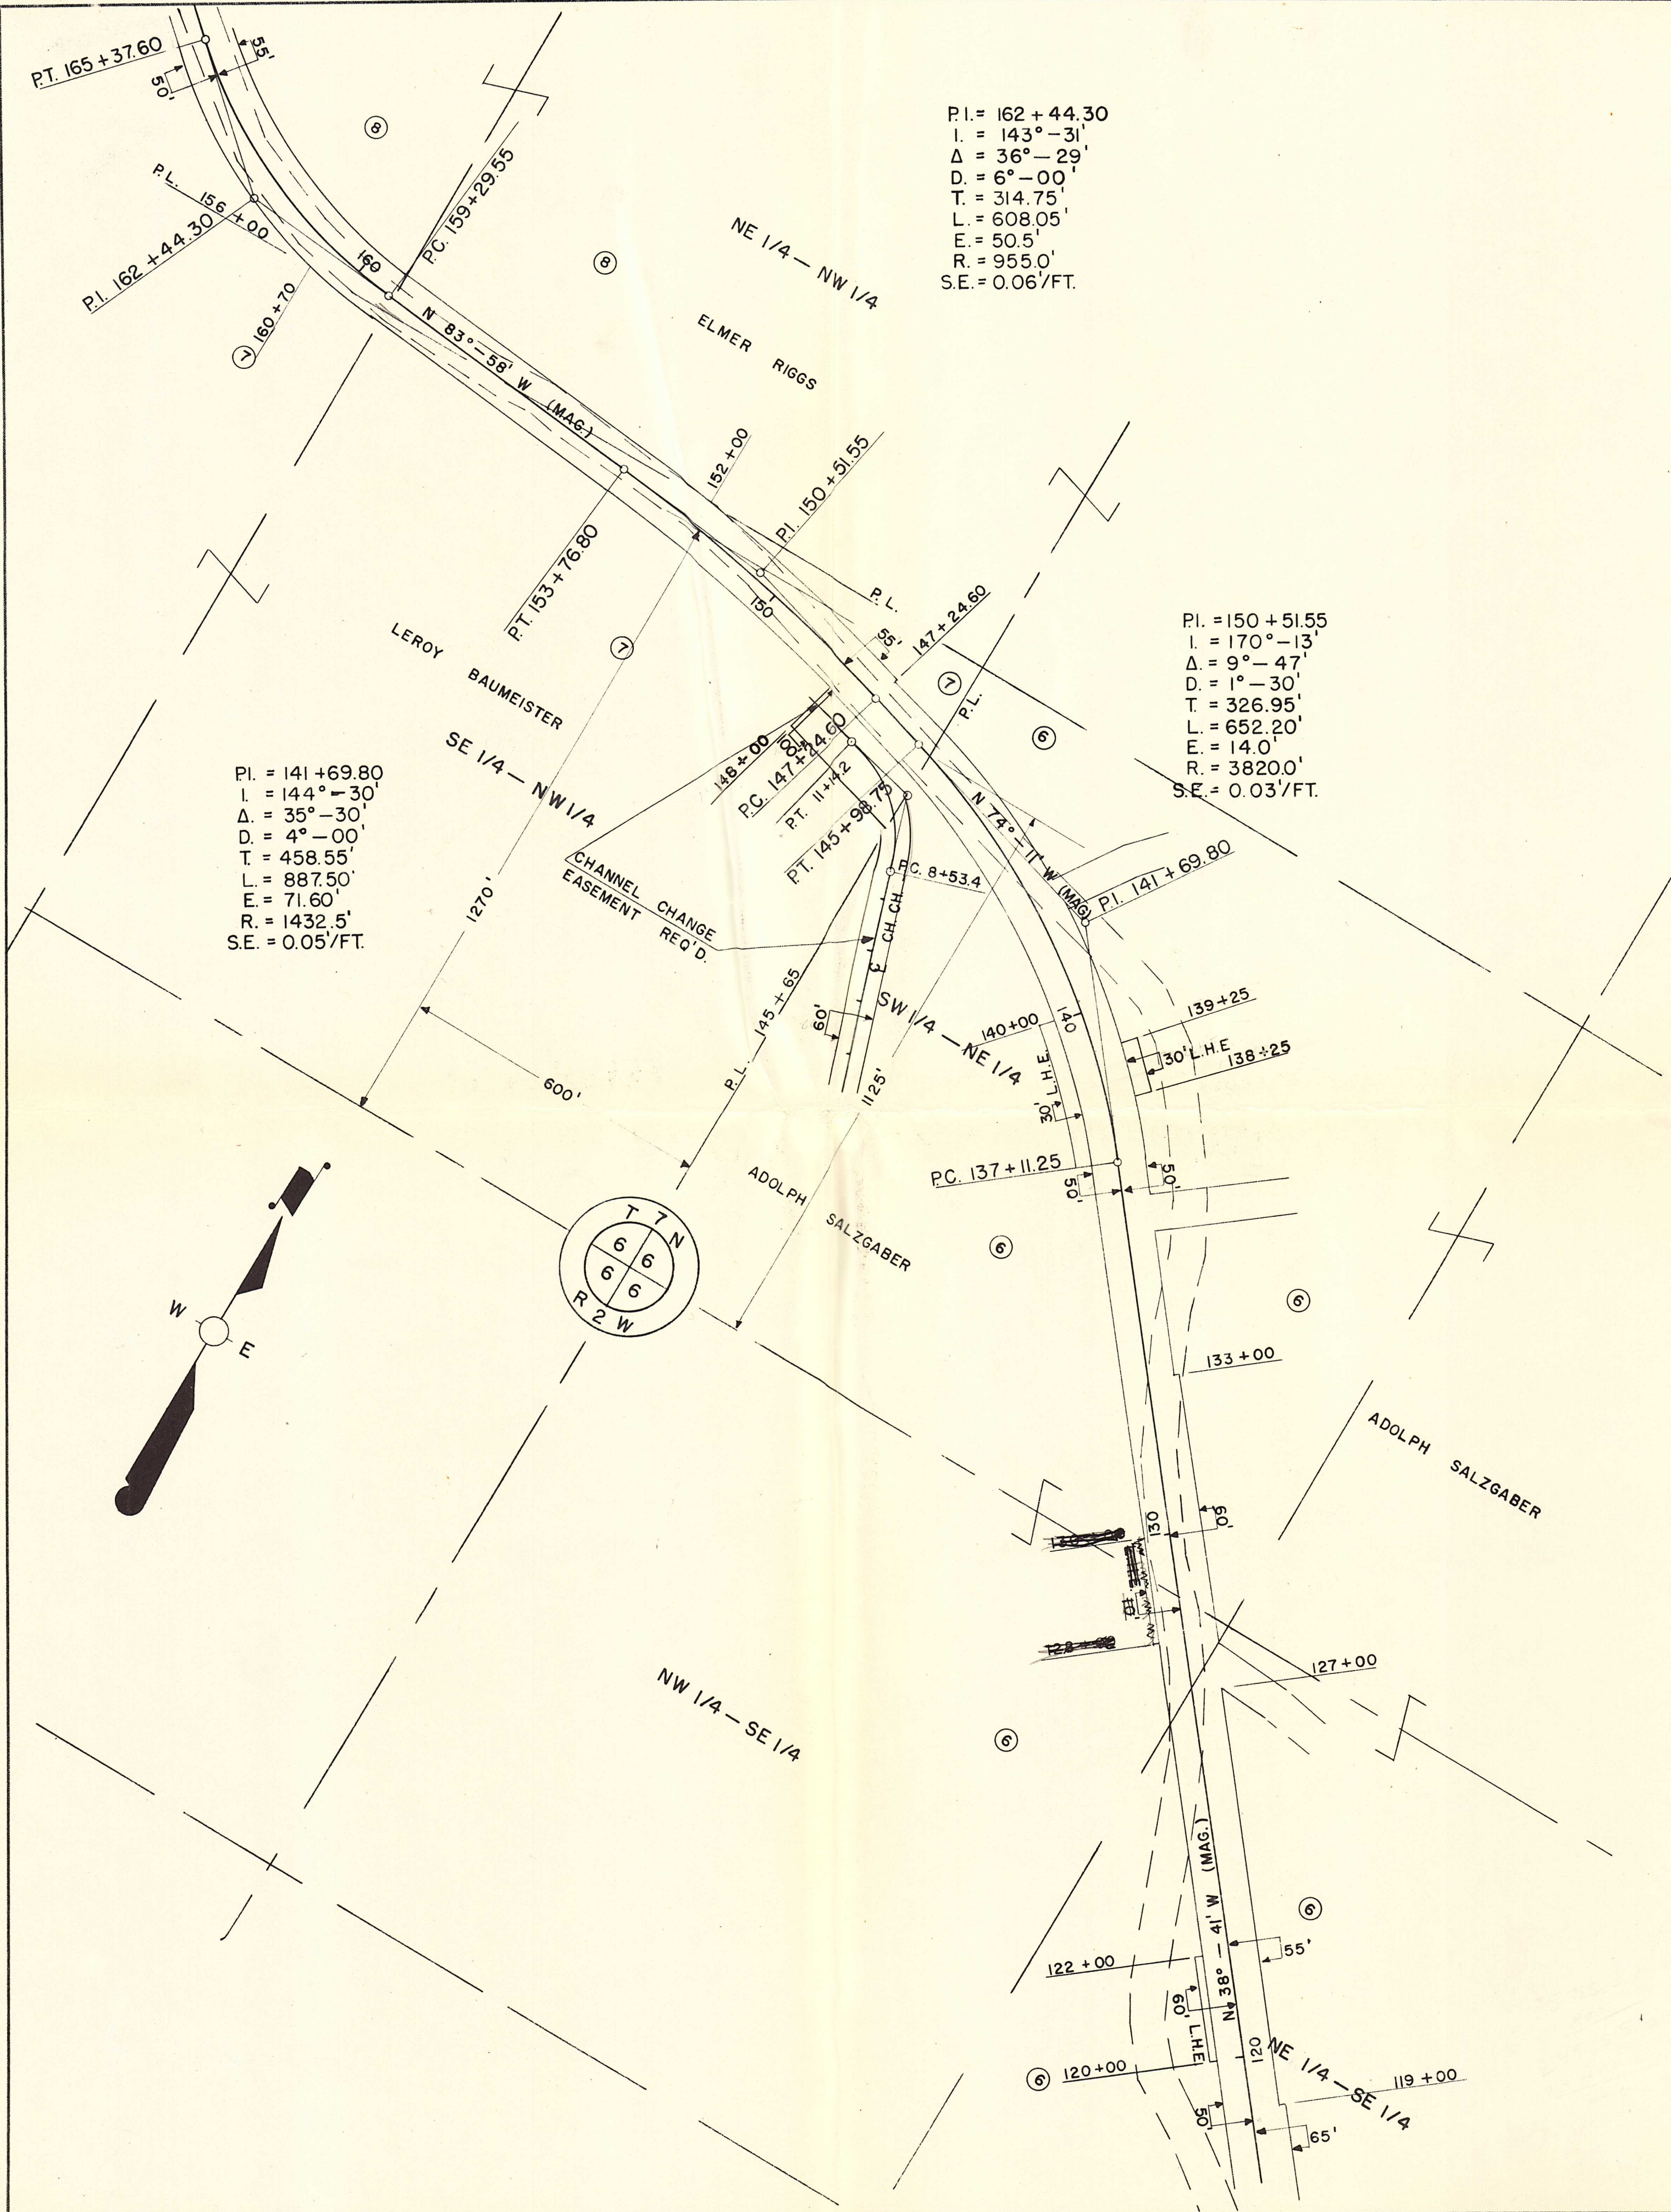

PLAT OF RIGHT OF WAY REQUIRED

PROJECT S 0988 (I)

C.T.H. "T"

C.T.H. "S"

BOSCOBEL

GRANT

ROAD

COUNTY

SCALE

LENGTH - 4.119 MILES

0

200

400

FEET

REVISED MAY, 5 1961

DATED JANUARY 6, 1961