BOOK 36 PAGE 26

Plat of Survey for Sheila & Tim Ruchti

of the East and South lines of those parts of the Southeast ¼ and the Southwest ¼ of the Southwest ¼ of Section 29, Town 7 North, Range 2 West, Hickory Grove Township, Grant County, Wisconsin.

Commencing at the Southeast corner of the said Southwest ¼; thence N 89°33'52" W along the South line thereof, 1337.41'; thence N 0°26'08" E, 160.80' to a railroad spike on the center line of Breezy Hill Road and the point of beginning; thence along the said center line, N 0°12'53" E, 224.20'; thence N 0°39'57" W, 153.83'; thence N 1°16'10" E, 49.95'; thence N 8°03'13" E, 50.03'; thence N 15°31'32" E, 50.00'; thence N 24°50'30" E, 49.89'; thence N 33°47'53" E, 49.95'; thence N 44°12'21" E, 50.02'; thence N 57°04'46" E, 49.95'; thence N 65°06'38" E, 50.05'; thence N 73°22'47" E, 49.77'; thence N 80°39'24" E, 50.18' to a railroad spike and the last point on said center line; thence S 8°07'02" E, 689.23' to a #6 rebar; thence S 84°35'45" W, 387.74' to the point of beginning.

Parcel contains 5.00 acres (217,815 Sq. Feet), more or less, and is subject to any and all easements and rights-of-way of record and/or usage, including, but not limited to 33' for Breezy Hill Road.

I, Bruce D. Bowden, Professional Wisconsin Land Surveyor - 1250, agent of Bowden Surveying, Ltd., do hereby certify that I have surveyed, described, mapped and monumented the property shown hereon in accordance with the instructions of Ms. Sheila Ruchti and that this map is a correct representation thereof to the best of my knowledge and belief.

Bruce D. Bowden, P.L.S. - 1250 **October 20, 2014**
Agent of Bowden Surveying, Ltd.

WISCONSIN
BRUCE D. BOWDEN
S-1250
DODGEVILLE
WI.
LAND SURVEYOR

If this stamp is not red colored and the surveyor's signature is not in blue ink, the map should be assumed to be a copy and may contain unauthorized alterations. The certificate shown hereon shall not apply to any copies.

This is the same property as surveyed by Paul W. Chafer for Glen Ruchti on October 20, 1990.

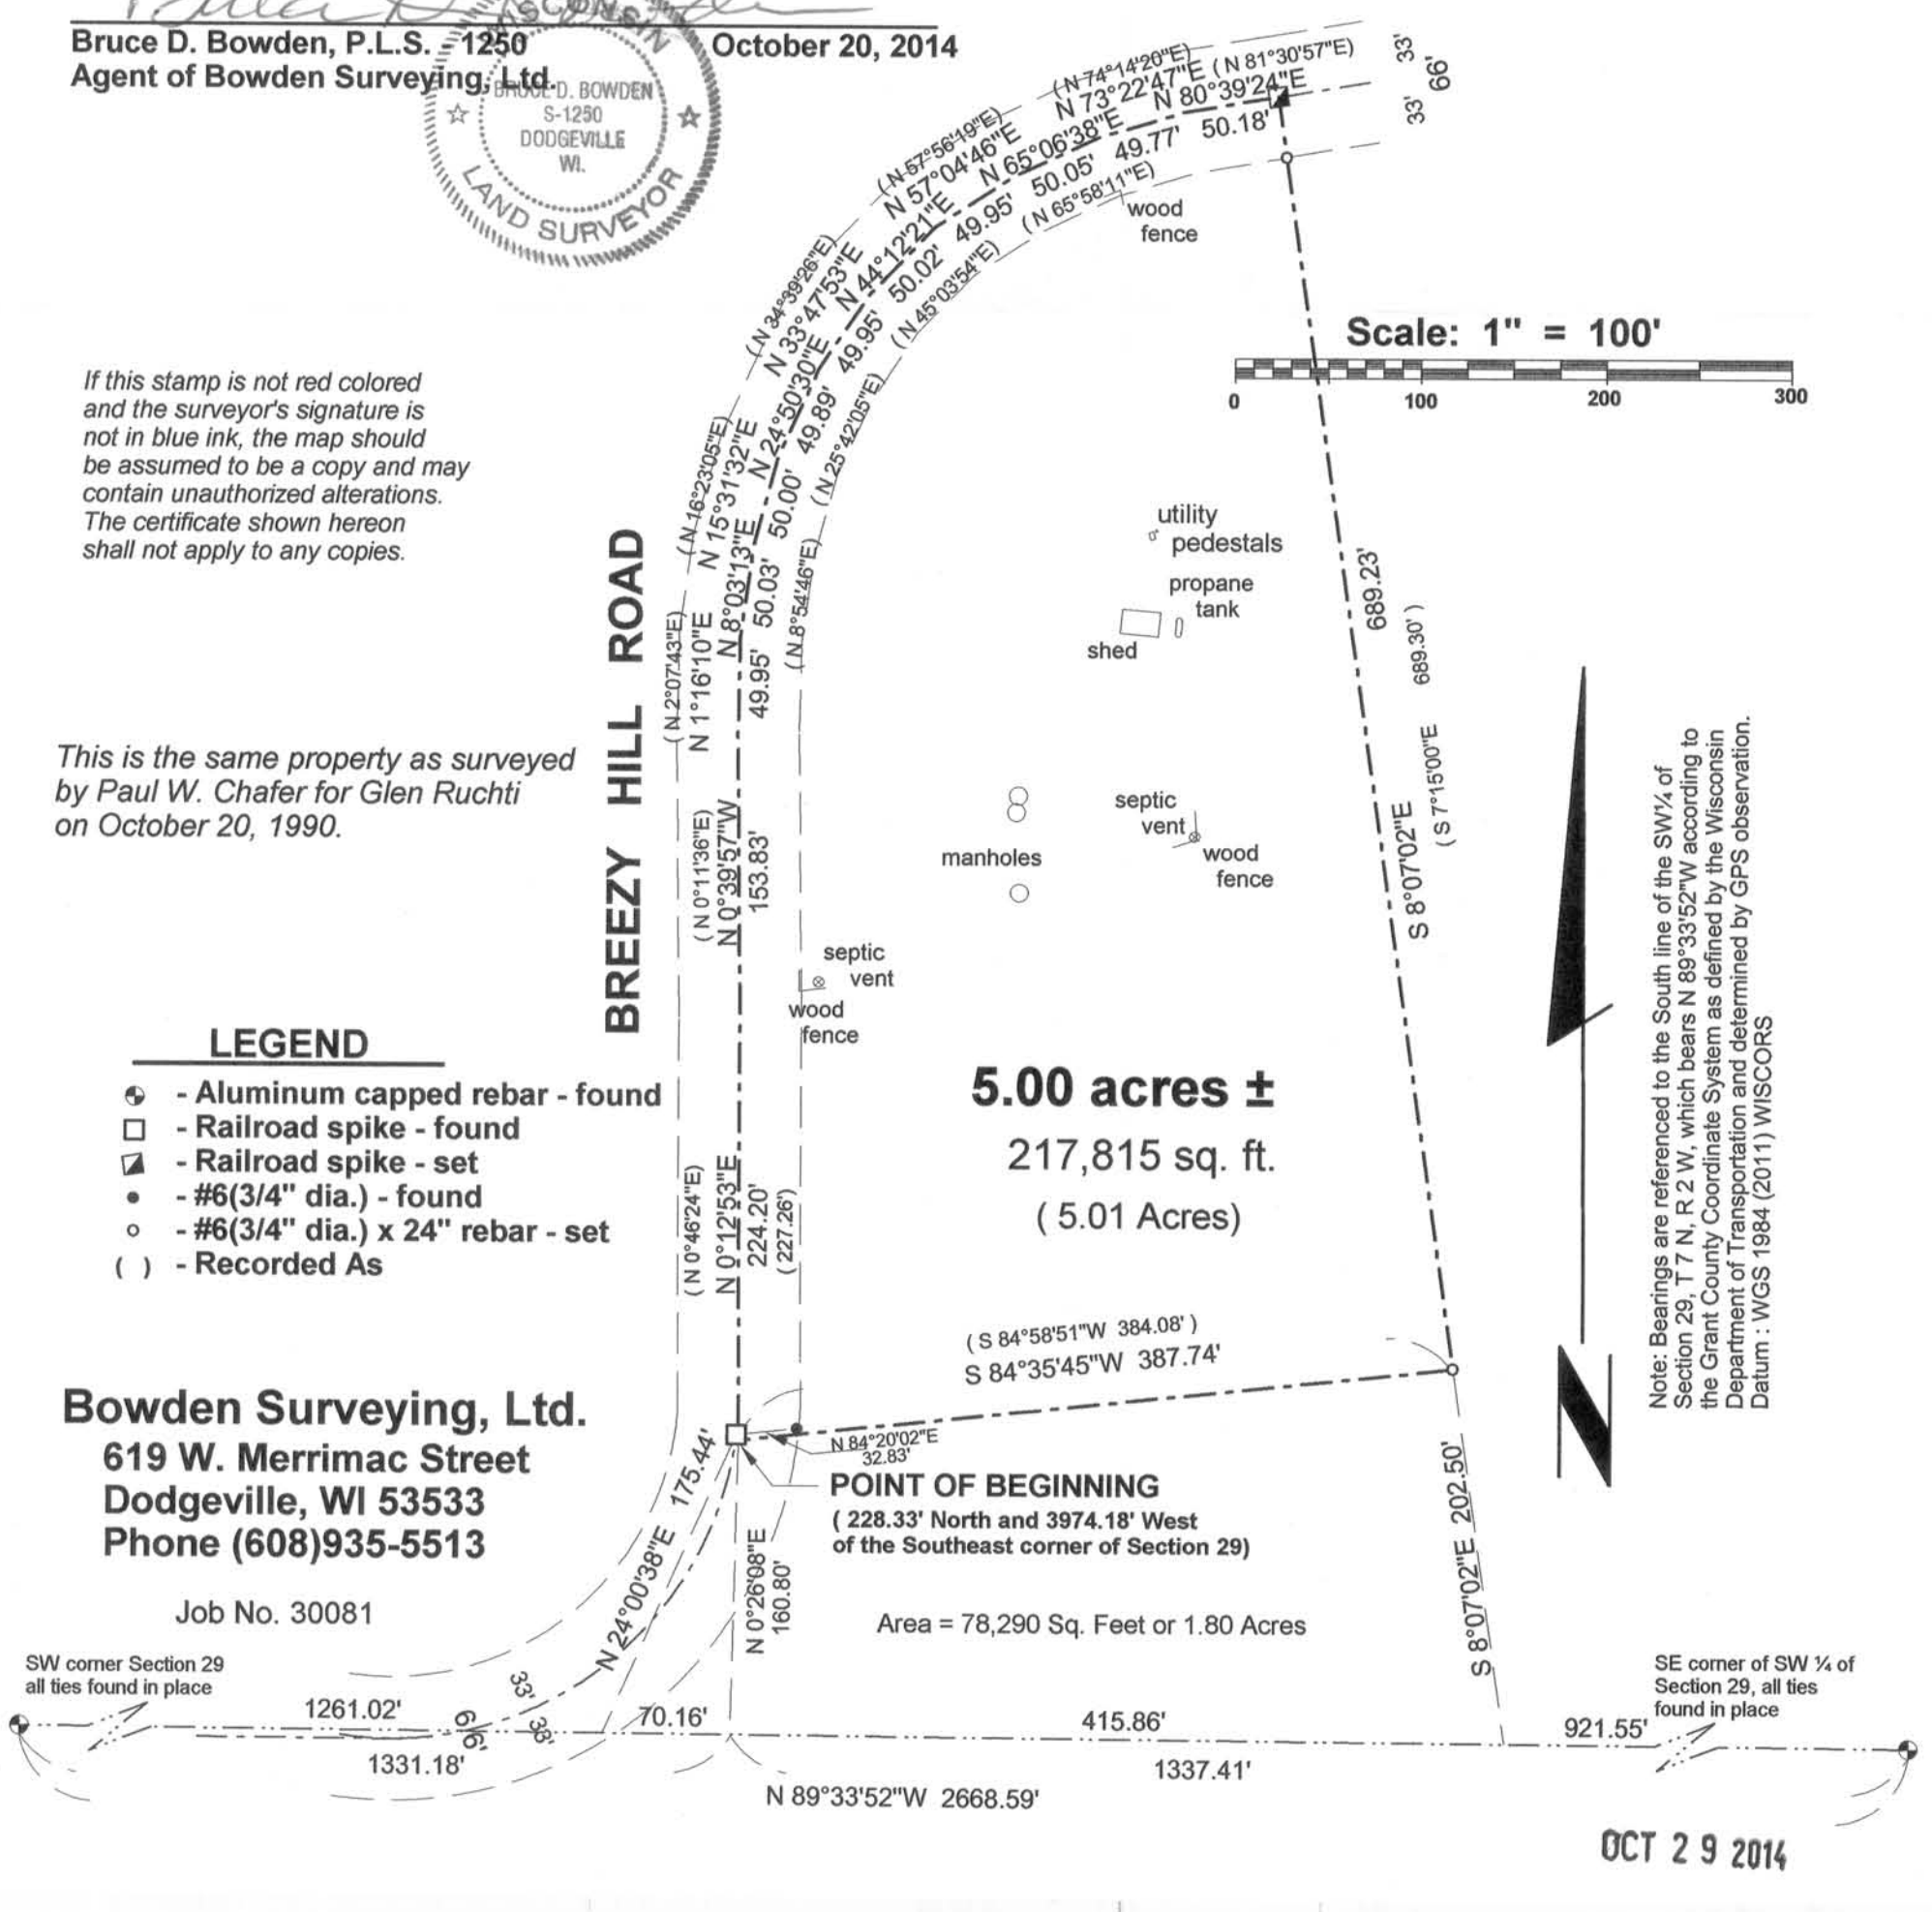

Bowden Surveying, Ltd.
619 W. Merrimac Street
Dodgeville, WI 53533
Phone (608)935-5513

Job No. 30081

OCT 29 2014