69

Sec 25, T6N, R1W

MORTGAGE INSPECTION

FOR : Anchor Savings & Loan Assoc.
80 South Court Street
PO1atteville, Wi. 53818
& Robert M. Helmich & Mary E. Helmich
Montfort, Wi. 53569

As client(s) of Bruce D. Bowden, Wisconsin Land Surveyor, I/We request that the survey be made according to the following specifications :

1. Only enough work be performed to satisfy the requirements of Anchor Savings & Loan Assoc.
2. No stakes be set to mark the corners of the parcel.
3. The exact length and bearing of the boundaries of the parcel need not be shown.
4. Measurements need not be taken as specified in A-E 5.01(6) of the Wisconsin Administrative Code. It is specifically intended to exempt this survey from the requirements of A-E 5.01(5)(c) & (d) and A-E 5.01 (6) of the Wisconsin Administrative Code.

Lawrence O'Malley ---------- 12-17-86
Date

DESCRIPTION:

The South 34' of Lot 5 and all of Lots 6, 7 & 8 of Block 1 of Oleson Addition in the Southeast 1/4 of the Northeast 1/4 of Section 25, Town 6 North, Range 1 West, Village of Montfort, Grant County, Wisconsin.

SURVEYOR'S CERTIFICATE: I hereby certify that I have surveyed the above described parcel and that the map shown hereon is a true and correct representation thereof to the best of my knowledge and belief, and shows the size and location of the parcel, its recorded exterior boundaries, the location of visible roadways and encroachments, if any. This survey is made for the of the present owners of the property and those who purchase, mortgage, or guarantee the title thereto within one year from the date hereon.

Bruce D Bowden
Bruce D. Bowden, R.L.S. - 1250

WISCONSIN
BRUCE D. BOWDEN
S-1250
December 16, 1986
LAND SURVEYOR

Bruce D. Bowden
704 North Main Street
Dodgeville, Wi. 53533
Phone(608) 935 - 5513

AUSTIN - BOWDEN ASSOC.

Larry L. Austin
Route 3, Box 86A
Platteville, Wi. 53818
Phone (608) 348 - 9993

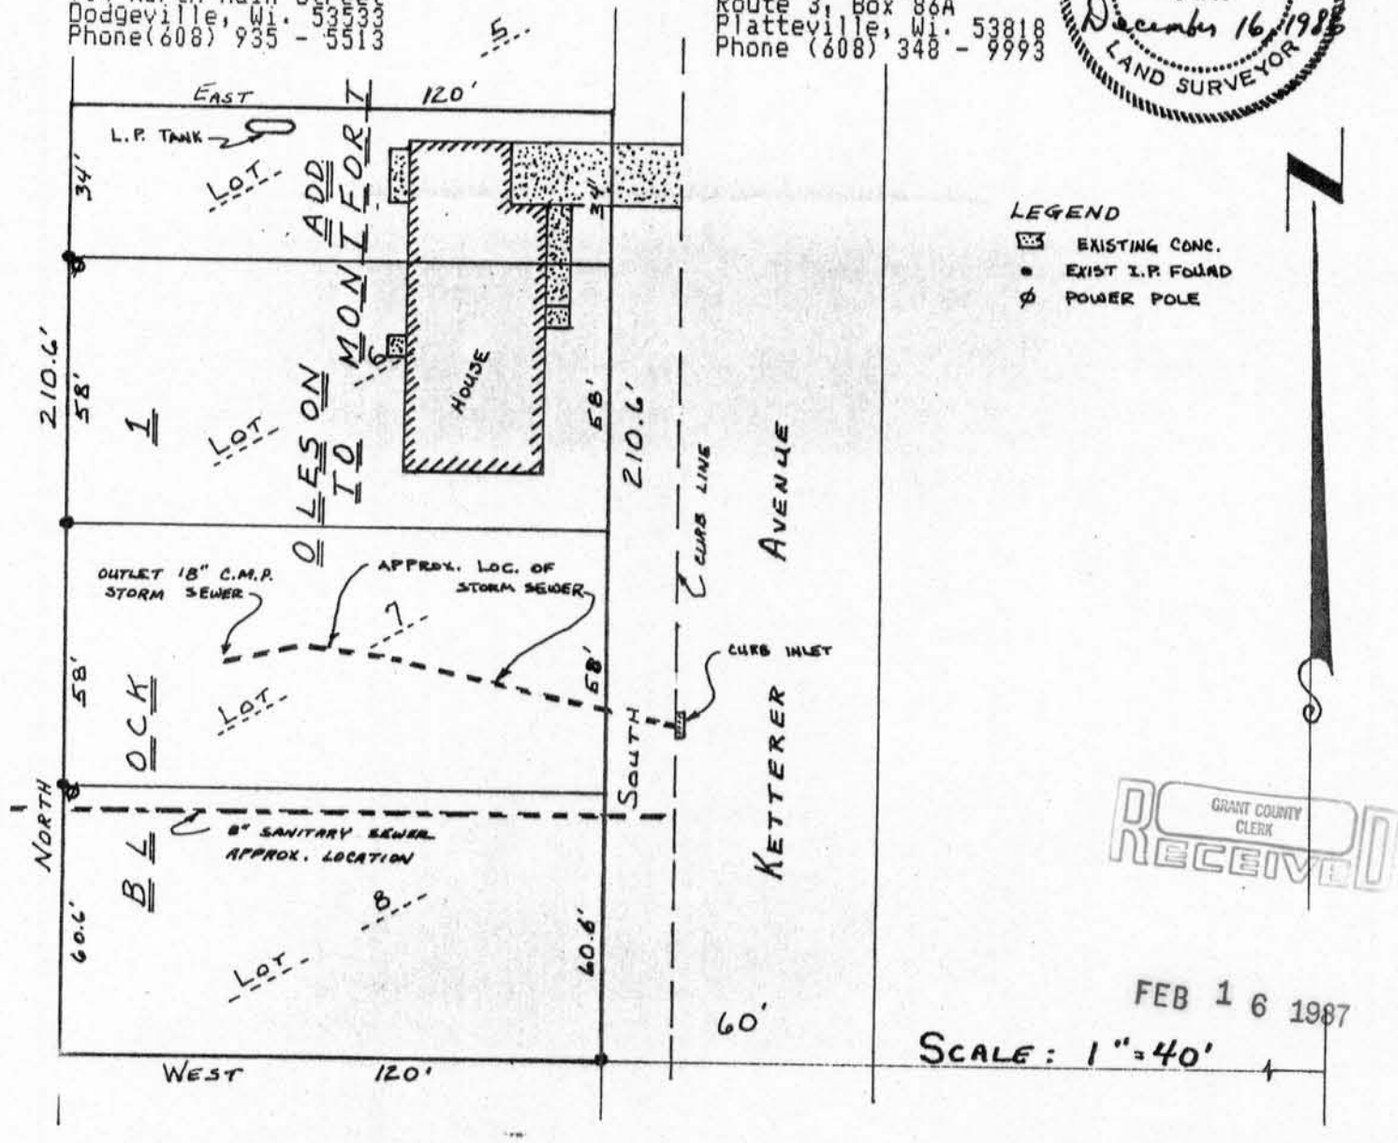

GRANT COUNTY CLERK
RECEIVED
FEB 16 1987