Sec. 12, T 8N, R 1W

AUG 28 1987

RECEIVED

88

BENCHMARK SURVEYS, INC.
P.O. BOX 486 608-583-2333
RICHLAND CENTER, WISCONSIN. 53581

SURVEYING — PLANNING

N

SCALE 1" = 40'

MORTGAGE INSPECTION

PLAT OF SURVEY

FOR

JOSEPH BAILEY

Anchor Savings and Loan Association.

FURNISHED DESCRIPTION:

Lots 3 and 4, of Block 117, of the original plat of the Village of Muscoda, located in part of Section 12, Township 8 North, Range 1 West, Town of Muscoda, Grant County, Wisconsin.

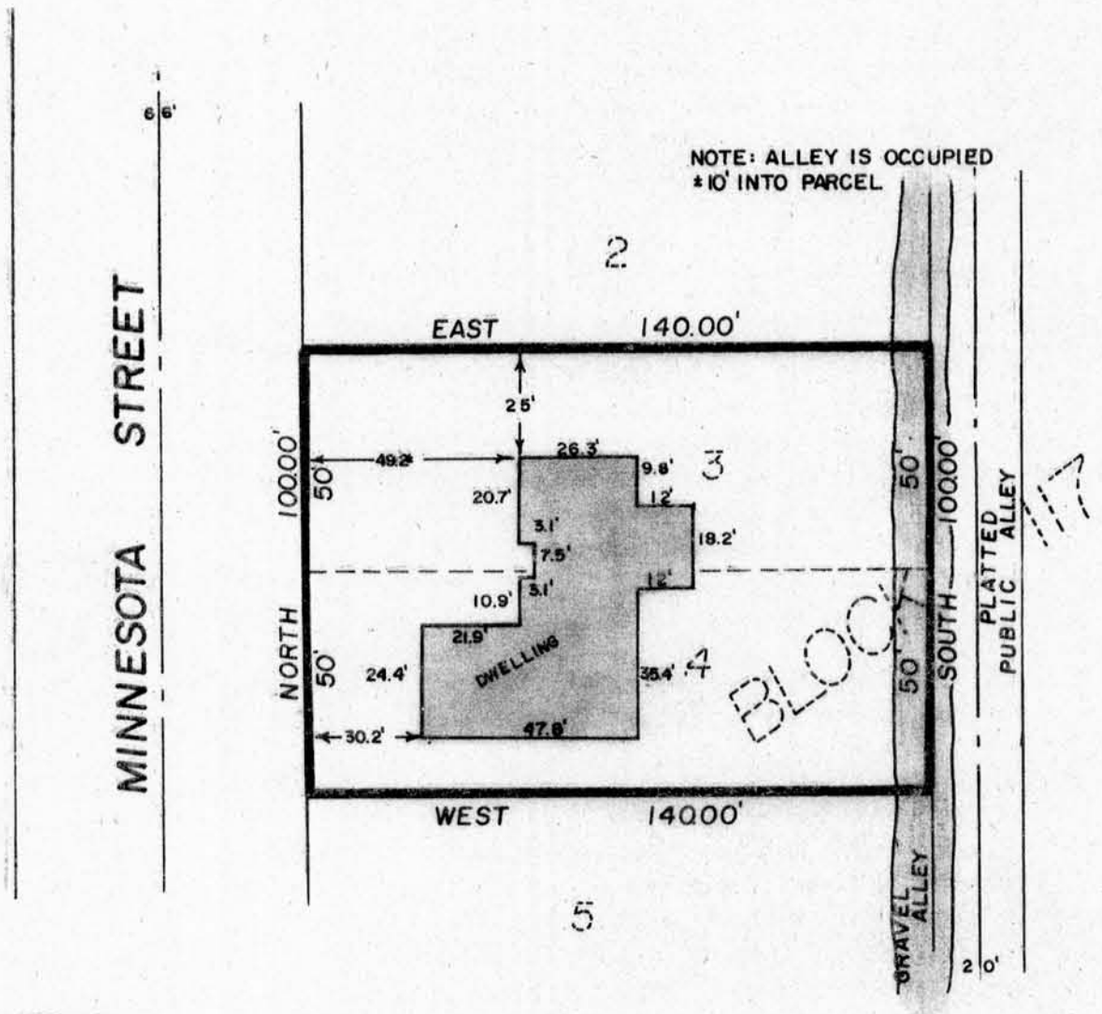

WAIVER

We hereby acknowledge that all standards setforth in the Wisconsin administrative Code Chapter A-E 7.01 for minimum Surveying standards are being waived.

Owner/Agent Date

Owner/Agent Date

I HAVE SURVEYED THE ABOVE DESCRIBED PROPERTY, AND THE ABOVE MAP IS A TRUE REPRESENTATION THEREOF AND SHOWS THE SIZE AND LOCATION OF THE PROPERTY, ITS EXTERIOR BOUNDARIES, THE LOCATION AND DIMENSIONS OF ALL STRUCTURES THEREON, FENCES, ROADWAYS, APPARENT EASEMENTS AND ENCROACHMENTS, IF ANY.

THIS SURVEY IS MADE FOR THE EXCLUSIVE USE OF THE PRESENT OWNERS OF THE PROPERTY, AND ALSO THOSE WHO PURCHASE, MORTGAGE OR GUARANTEE THE TITLE THEREOF, WITHIN ONE (1) YEAR FROM DATE HEREOF; AND AS TO THEM I HEREBY CERTIFY THAT SAID SURVEY AND THE ABOVE MAP WERE MADE IN ACCORDANCE WITH ACCEPTABLE PROFESSIONAL STANDARDS AND THAT THE INFORMATION CONTAINED HEREON IS, TO THE BEST OF MY KNOWLEDGE, INFORMATION AND BELIEF A TRUE AND ACCURATE REPRESENTATION THEREOF.

DATED July 14, 1987

WISCONSIN
MATTHEW J. JANIAK
S-1454
Richland Center
Wisconsin
LAND SURVEYOR

DRAFTED BY: S. WALSH

JOB NO. 423