127

Sec. 9, T3N, R2W

PLAT OF SURVEY

Description for Harry Reddy

That part of the Northwest 1/4 of the Northwest 1/4 of Section 9, Town 5 North, Range 2 West, being in the unincorporated area of Stitzer, Liberty Township, Grant County, Wisconsin, more fully described as:

Commencing at the Northwest corner of Section 9; thence S 0 06'56" W, along the West line thereof, 1330.56' to the Southwest corner of the Northwest 1/4 of the said Northwest 1/4; thence East, 943.50'; thence N 51 56'00" E, 194.49' to the point of beginning; thence N 51 56'00" E, 12.82'; thence N 31 00 00" E, 135.96' to the most Northerly corner of that property as described in Volume 461 on Page 92; thence S 5 20'00" W, 113.42'; thence S 80 36'15" W, 70.52' to the point of beginning. Containing 0.082 acres, more or less, and being subject to any and all recorded easements and rights-of-way.

I, Bruce D. Bowden, Registered Wisconsin Land Surveyor - 1250, do hereby certify that I have surveyed, divided, monumented and mapped the property described hereon in accordance with the instructions of Mr. Harry Reddy and that this map is a correct representation thereof to the best of my knowledge and belief.

Bruce D. Bowden

Bruce D. Bowden R.L.S. - 1250

August 24, 1987

Date Revised Oct 12, 1987 BDB

AUSTIN - BOWDEN ASSOCIATES

Bruce D. Bowden
704 North Main Street
Dodgeville, Wi. 53533
Phone(608) 935 - 5513

Larry L. Austin
Route 2, 4211 Hwy 81
Lancaster, Wi. 53813
Phone (608) 723-6363

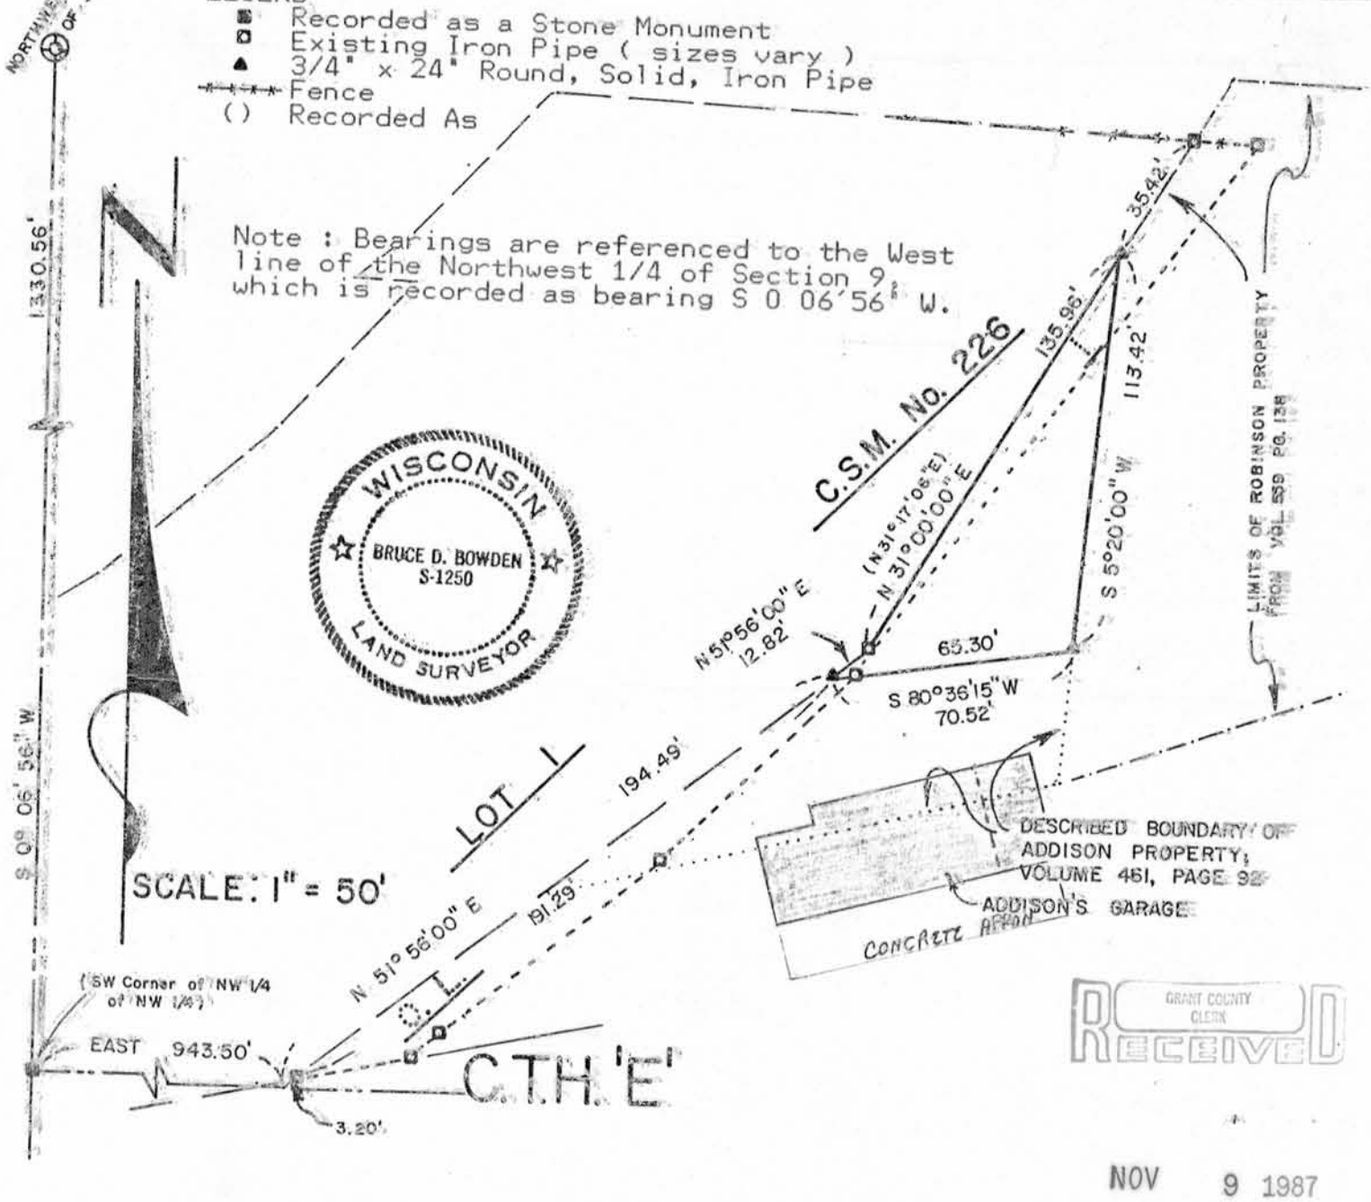

GRANT COUNTY CLERK
RECEIVED
NOV 9 1987