City of Boscobel **253**

JUN 14 1988

RECEIVED

0' 30' 60'

SCALE: 1" = 30'

PLAT OF SURVEY

Lot 10 And The West 15 Feet Of Lot 11 In Block 15 Of Parker's Addition To The City Of Boscobel. Grant County Wisconsin

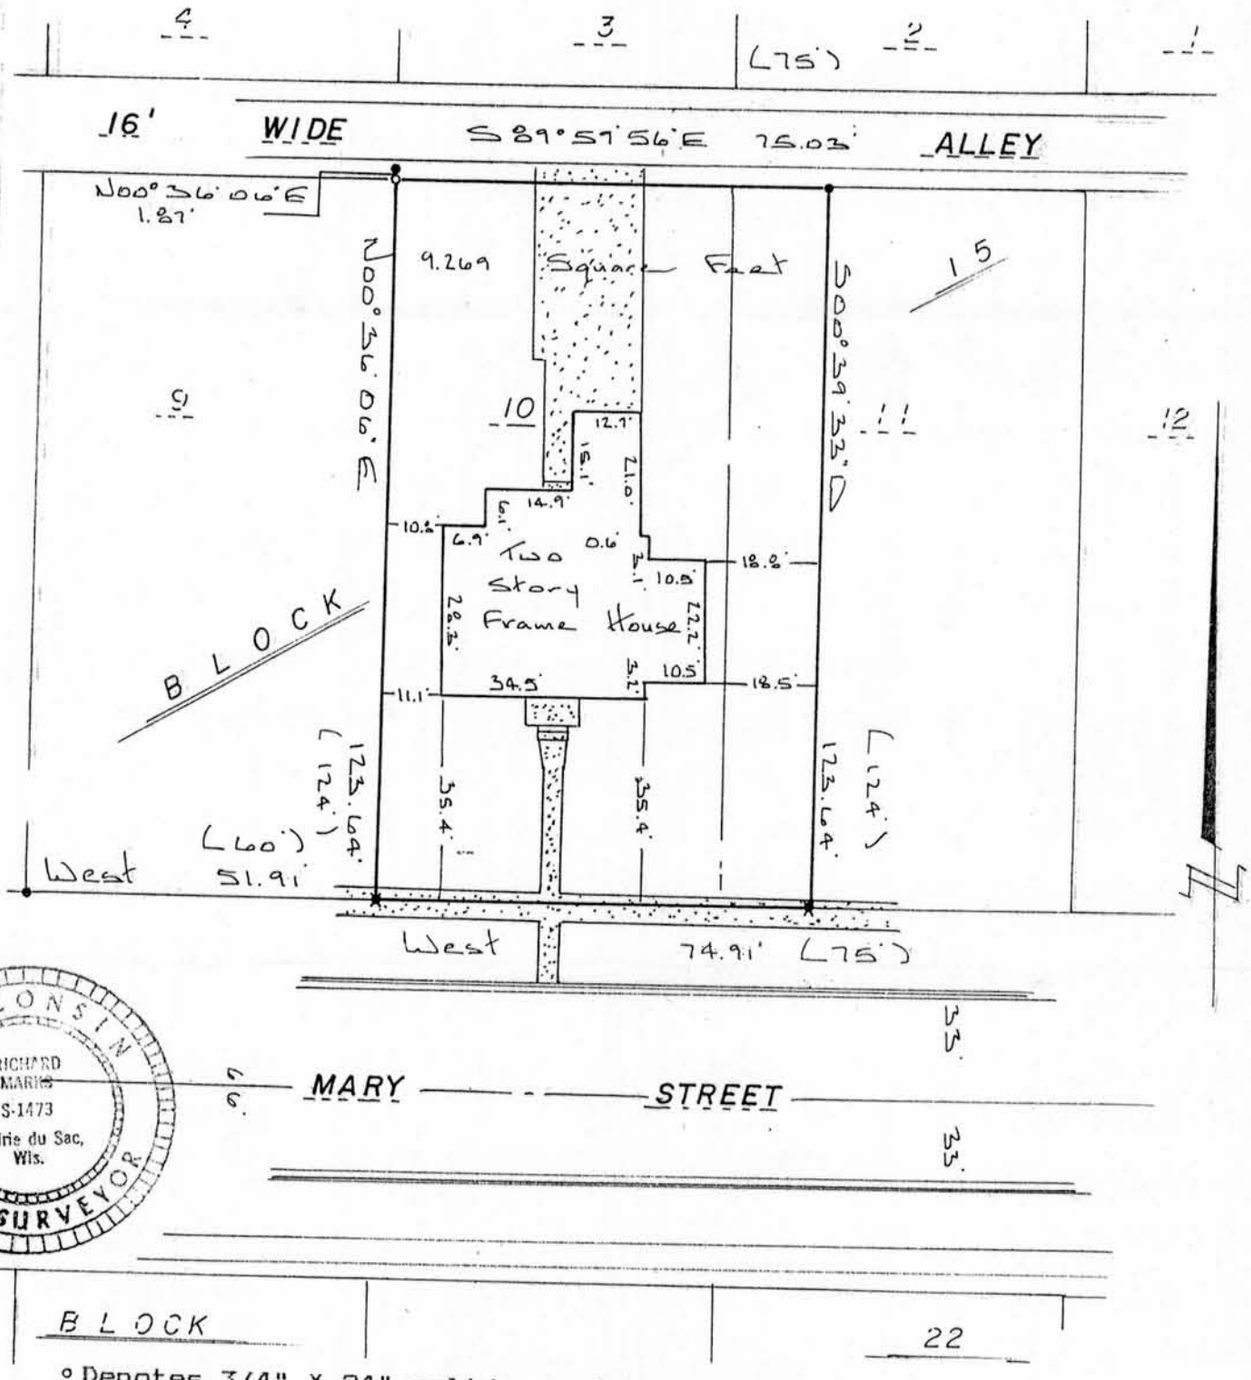

WISCONSIN RICHARD MARKS S-1473 Prairie du Sac, Wis. LAND SURVEYOR

° Denotes 3/4" X 24" solid round iron rod set.
•Denotes 1" iron pipe found (X indicates cross on sidewalk over pipe.)

When different "recorded as" distances are shown in parentheses.
Bearings are referenced to the South line of Lots 9, 10 and 11, Block 15 of Parker's Addition, assumed to bear West.

SURVEYOR'S CERTIFICATE

I have surveyed the above described property and the map shown hereon is a true representation thereof and shows the size and location of the property, its exterior boundaries, location of all permanent structures thereon, apparent easements and public roadways and visible encroachments if any. This survey is made for the exclusive use of the present owners of the property and those who purchase, mortgage or guarantee the title thereto within one year from the date hereof. As to them I warrant the accuracy of said survey and map.

Dated this 6th day of June, 1988

Richard Marks
Prepared for:
Brian Kendall
209 1/2 Mary Street
Boscobel, Wisconsin

S-1473

River Valley Land Surveying

1502 LORI COURT
SAUK CITY, WISCONSIN 53583