49

APR 26 1989

RECEIVED

SURVEY PLAT

LEGAL DESCRIPTION: The East Half (E ½) of Lots One (1) and Two (2) and the East Half (E ½) of the North Half (N ½) of Lot Three (3), also twenty (20) feet off of the West end of Lots Ten (10) and Nine (9) and twenty (20) feet off of the West end of the North Half (N ½) of Lot Eight (8) all of said land being in Block Six (6) of the Original Plat of the Village (now City) of Lancaster, Grant County, Wisconsin. Said parcel located in Section 3, Town 4 North, Range 3 West.

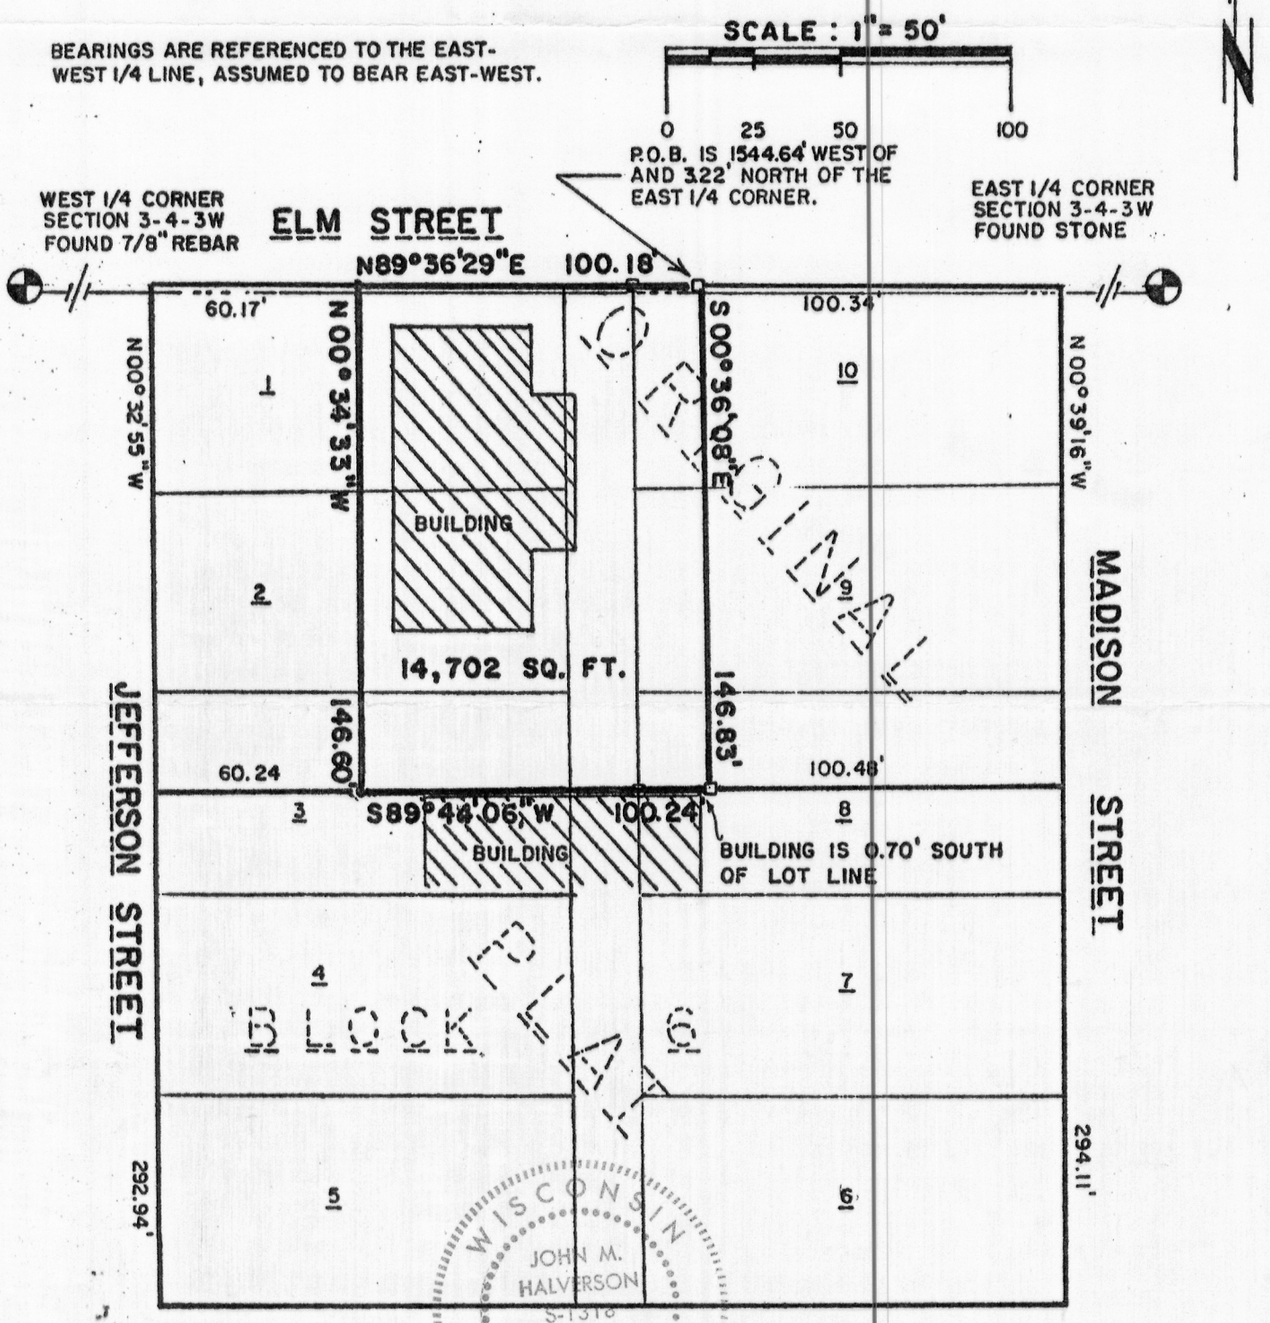

OWNER: RAYDON COMPANY
130 WEST ELM STREET
LANCASTER, WISCONSIN 53813

LEGEND AND NOTES

- ● SET 3/4" x 24" REBAR, MIN. WT. 1.50 LBS./LIN. FT.
- □ SET RAILROAD SPIKE

SURVEYOR'S CERTIFICATE:

I, John M. Halverson, Registered Land Surveyor, hereby certify that I have surveyed the above described parcel and that this map is a true and correct representation of the land surveyed to the best of my knowledge and belief.

December 22, 1988
Date

John M. Halverson
Registered Land Surveyor
Arena, Wisconsin 53503