NF 38

CERTIFIED SURVEY MAP

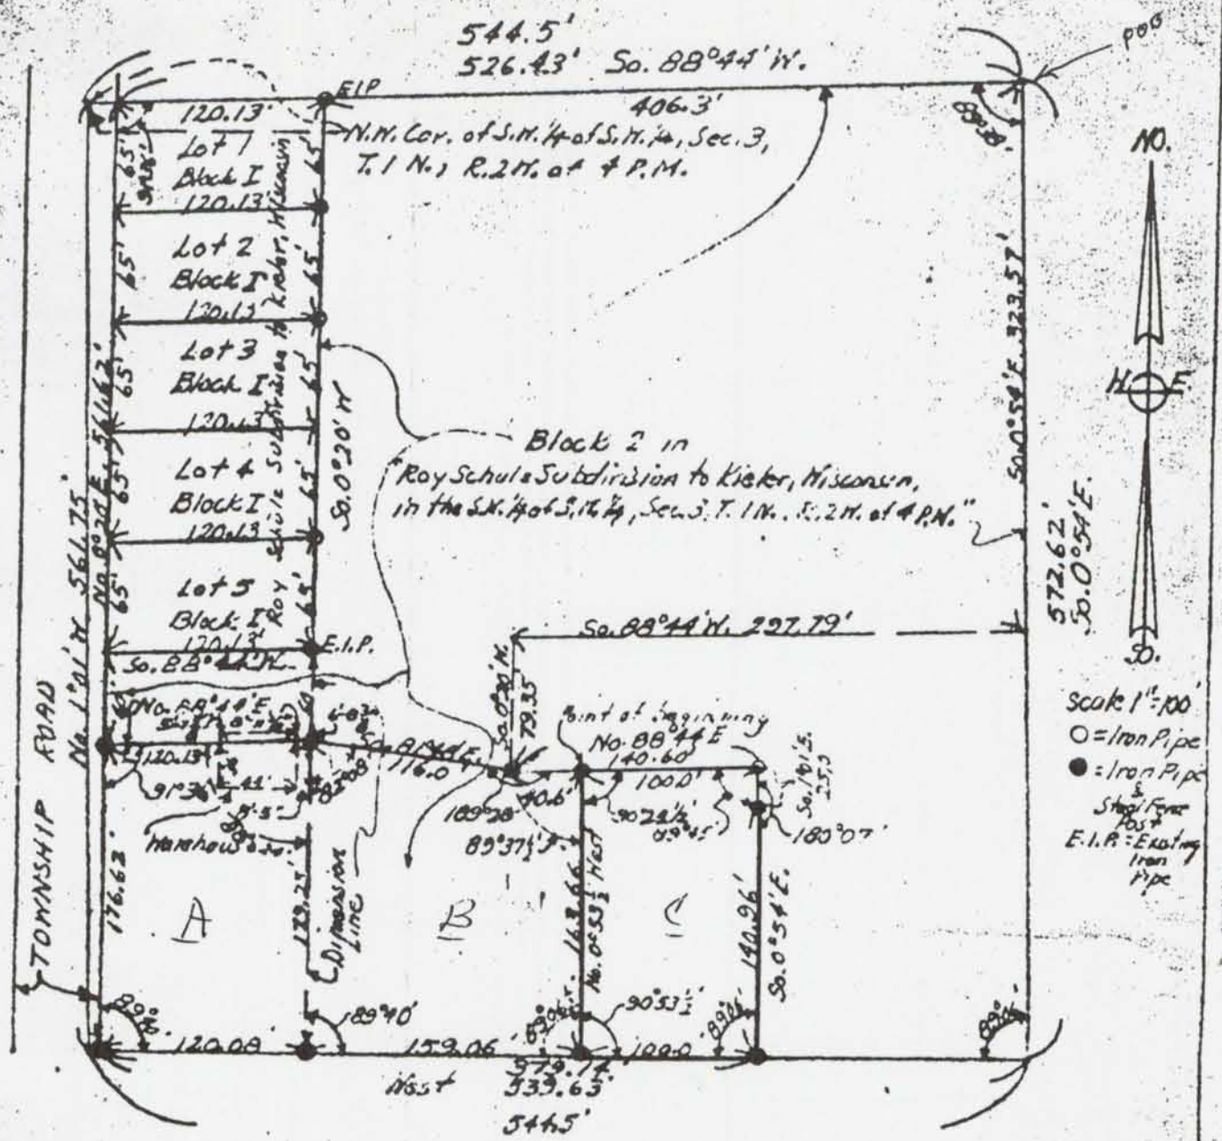

Dubuque, Iowa

June 24, 1968

I hereby certify the above is a true and correct plat of a part of Block Two (2) in Roy Schuls Subdivision to Kieler, Wisconsin, in the Southwest Quarter (S.W. 1/4) of the Southwest Quarter (S.W. 1/4) of Section Three (3), Township One (1) North, Range Two (2) West of the 4th Principal Meridian in Grant County, Wisconsin, described as follows:

Commencing at the Northeast corner of said Block Two (2), thence South 00° 54' East 323.57 feet, thence South 88° 44' West 297.79 feet, thence South 00° 20' West 79.35 feet, thence North 88° 44' East 40.6 feet, to the point of beginning, thence continuing North 88° 44' East 100.0 feet, thence South 01° 01' East 25 feet, thence South 00° 54' East 140.96 feet to the south line of said Block Two (2), thence Westerly along the south line of said Block Two (2) 100.0 feet, thence North 00° 53 1/2' West, 163.66 feet to the point of beginning, and is outlined in red, and is in full compliance with Section 236.34 of the 1967 Wisconsin Platting Statutes (as revised), and is as surveyed, platted and described by me, and is subject to easements of record.

Bartels, McMahan & LeMay Engineering Co.

By Carl F. Bartels

Carl F. Bartels
Registered Land Surveyor
Wisconsin License No. S - 95

FABER PUNDT (2)