


Jamestown Township  
 Sec 21 - T11N - R2W

Michael Hopkins  
 Survey  
 (Sold off in 5 parcels)  
 (3 comp pcts)


 This Survey  
 Done

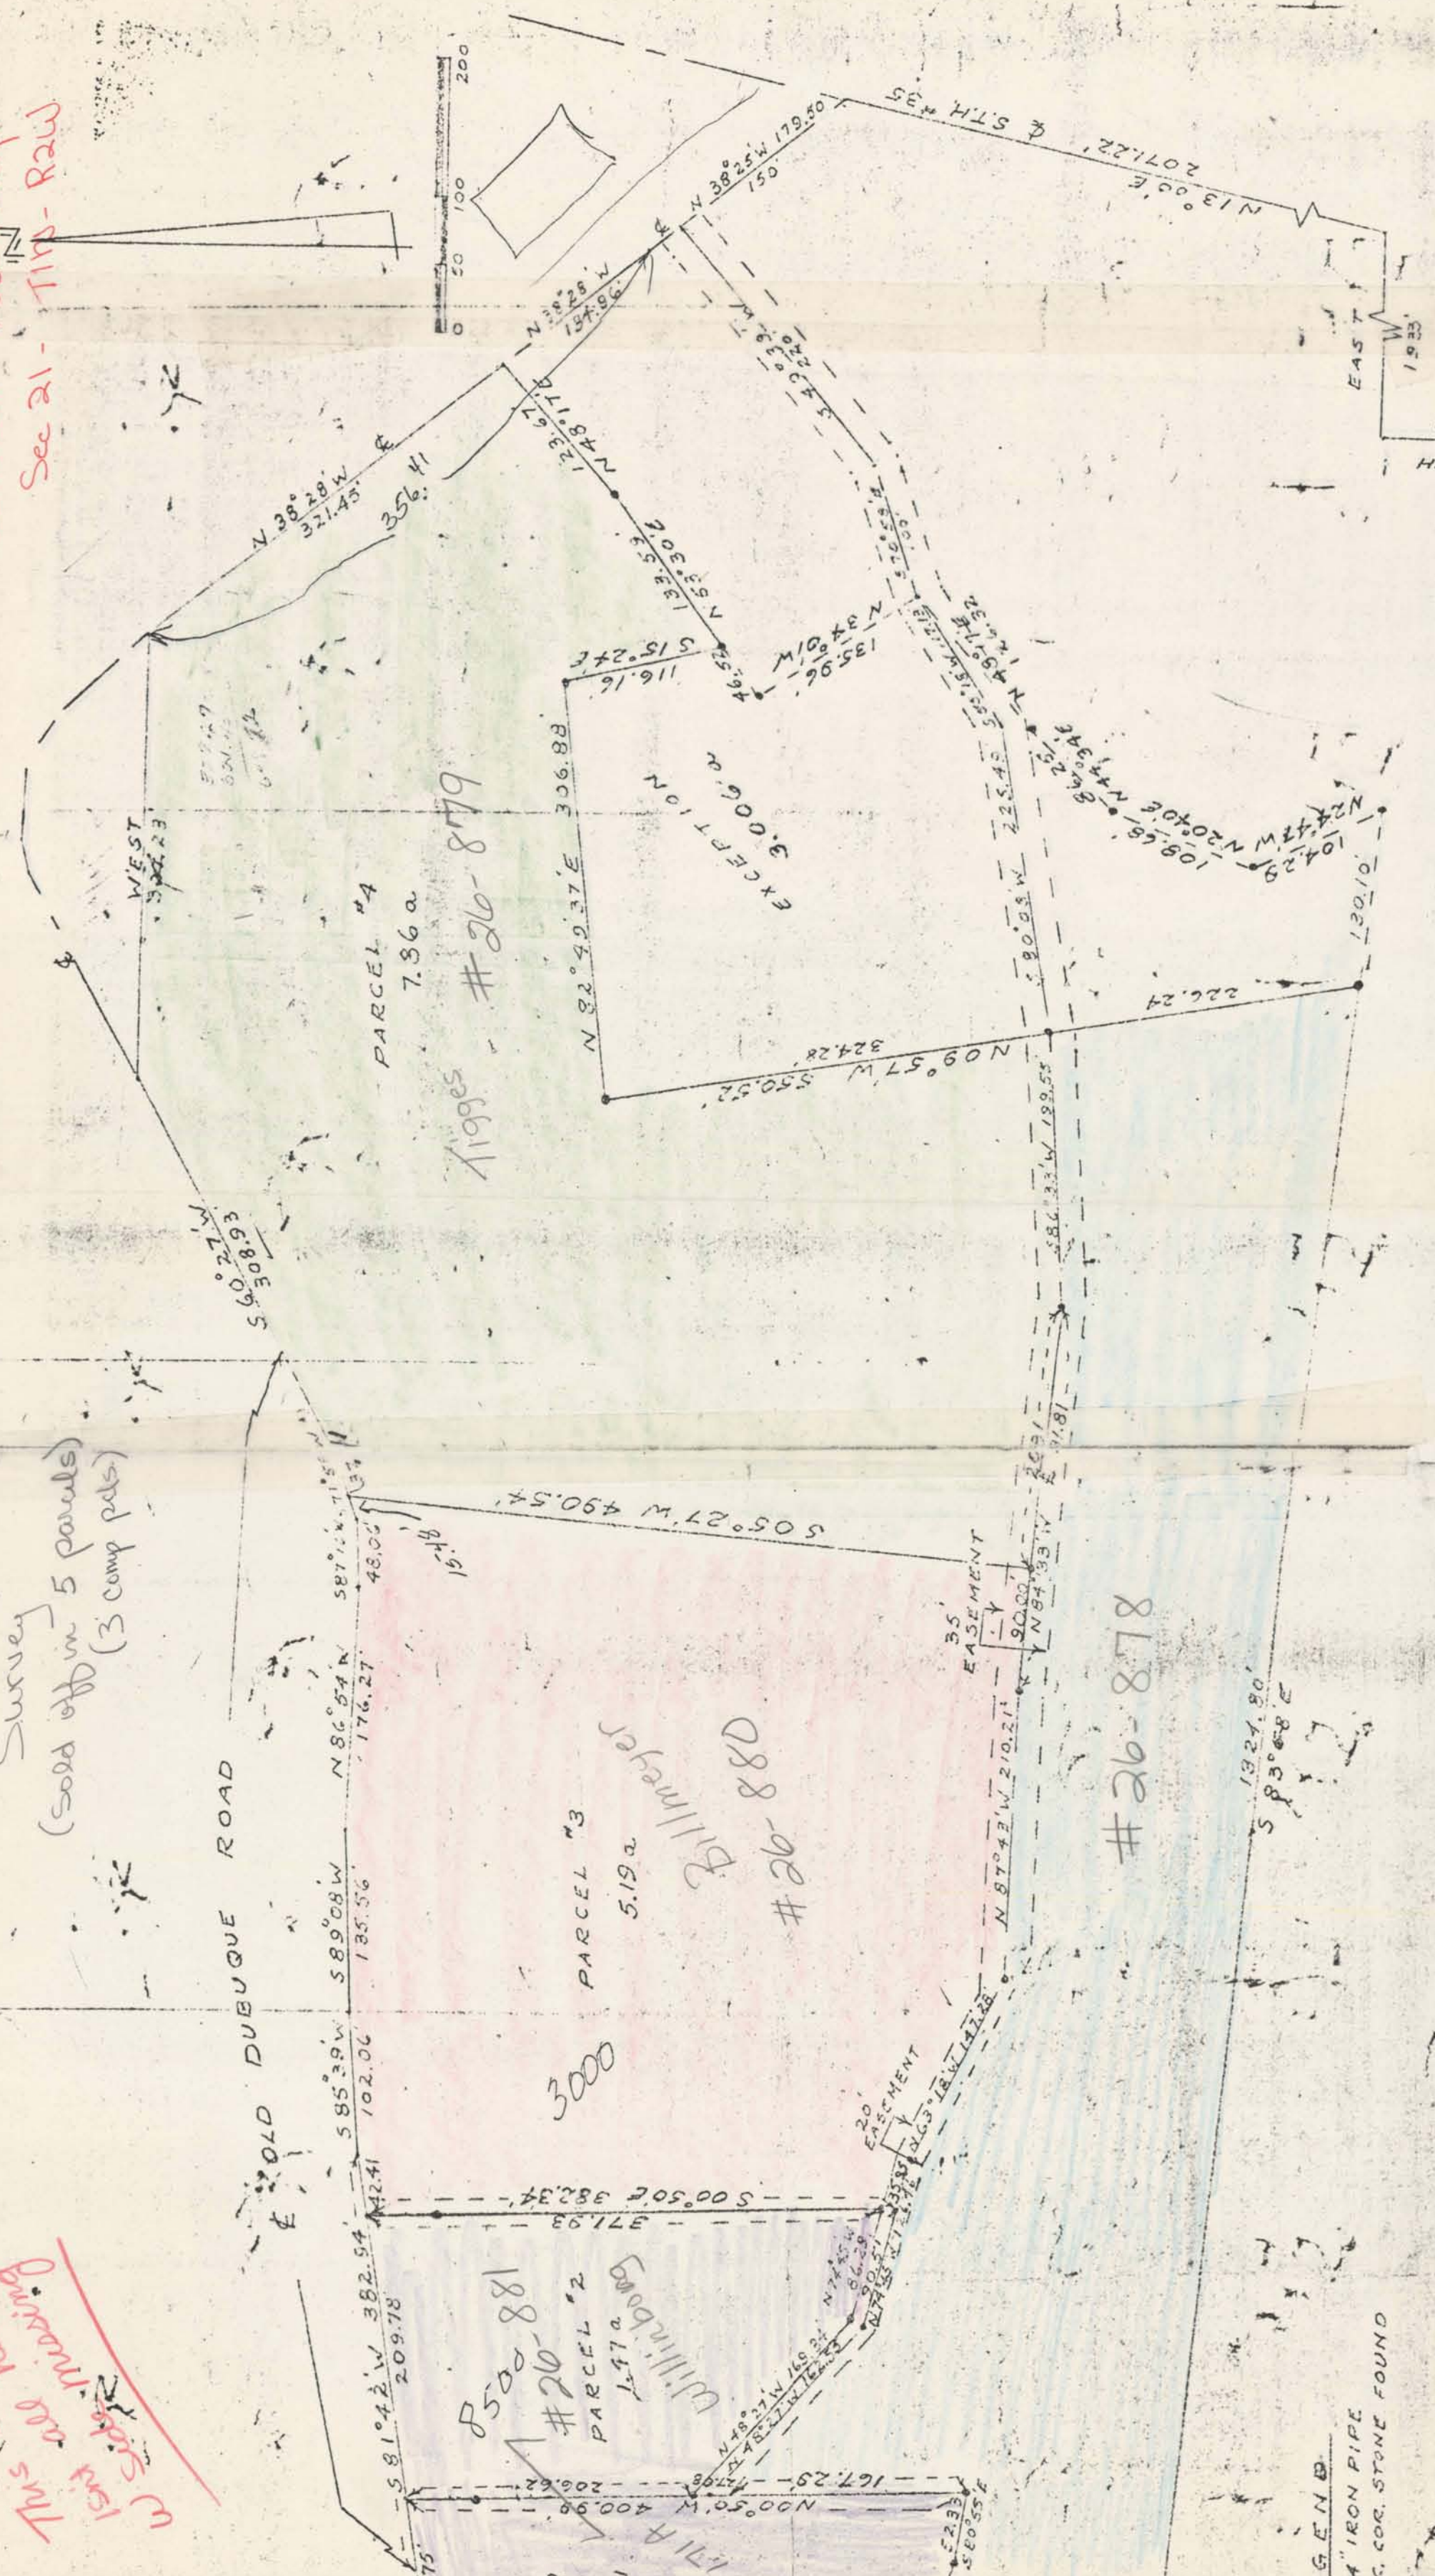

11965 - #26-879

Billmeyer  
 #26-880

#26-878

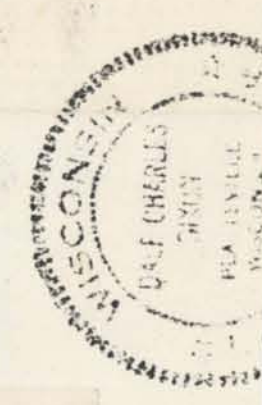


MICHAEL HOPKINS PROPERTY

GENB  
 4" IRON PIPE  
 S. COG. STONE FOUND