


NF 451

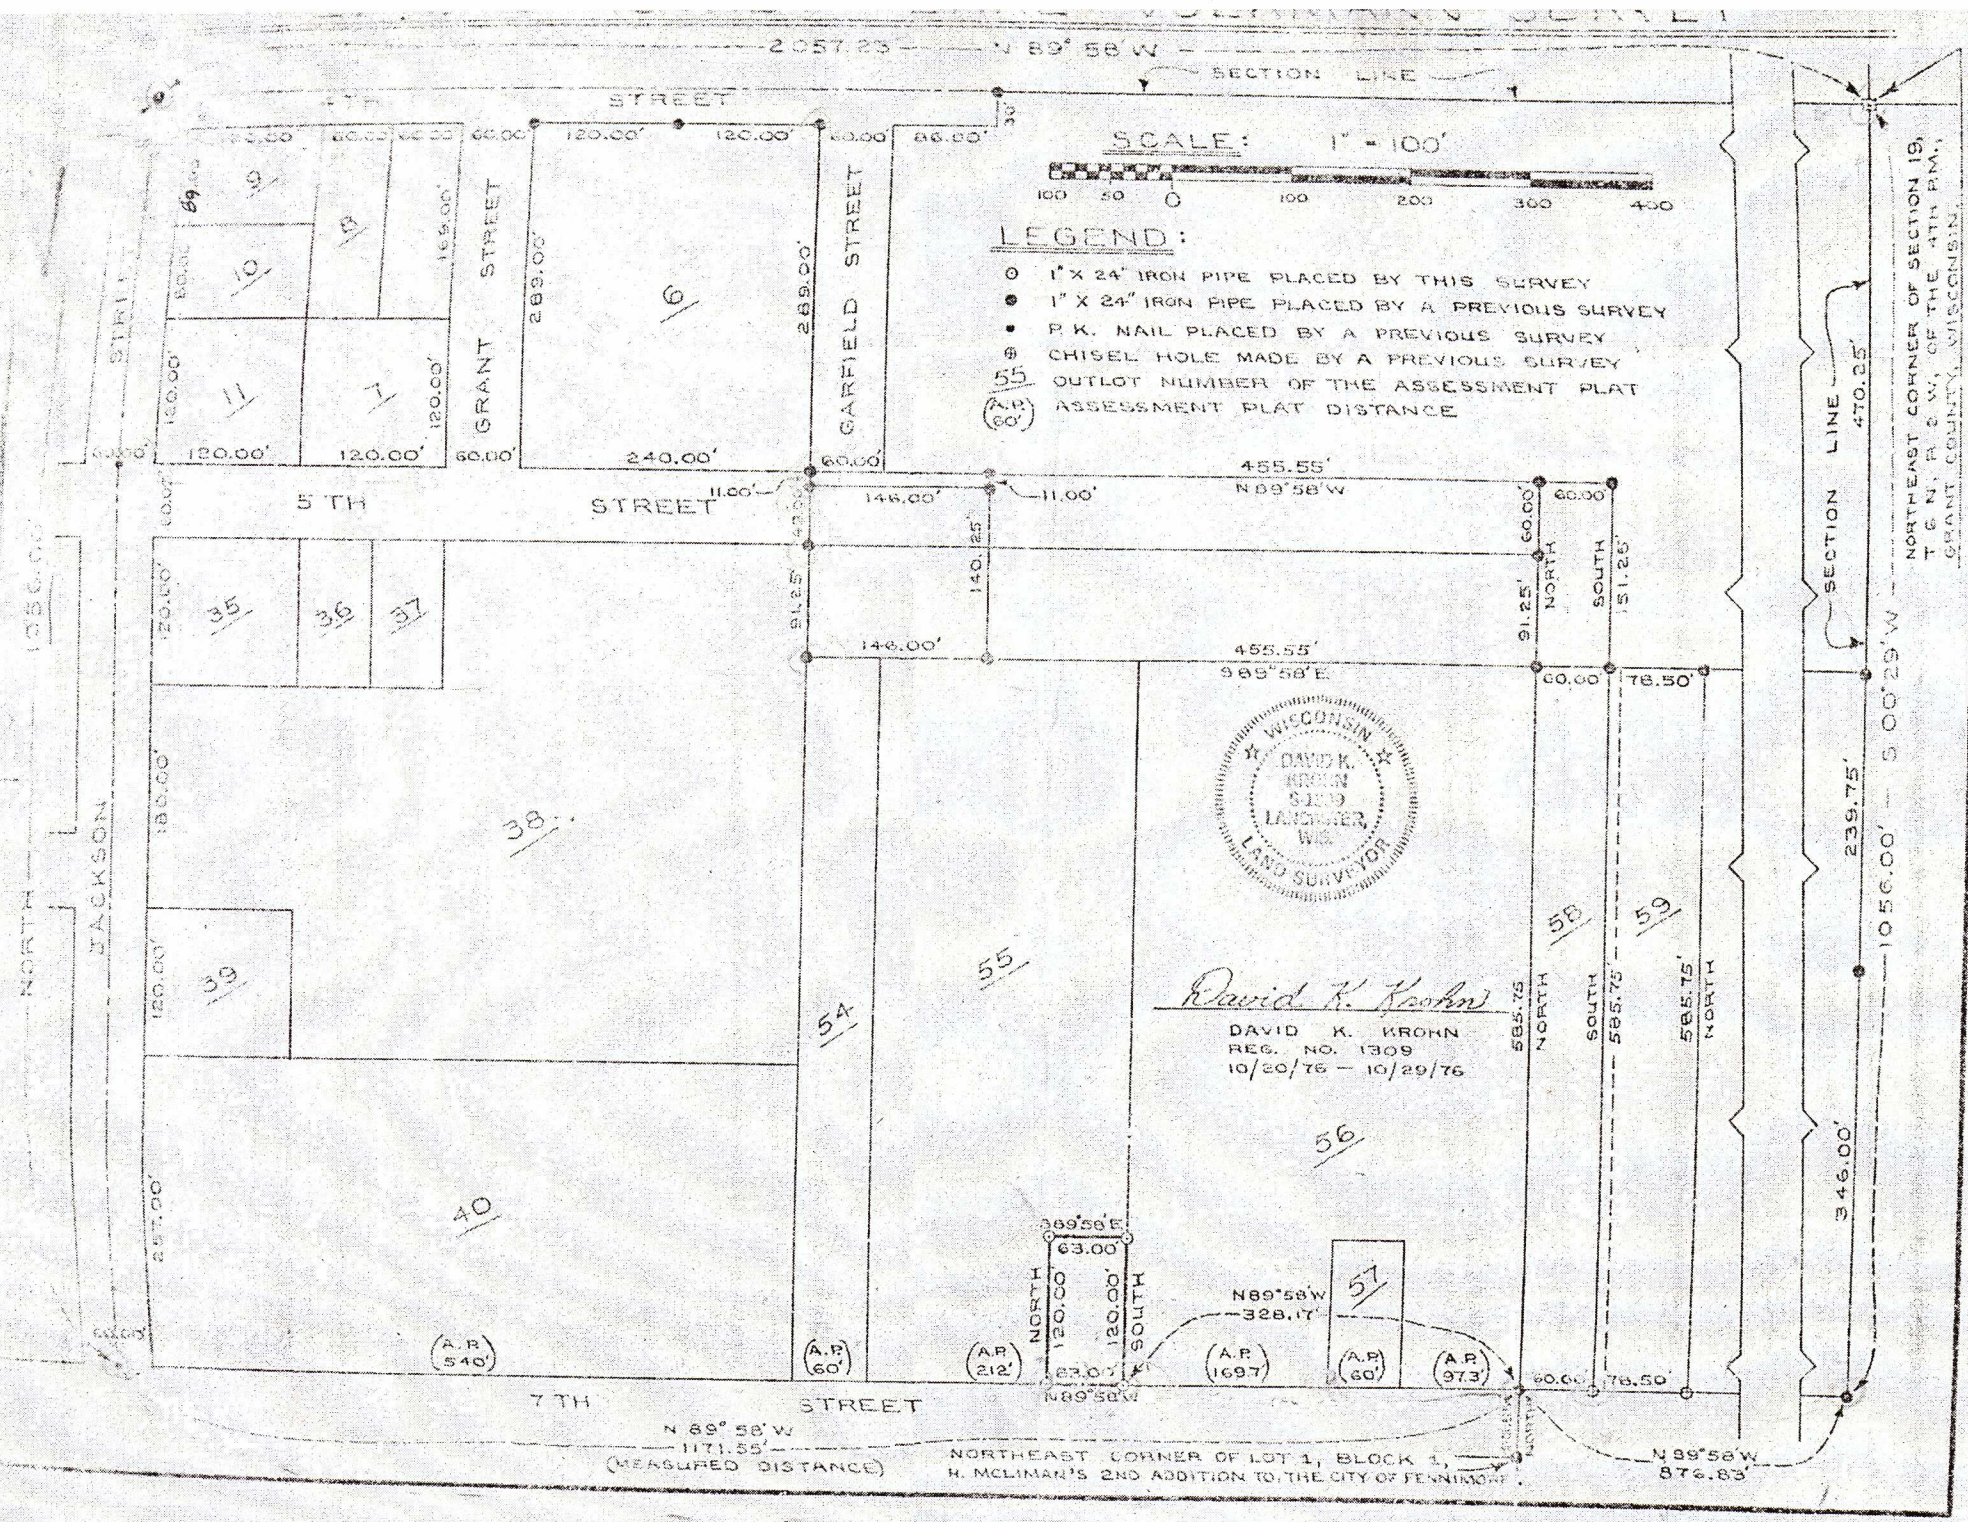

FILENAME: KROHN76