

PLAT OF SURVEY

DEED DESCRIPTION OF PARCEL A:
 BEGINNING ON A LINE BETWEEN THE EAST ONE HALF AND THE WEST ONE HALF OF THE NORTHEAST QUARTER OF SECTION 25, TOWNSHIP 11N, RANGE 10E, COUNTY OF WISCONSIN, MORE PARTICULARLY DESCRIBED AS FOLLOWS:
 THE NORTHEAST QUARTER OF SAID SECTION 25, THENCE NORTH 89°24'01" E, THENCE EAST 130 FEET, THENCE SOUTH PARALLEL WITH SAID FIRST LINE 262 FEET, TO A POINT DUE EAST OF THE PLACE OF BEGINNING, THENCE WEST 330 FEET TO A PLACE OF BEGINNING.

SURVEYED DESCRIPTION OF PARCEL A:
 PART OF THE EAST HALF OF THE NORTHEAST QUARTER OF SECTION 25, TOWNSHIP 11N, RANGE 10E, COUNTY OF WISCONSIN, MORE PARTICULARLY DESCRIBED AS FOLLOWS:
 COMMENCING AT THE EAST ONE-QUARTER OF SAID SECTION 25, THENCE SOUTH 89°24'01" WEST, 1318.095 FEET ALONG THE EAST-WEST ONE-QUARTER LINE TO THE SOUTHWEST CORNER OF THE EAST HALF OF THE NORTHEAST QUARTER, THENCE NORTH 89°24'01" EAST, 261.



SURVEYED DESCRIPTION OF PARCEL B:
 PART OF THE EAST HALF OF THE NORTHEAST QUARTER OF SECTION 25, TOWNSHIP 11N, RANGE 10E, COUNTY OF WISCONSIN, MORE PARTICULARLY DESCRIBED AS FOLLOWS:


SURVEYED DESCRIPTION OF PARCEL C AS SHOWN ON CURRIEN'S SURVEY:
 PART OF THE SE 1/4 OF THE NE 1/4 OF SECTION 25, TOWNSHIP 11N, RANGE 10E, COUNTY OF WISCONSIN, MORE PARTICULARLY DESCRIBED AS FOLLOWS:

 SAID PARCEL CONTAINS 0.18 ACRES MORE OR LESS AND IS SUBJECT TO ANY EASEMENTS OF RECORD.

THE NORTH ONE-QUARTER CORNER OF SEC. 25-T11N-R10W

THE NORTH LINE OF THE NORTHEAST QUARTER OF SECTION 25


THE NORTHEAST CORNER OF SEC. 25-T11N-R10W

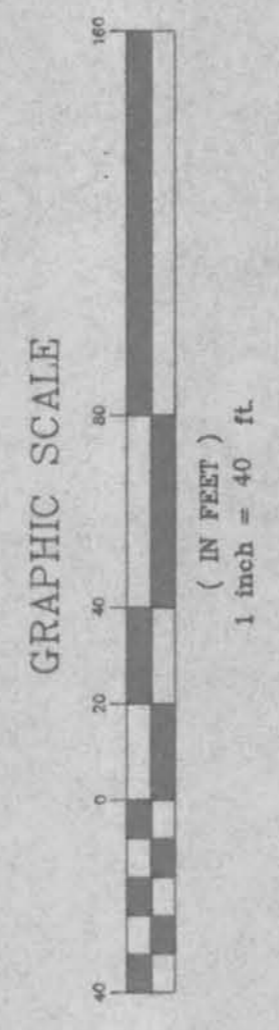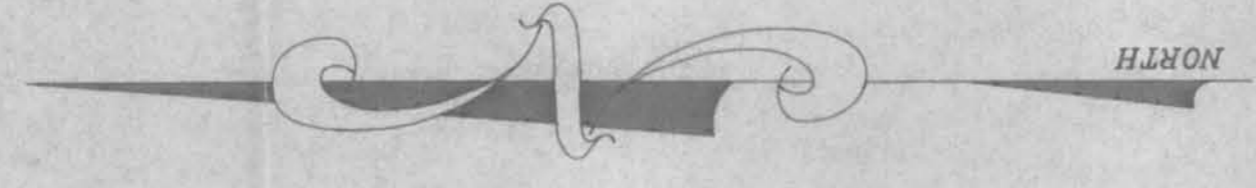

ALL BEARINGS ARE REFERENCED TO THE NORTH LINE OF THE NORTHEAST QUARTER OF SECTION 25-T11N-R10W, WHICH IS ASSUMED TO BEAR NORTH 89°24'01" EAST.

LEGEND

- FOUND IRON PIPE
- FOUND IRON ROD
- △ FOUND ROD W/ALUM CAP
- ⊕ FENCE POST
- ☼ EVERGREEN TREE
- ⊗ SHRUB
- ⊙ TREE
- ▨ LILAC BUSHES
- SURVEYED LINES
- SECTION LINES
- 0.00' MEASURED DISTANCE/BEARING
- (0.00) RECORDED DISTANCE/BEARING

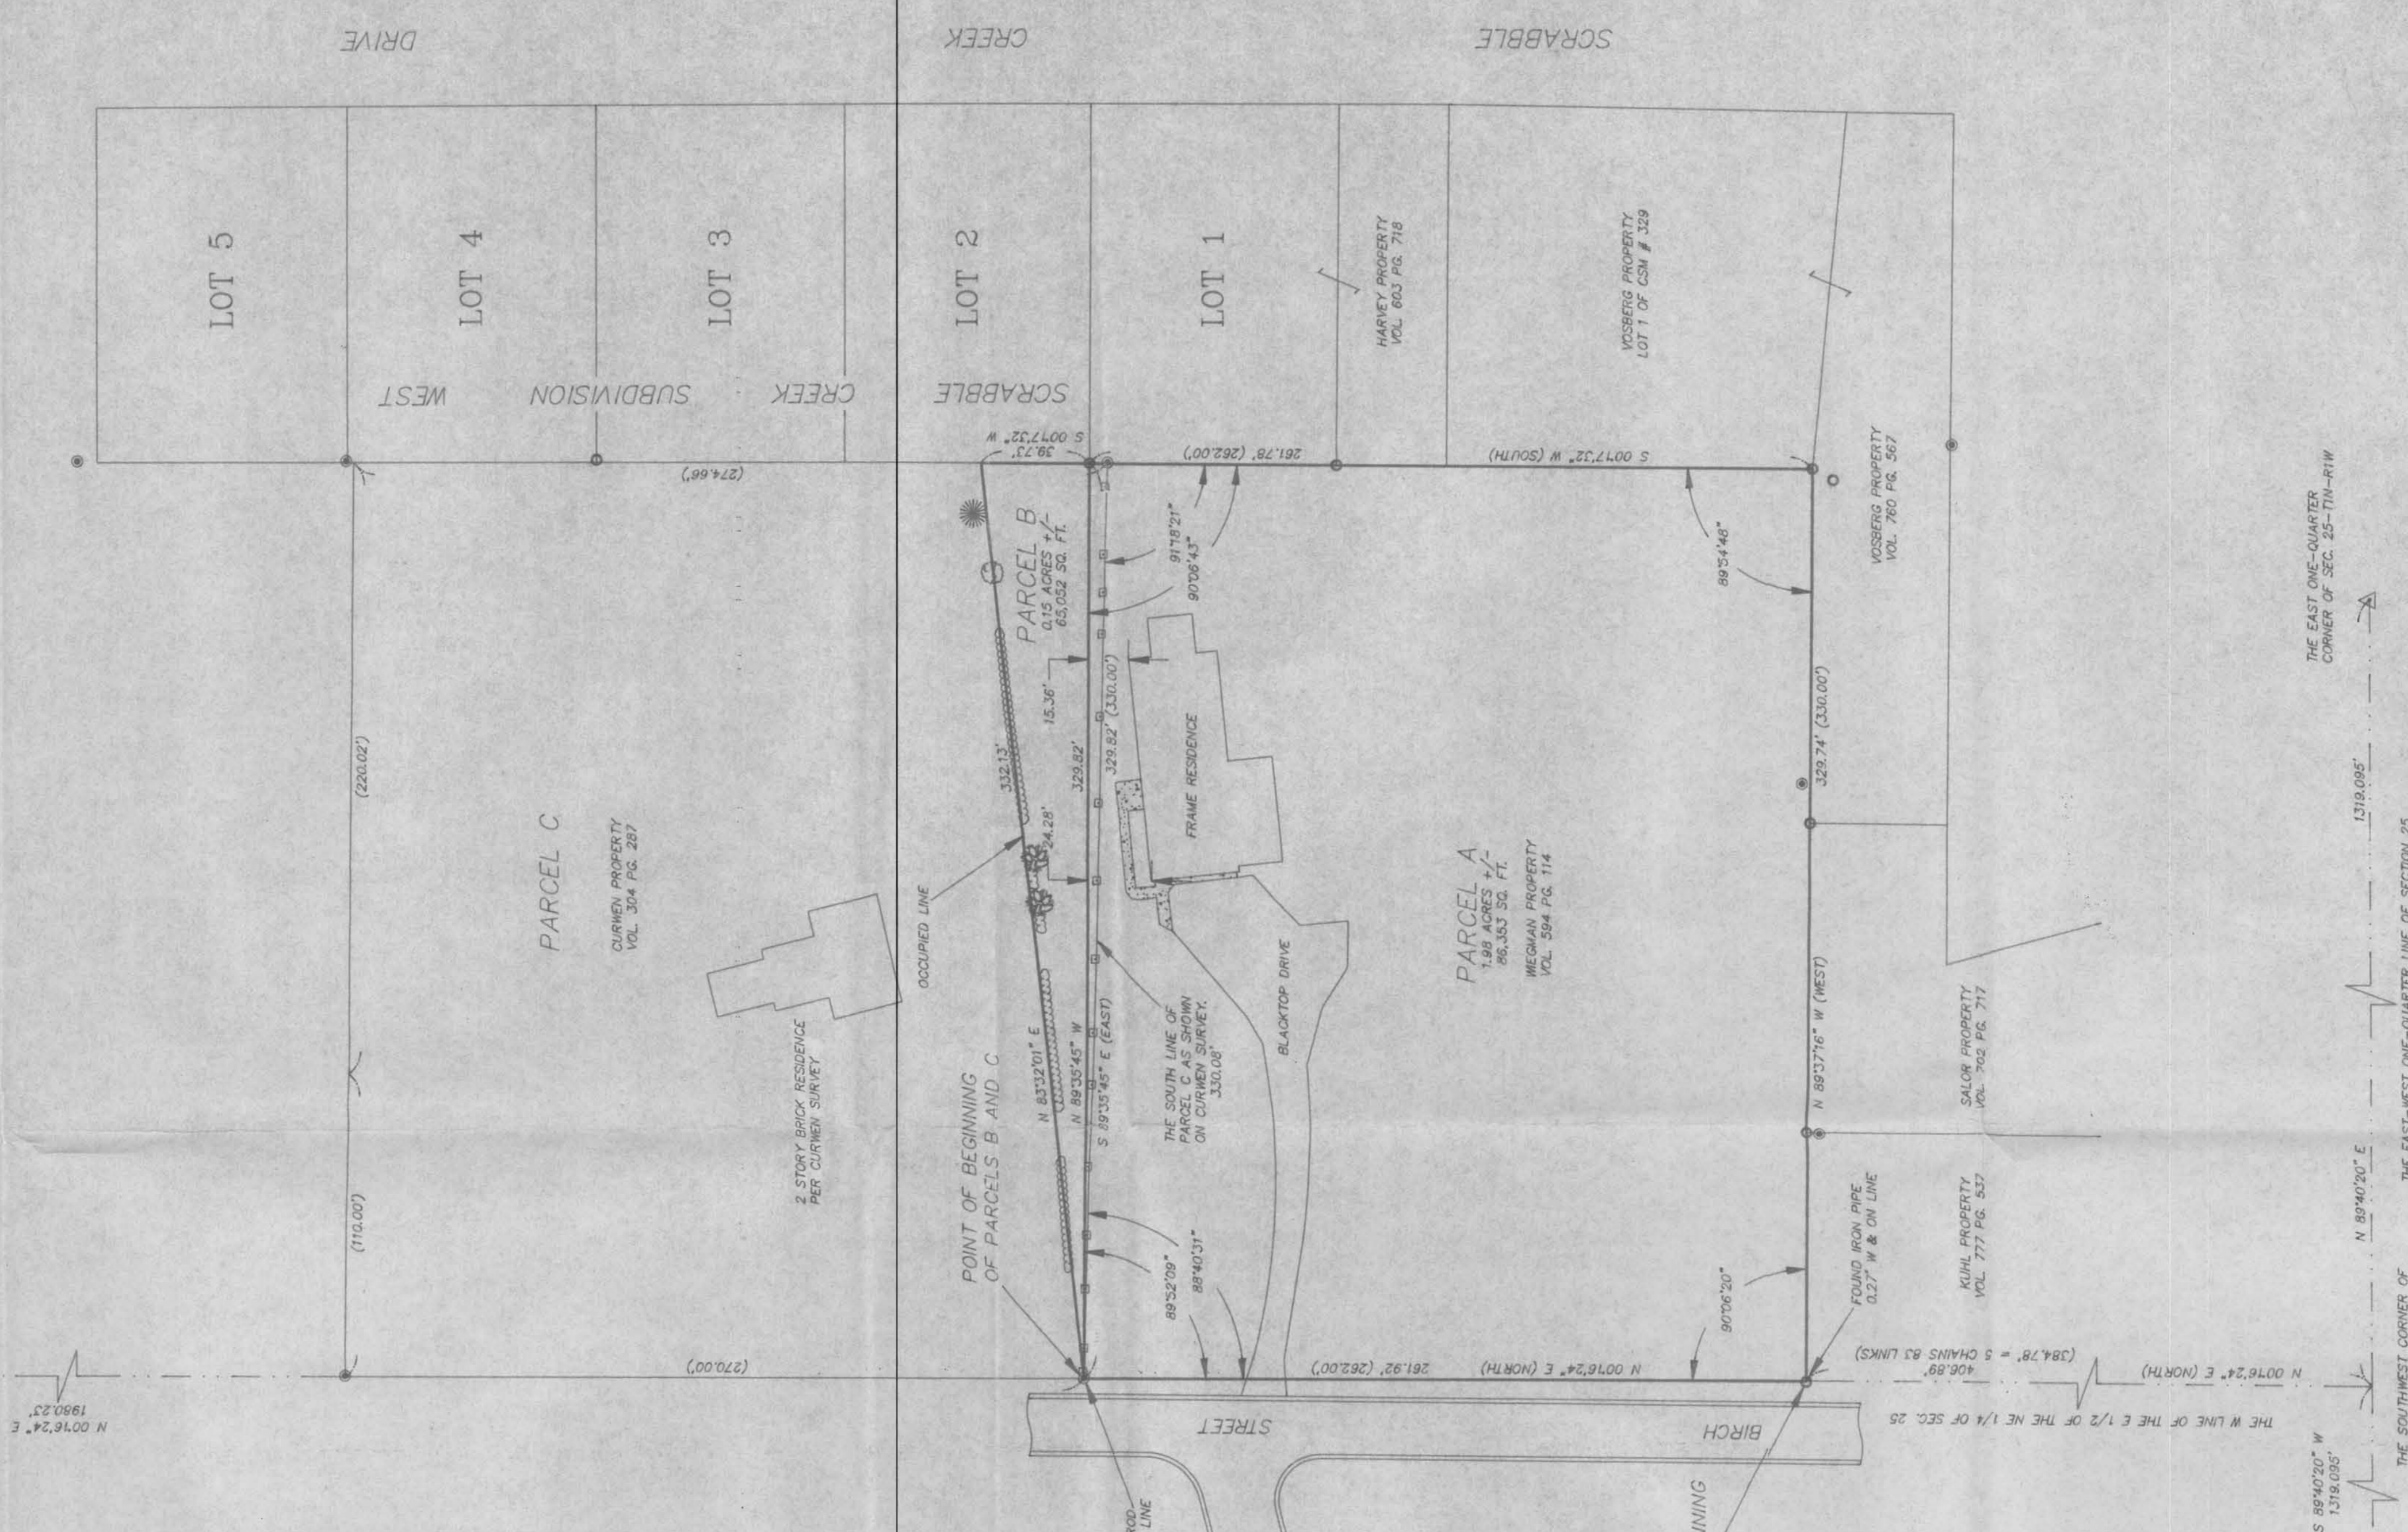

THE WEST ONE-QUARTER CORNER OF SEC. 25-T11N-R10W

THE CENTER ONE-QUARTER CORNER OF SECTION 25-T11N-R10W

THE SOUTHWEST CORNER OF THE NORTHEAST QUARTER OF SECTION 25-T11N-R10W

THE EAST-WEST ONE-QUARTER LINE OF SECTION 25


JOB #	960320	DATE	12/19/98	TOTAL SHEETS	1/1	PREPARED FOR	WIEGMAN
DRAWN BY	S.L.R.	SCALE	1"=40'				7605 NORTH MERIDIAN ROAD GALENA, ILLINOIS, 61036
DATE	12/19/98						815 7771-3538



I, THOMAS L. BUCK, A REGISTERED LAND SURVEYOR IN THE STATE OF WISCONSIN, DO HEREBY CERTIFY THAT I HAVE SURVEYED, MAPPED AND MONUMENTED THE ABOVE DESCRIBED PARCELS AND THAT THIS IS A CORRECT REPRESENTATION OF THE LAND SURVEYED TO THE BEST OF MY KNOWLEDGE AND BELIEF.
 THOMAS L. BUCK RLS 2-2129

