BOOK 10 PAGE 92

PLAT OF SURVEY

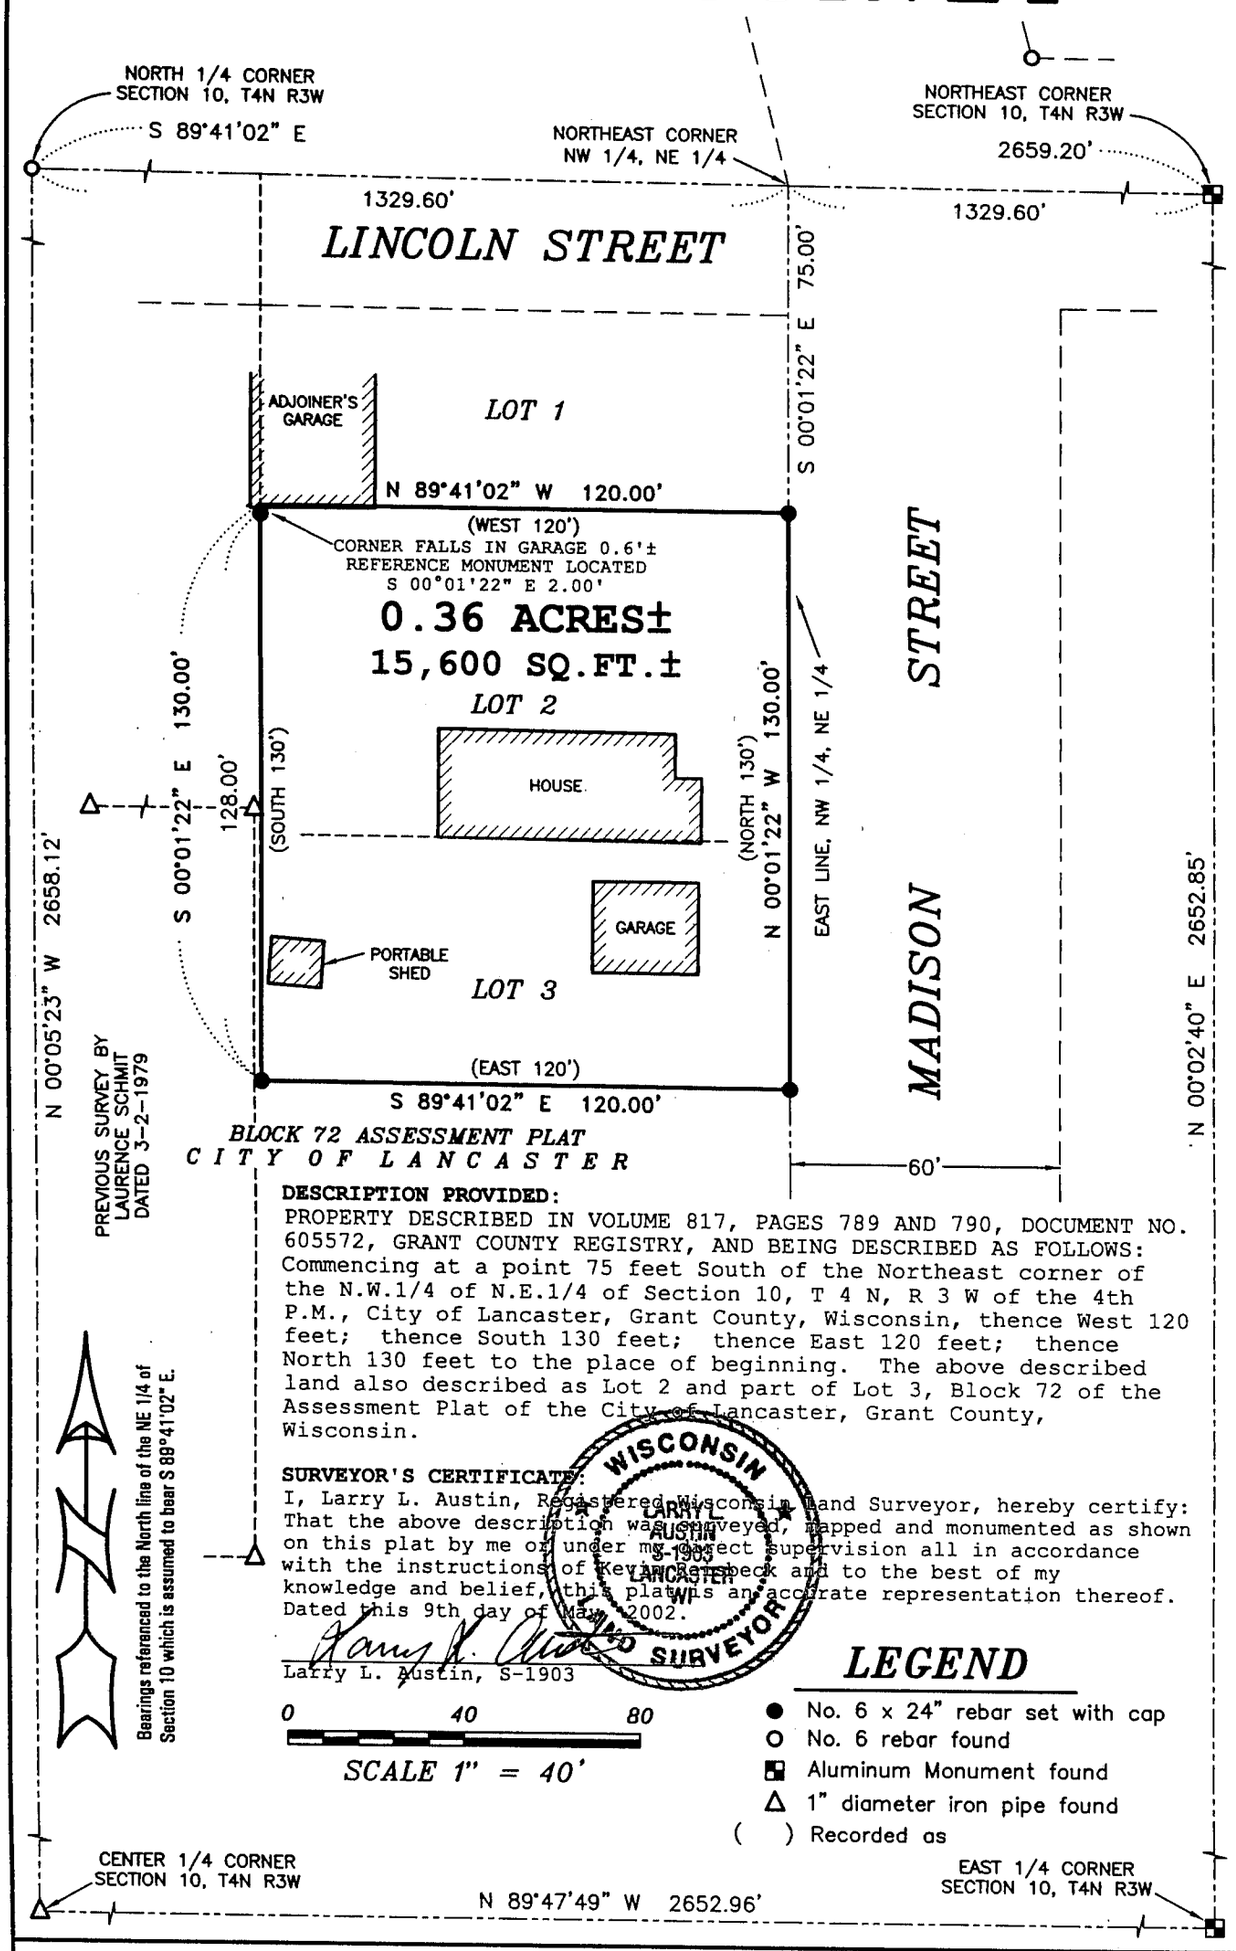

DESCRIPTION PROVIDED:
PROPERTY DESCRIBED IN VOLUME 817, PAGES 789 AND 790, DOCUMENT NO. 605572, GRANT COUNTY REGISTRY, AND BEING DESCRIBED AS FOLLOWS: Commencing at a point 75 feet South of the Northeast corner of the N.W.1/4 of N.E.1/4 of Section 10, T 4 N, R 3 W of the 4th P.M., City of Lancaster, Grant County, Wisconsin, thence West 120 feet; thence South 130 feet; thence East 120 feet; thence North 130 feet to the place of beginning. The above described land also described as Lot 2 and part of Lot 3, Block 72 of the Assessment Plat of the City of Lancaster, Grant County, Wisconsin.

SURVEYOR'S CERTIFICATE:
I, Larry L. Austin, Registered Wisconsin Land Surveyor, hereby certify: That the above description was surveyed, mapped and monumented as shown on this plat by me or under my direct supervision all in accordance with the instructions of Kevin Raisbeck and to the best of my knowledge and belief, this plat is an accurate representation thereof. Dated this 9th day of May, 2002.

Larry L. Austin, S-1903

WISCONSIN LARRY L. AUSTIN S-1903 LANCASTER WI REGISTERED LAND SURVEYOR

LEGEND

- ● No. 6 x 24" rebar set with cap
- O No. 6 rebar found
- ■ Aluminum Monument found
- △ 1" diameter iron pipe found
- ( ) Recorded as

Prepared For: KEVIN RAISBECK

AUSTIN ENGINEERING, LLC
4211 HWY 81 E, LANCASTER, WI 53813
PHONE 608-723-6363 FAX 608-723-6702

FIELDBOOK: 2033
G:\T4NR3W\10A
C:\AJA\LANCASTER\AP\BLOCK72\RAISBECK

DRAWN BY: AJ AUSTIN
APPROVED: LL AUSTIN
CREW: BS – SB

SHEET 1 OF 1