BOOK 11 PAGE 52

PLAT OF SURVEY

O.P. FENNIMORE

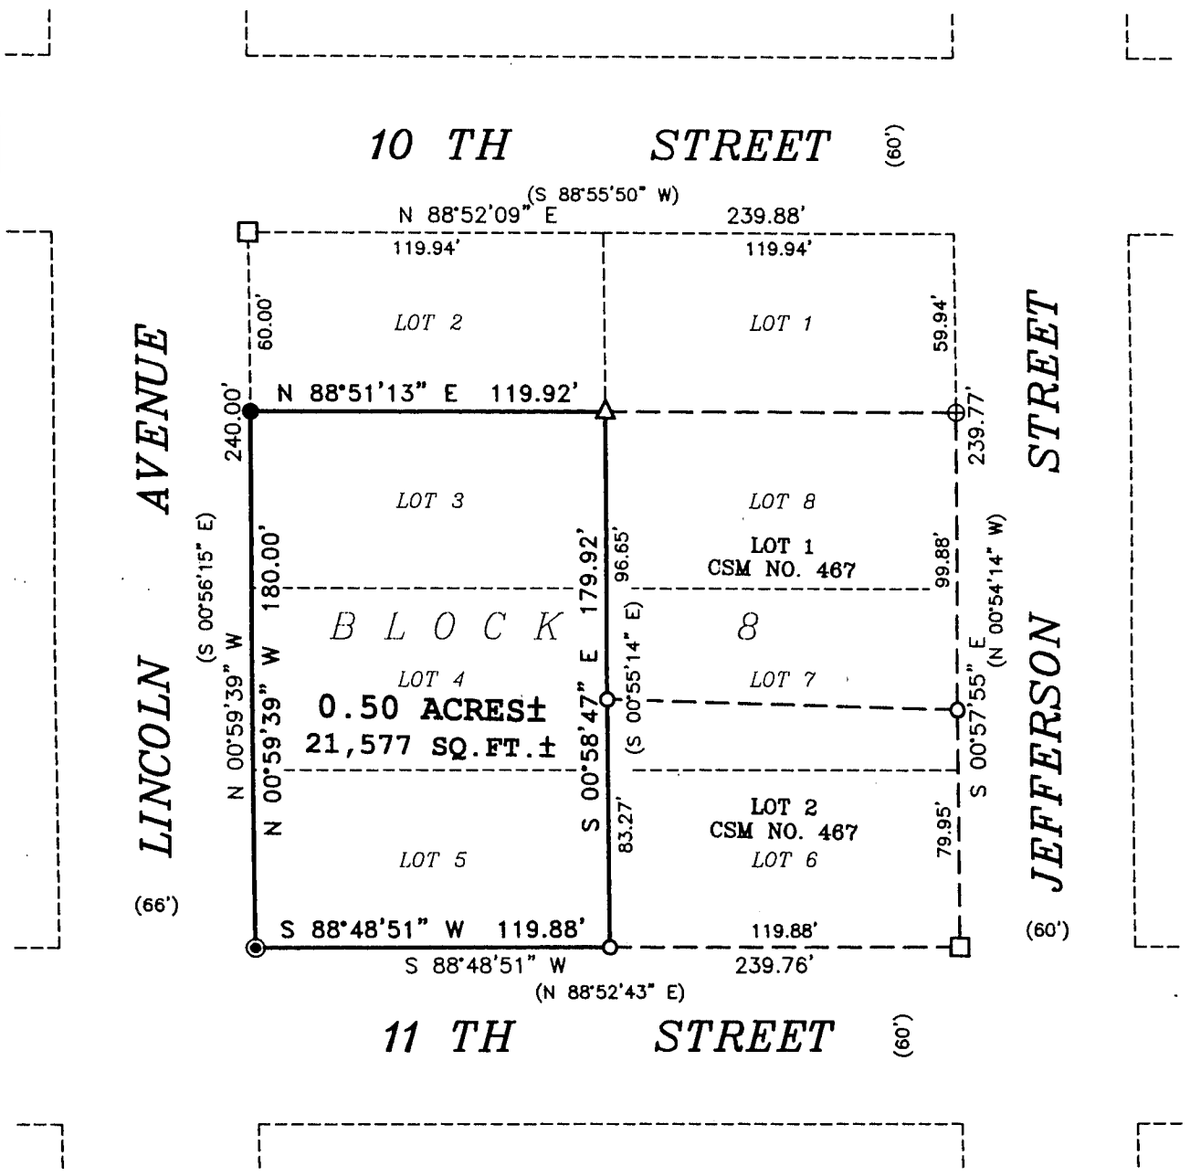

LEGEND

- ☐ No. 10 rebar found
- ⊕ Brass "Survey Mark" plug found
- △ 1" diameter iron pipe found
- ○ No. 6 rebar found
- ● No. 6 x 24" rebar set with cap – wt=1.50 #/l.f.
- ◉ 1/4" diameter drill hole placed in concrete
- ( ) Recorded as

Bearings referenced to the South line of Block 8 of the Original Plat of the City of Fennimore which is assumed to bear S 88°48'51" W.

ALL PLANS THAT DO NOT SHOW A SEAL IMPRINT IN RED INK MAY CONTAIN UNAUTHORIZED ALTERATIONS. THE CERTIFICATION CONTAINED ON THIS DOCUMENT SHALL NOT APPLY TO ANY COPIES.
DATED THIS 31ST DAY OF JULY, 2002.

WISCONSIN LARRY L. AUSTIN S-1903 LANCASTER WI LAND SURVEYOR

0 60 120
SCALE 1" = 60'

Prepared For: TED SCHACHT

AUSTIN ENGINEERING, LLC
4211 HWY 81 E, LANCASTER, WI 53813
PHONE 608-723-6363 FAX 608-723-6702

FIELDBOOK: 2229
G:\FENNMORE\OP02
C:\AJA\FENNMORE\OP\BLOCK8\SCHACHT-BOUNDARY

DRAWN BY: AJ AUSTIN
APPROVED: LL AUSTIN
CREW: SB – BD

SHEET 1 OF 2

AUG 21 2002