Book 12 Page 93

Plat of Survey for Kirsten Kisgen

of Lots 10 and 11 of Block 4 of Dieter & Eastman's Addition to the Village of Montfort, together with one half of the adjacent vacated twenty foot alleys, all in the Southeast ¼ of the Northeast ¼ of Section 25, Town 6 North, Range 1 West, Grant County, WI.

I, Bruce D. Bowden, R.L.S. - 1250, representative of Bowden Surveying, Ltd., do hereby certify that I have surveyed, mapped and monumented the property shown hereon in accordance with the instructions of Kirsten Kisgen and that this map is a correct representation thereof to the best of my knowledge and belief.

Bruce D. Bowden, R.L.S. - 1250 Date May 7, 2003

WISCONSIN BRUCE D. BOWDEN S-1250 DODGEVILLE WI. LAND SURVEYOR

If this stamp is not red colored and the surveyor's signature is not in blue ink, the map should be assumed to be a copy and may contain unauthorized alterations. The certificate shown hereon shall not apply to any copies.

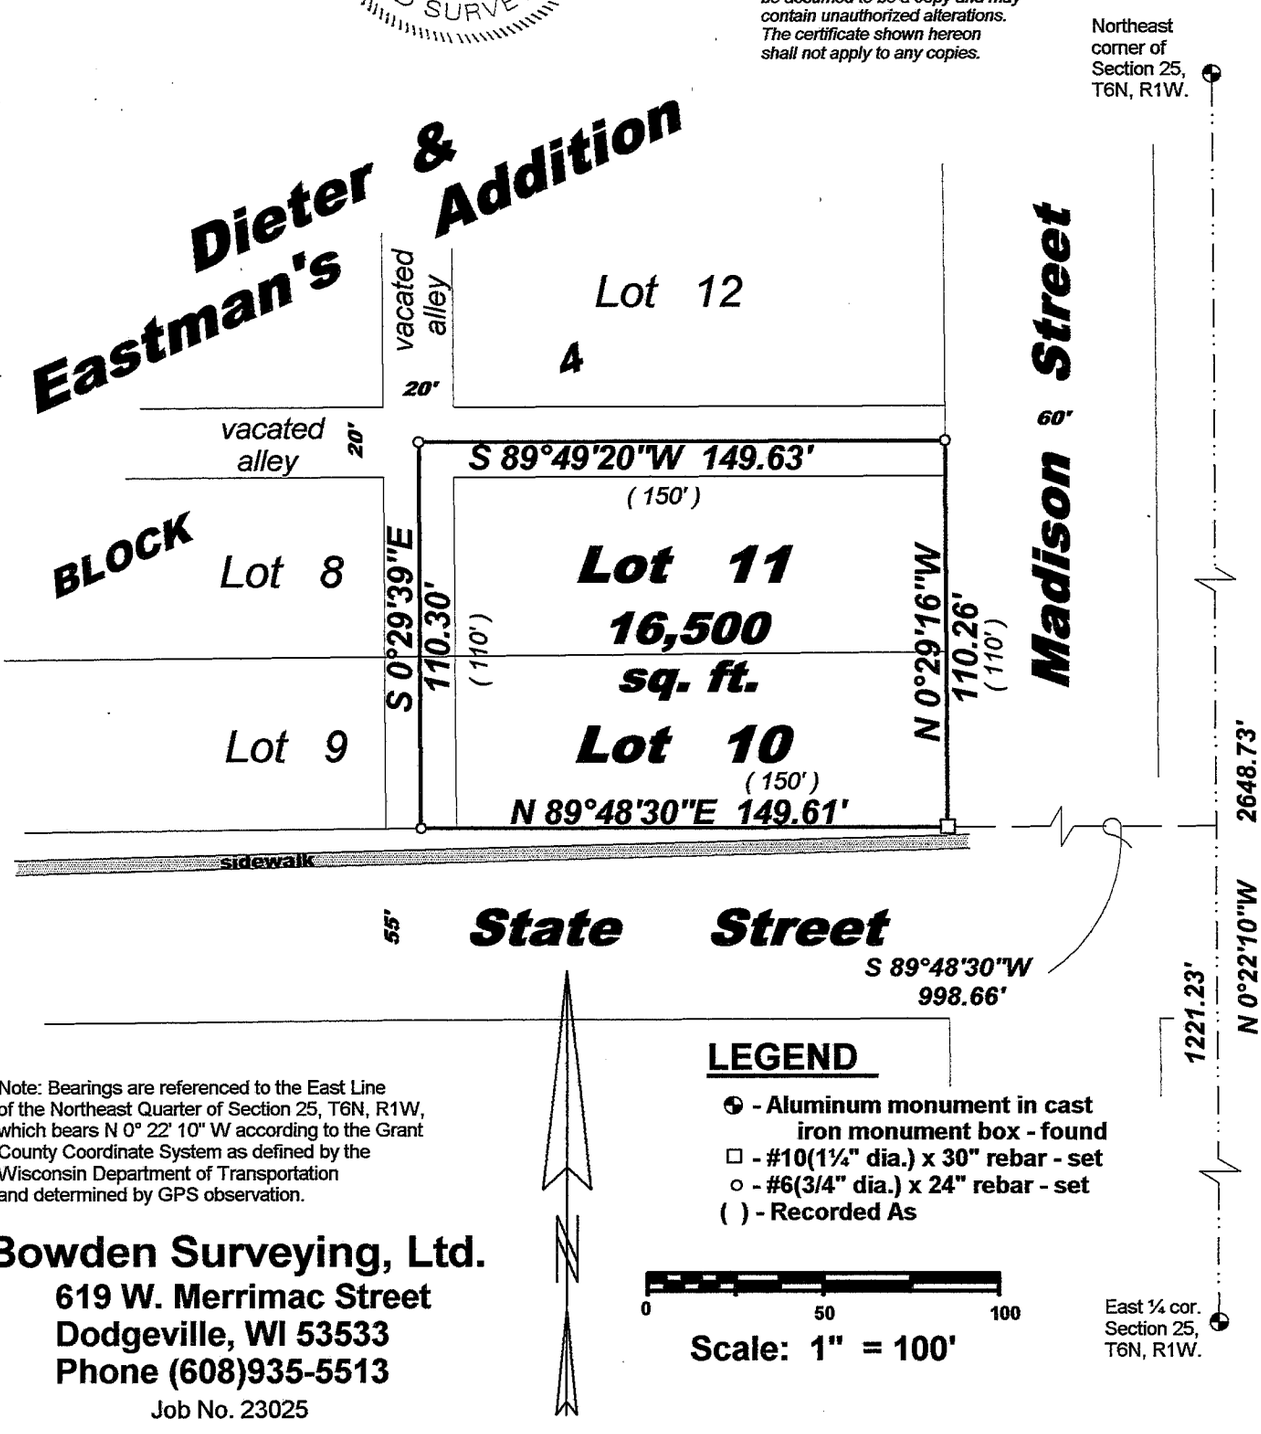

LEGEND

- ◓ - Aluminum monument in cast iron monument box - found
- □ - #10(1¼" dia.) x 30" rebar - set
- ○ - #6(3/4" dia.) x 24" rebar - set
- ( ) - Recorded As

0 50 100

Scale: 1" = 100'

Note: Bearings are referenced to the East Line of the Northeast Quarter of Section 25, T6N, R1W, which bears N 0° 22' 10" W according to the Grant County Coordinate System as defined by the Wisconsin Department of Transportation and determined by GPS observation.

Bowden Surveying, Ltd.
619 W. Merrimac Street
Dodgeville, WI 53533
Phone (608)935-5513

Job No. 23025