Book 21 Page 6

PLAT OF SURVEY

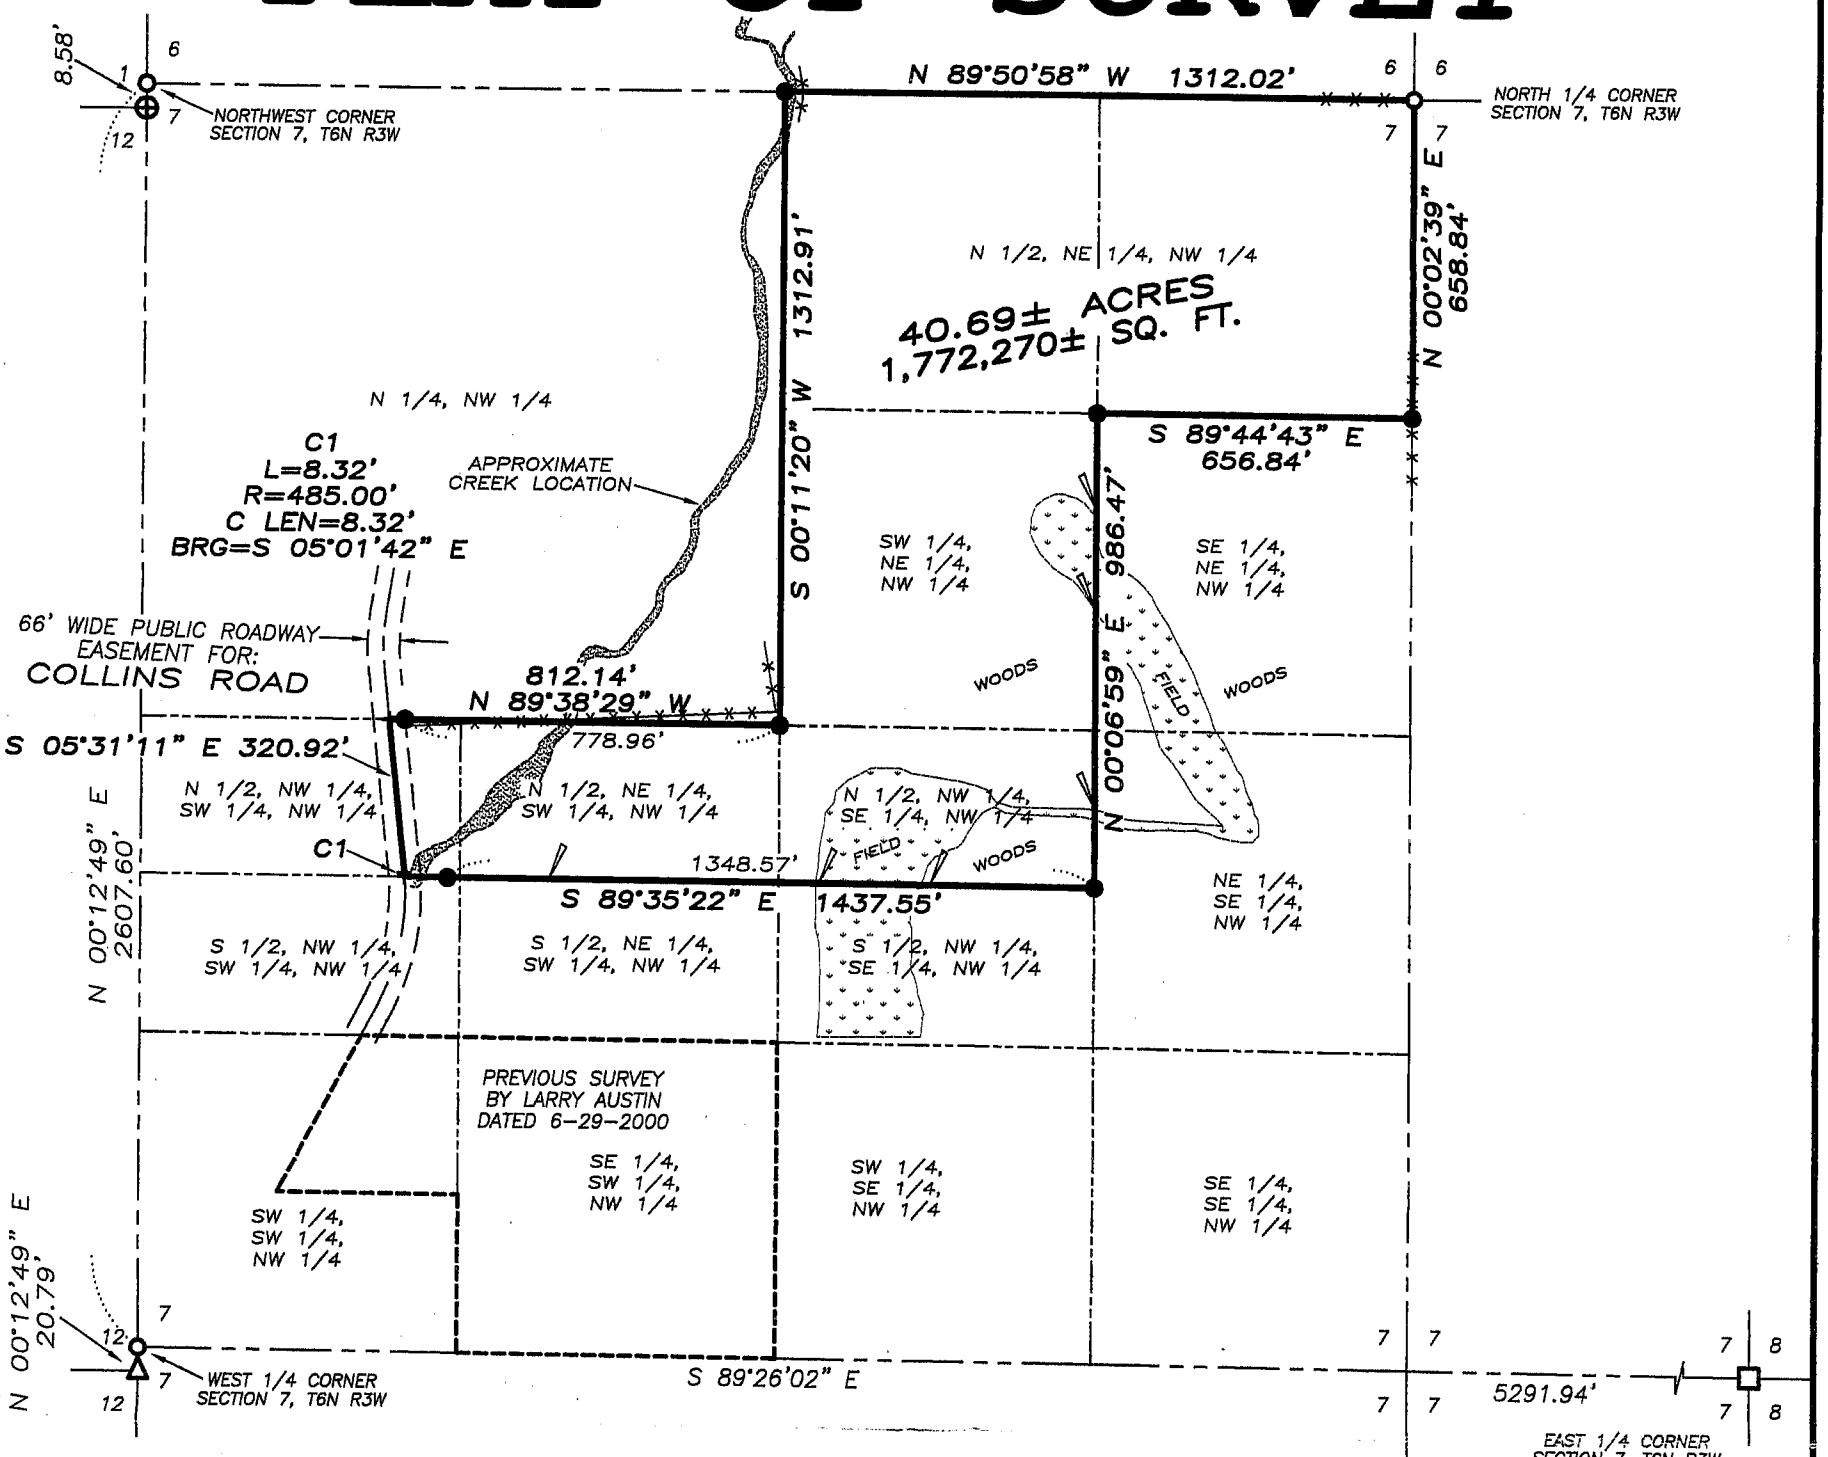

DESCRIPTION PROVIDED:
The SW 1/4 of the NE 1/4 of the NW 1/4;
The N 1/2 of the NW 1/4 of the SE 1/4 of the NW 1/4;
The N 1/2 of the NE 1/4 of the SW 1/4 of the NW 1/4;
One acres on the East side of the highway running North and South in the N 1/2 of the NW 1/4 of the SW 1/4 of the NW 1/4;
The N 1/2 of the NE 1/4 of the NW 1/4;
All in Section 7, T6N, R3W, Grant County, Wisconsin.

SURVEYOR'S CERTIFICATE:
I, Larry L. Austin, Registered Wisconsin Land Surveyor, hereby certify:
That the above description was surveyed, mapped and monumented as shown on this plat by me or under my direct supervision.
That conformance with local ordinances are not guaranteed with this survey.
That this survey was prepared under the instructions of Charlotte Leffler.
That to the best of my knowledge and belief, this plat is an accurate representation thereof.
That all plans that do not show a seal imprint in red ink may contain unauthorized alterations.
The certification contained on this document shall not apply to any copies.
Dated this 10th day of April, 2007.

Larry L. Austin, S-1903

WISCONSIN
LARRY L.
AUSTIN
S-1903
LANCASTER
WI
LAND SURVEYOR

LEGEND

- ● No. 6 x 24" rebar set with cap – wt=1.50 #/l.f.
- ⊕ No. 8 rebar found with Grant County Aluminum Cap
- o No. 6 rebar found
- □ No. 10 rebar found
- △ 1" diameter iron pipe found
- \+ No monument set
- / Wood Lath set for alignment
- -x-x-x- Approximate location of fence

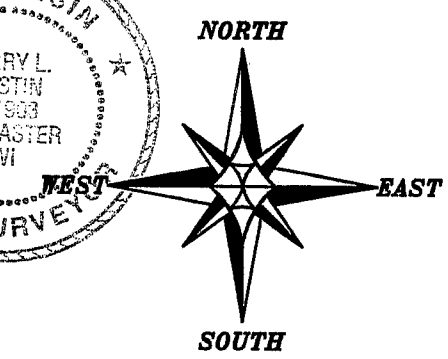

THE NORTH LINE OF THE NW 1/4 OF SECTION 7 IS ASSUMED TO BEAR N 89°50'58" W.

0 400 800

SCALE 1" = 400'

Austin Engineering LLC
4211 HWY 81 E, LANCASTER, WI 53813
PHONE 608-723-6363 FAX 608-723-6702

Prepared For: CHARLOTTE LEFFLER

JOB NO: 07s054
FIELDBOOK: TDSR
G:\T6NR3W\32B
H:\PLAT\T6NR3W\07\07s054-LEFFLER

DRAWN BY: AJ AUSTIN
APPROVED: LL AUSTIN
CREW: BS-SA-BD