


PLAT OF SURVEY

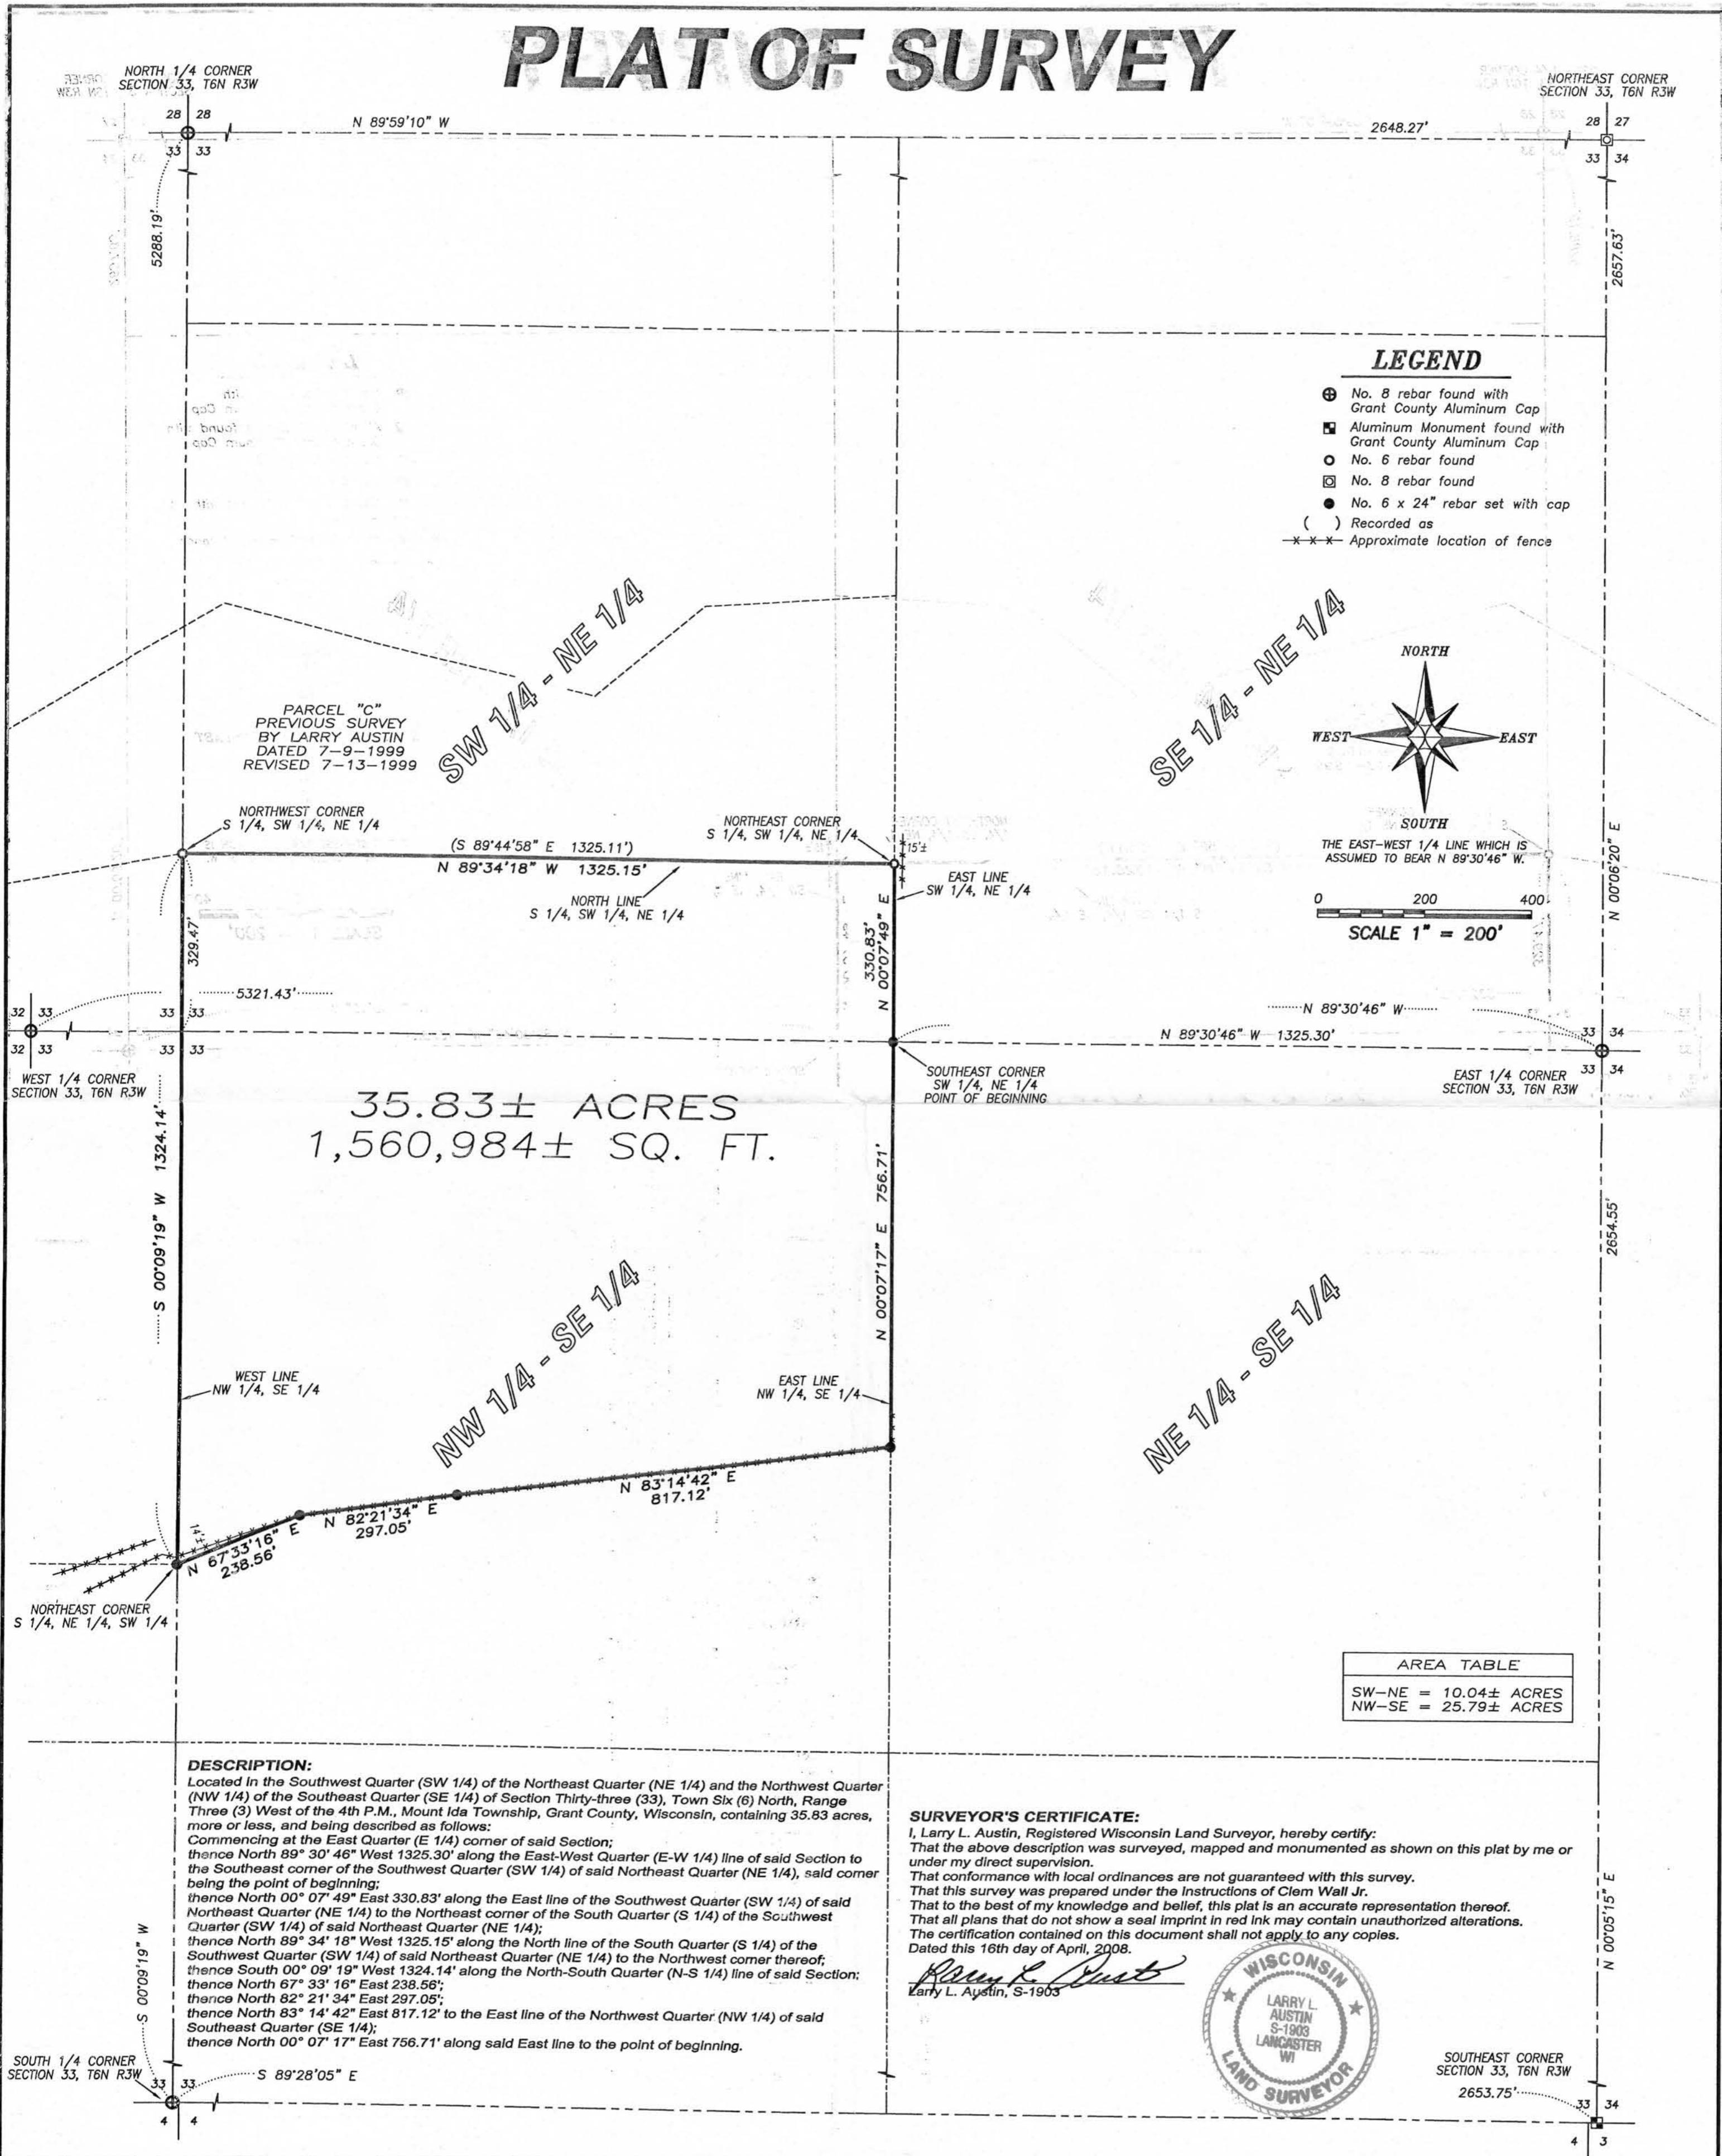

BOOK 22 PAGE 92