



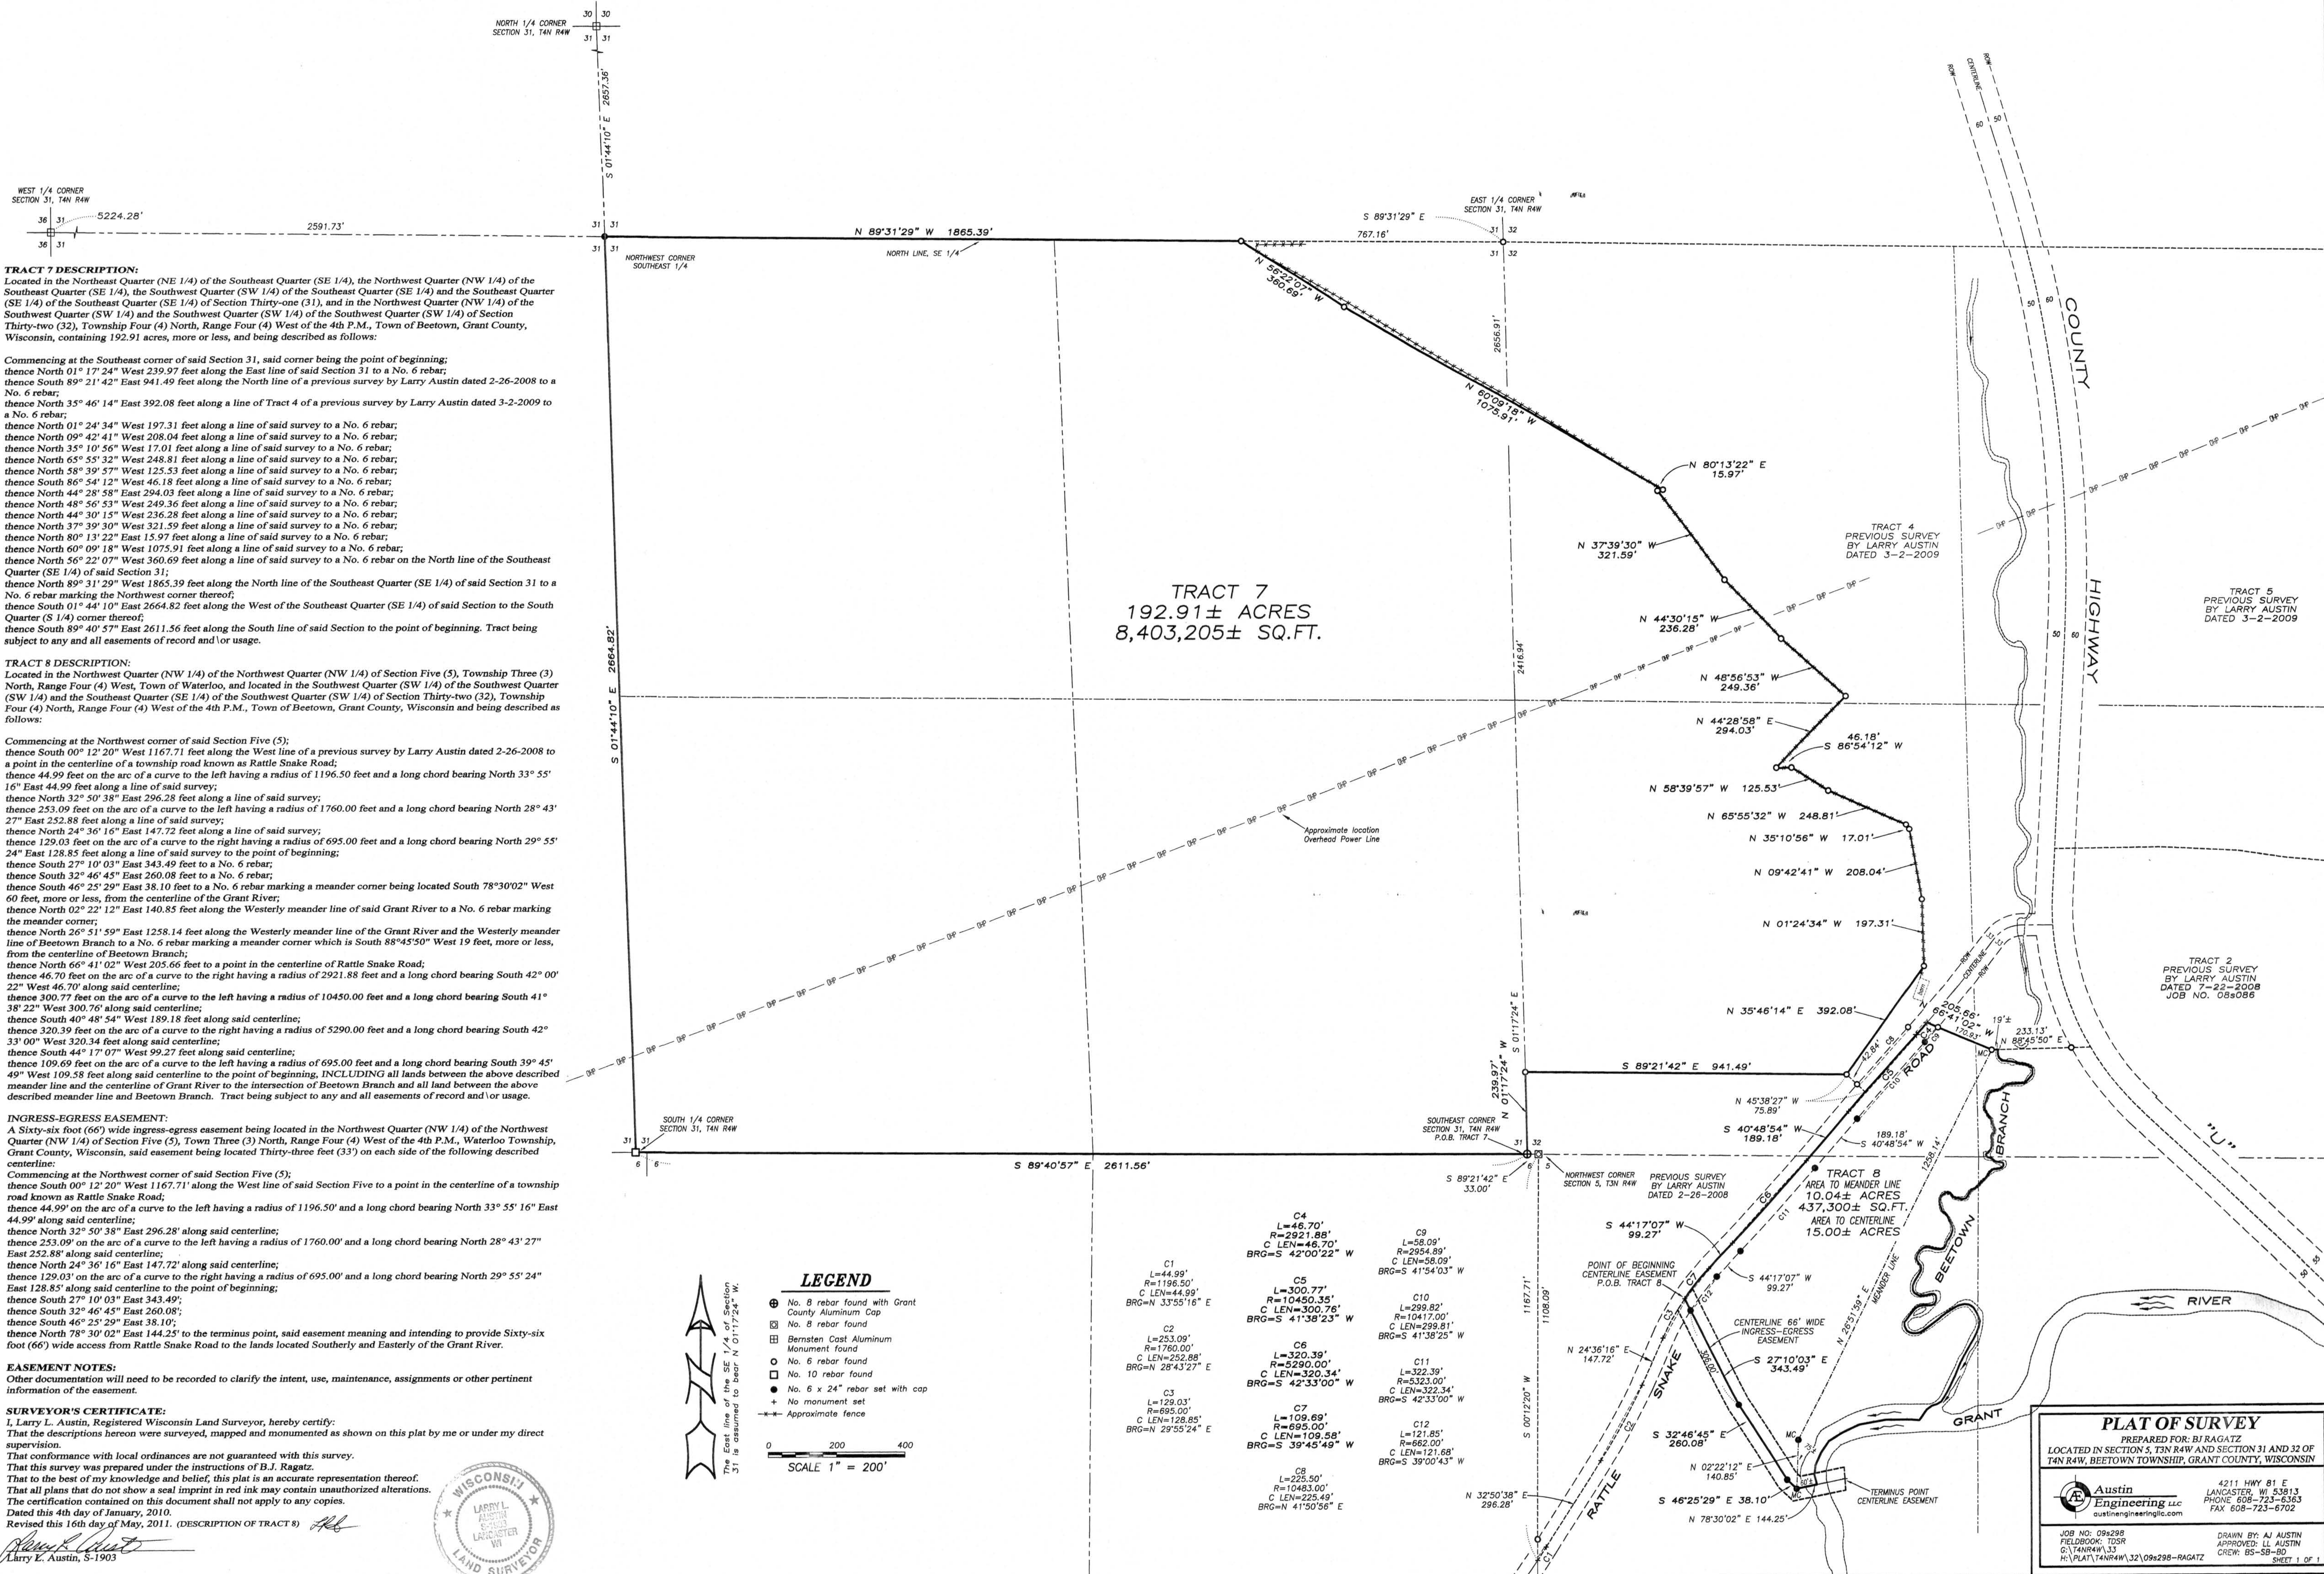

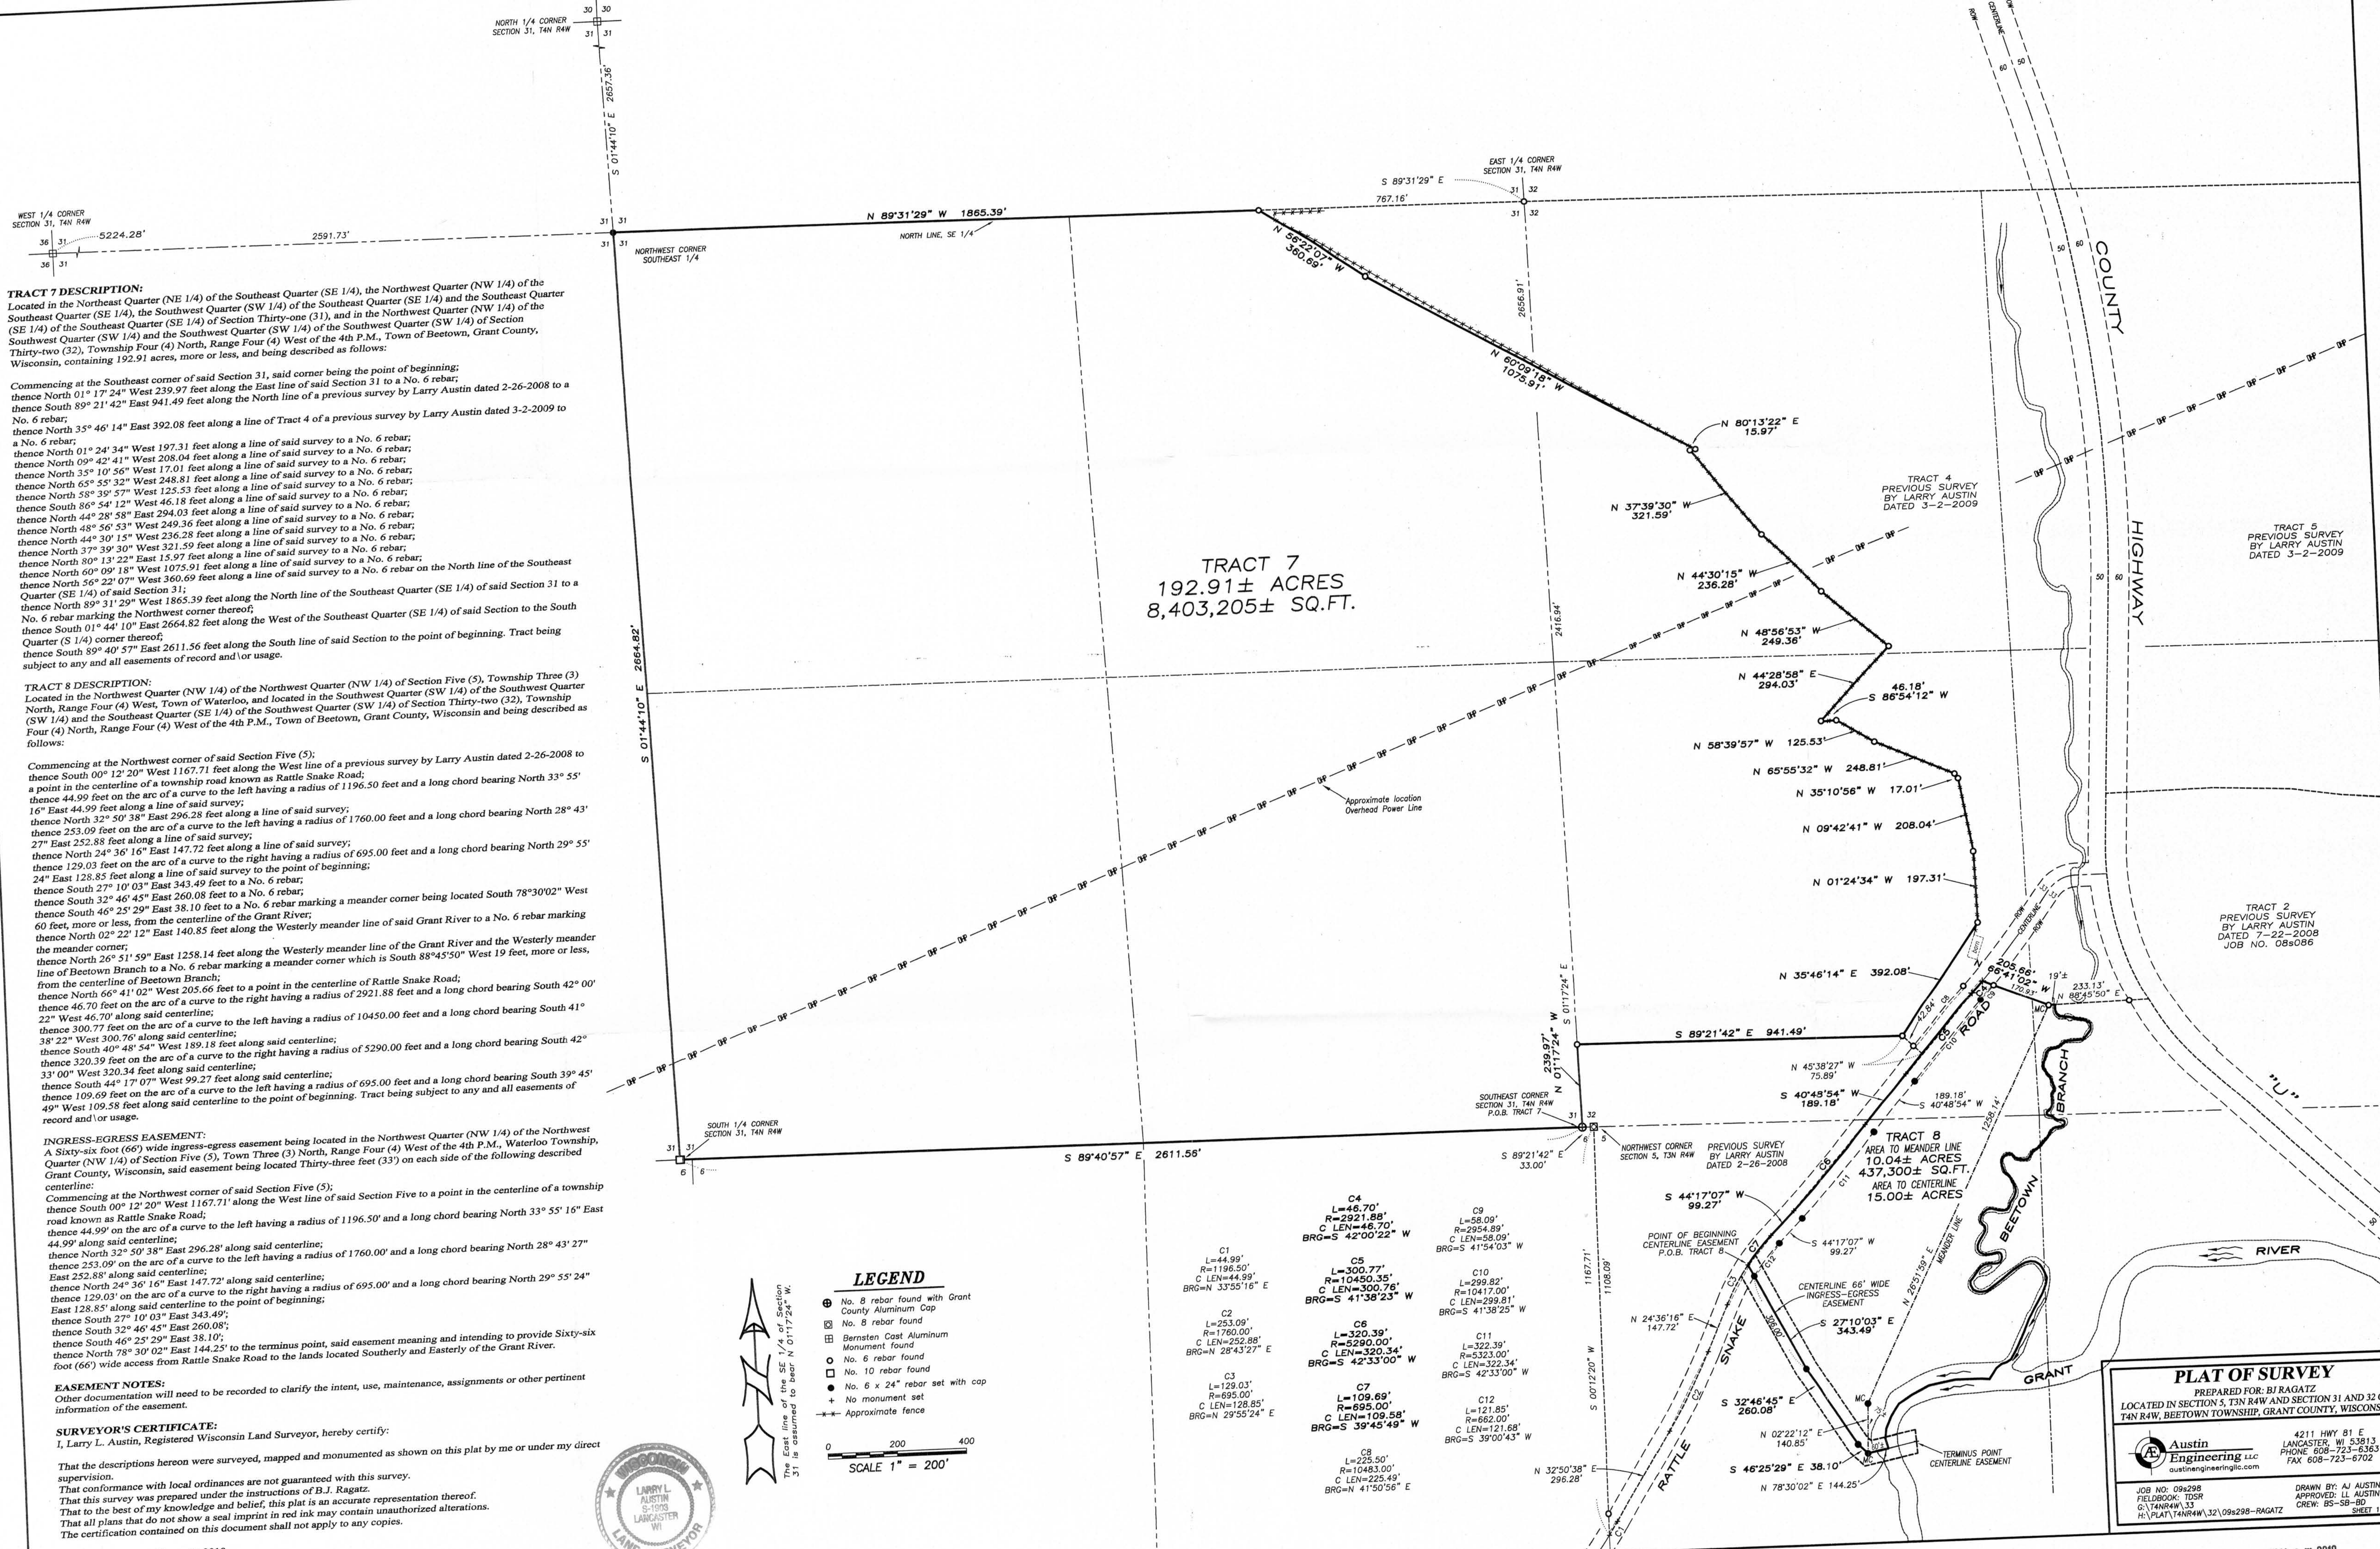

PLAT OF SURVEY
 PREPARED FOR: BJ RAGATZ
 LOCATED IN SECTION 5, T3N R4W AND SECTION 31 AND 32 OF T4N R4W, BEETOWN TOWNSHIP, GRANT COUNTY, WISCONSIN

Austin Engineering LLC
 4211 HWY 81 E
 LANCASTER, WI 53113
 PHONE 608-723-6363
 FAX 608-723-6702

JOB NO: 09298
 FIELDBOOK: TDSR
 H:\PLAT\T4N R4W\32\09298-RAGATZ

DRAWN BY: AJ AUSTIN
 APPROVED: LL AUSTIN
 CREW: BS-SB-BD

SHEET 1 OF 1

Dated this 4th day of January, 2010.

Larry L. Austin
 Larry L. Austin, S-1903

