

PLAT OF SURVEY




POINT	NORTHING	EASTING	DESCRIPTION
1	564258.853	836322.308	SE COR 30, T6NR2W, #8-CAP
2	561609.850	836348.208	W 1/4 32, T6NR2W, #8-CAP
3	568990.375	836358.961	NE COR 6, T5NR2W, 1" IPF
4	566222.514	836373.543	E 1/4 6, T5NR2W, AL MON
5	565560.523	833701.279	S 1/4 6, T5NR2W, #8-CAP
6	565026.915	836296.381	E 1/4 30, T6NR2W, #8-CAP
7	568981.123	833654.893	N 1/4 30, T6NR2W, AL MON
8	569559.386	830992.749	NW COR 30, T6NR2W, AL MON
9	569581.455	836297.821	NE COR 30, T6NR2W, AL MON
10	564268.987	838989.519	S 1/4 29, T6NR3W, #8-CAP
11	561617.000	839006.415	CENTER 32, T6NR2W, STONE
12	564241.983	833573.106	E 1/4 6, T6NR2W, AL MON
13	568987.176	839018.808	N 1/4 5, T5NR2W, #8-CAP
14	563538.891	831040.721	NE COR 12, T5NR3W, #8-CAP
15	548231.510	833681.462	S 1/4 7, T5NR2W, 1" IPF
16	548226.416	828401.136	S 1/4 12, T5NR3W, #10 IBF
17	553528.324	828377.449	N 1/4 12, T5NR3W, #10 IBF
18	543586.121	831074.848	E 1/4 13, T5NR3W, AL MON
19	543595.387	833684.966	CENTER 18, T5NR2W, #6 IBF
20	542930.238	831066.786	SE COR 13, T5NR3W, #6 IBF
21	537619.444	831119.180	SW COR 18, T5NR2W, #8-CAP
22	534953.277	831144.591	E 1/4 25, T5NR3W, #8-CAP
23	558987.449	833715.911	N 1/4 6, T5NR2W, #8-CAP
24	558987.427	833724.161	S 1/4 31, T5NR2W, #8-CAP
25	561609.798	833688.870	CENTER 31, T6NR2W, #8-CAP
26	566905.175	833683.986	CENTER 30, T6NR2W, #8-CAP
27	558980.330	836375.461	SW COR 32, T6NR2W, #8-CAP
28	558981.197	839007.058	S 1/4 32, T6NR2W, #8-CAP
29	556209.703	833708.448	CENTER 6, T5NR2W, #8-CAP
30	548224.239	831052.795	SE COR 12, T5NR3W, #8-CAP
31	548237.839	831052.795	SW COR 7, T5NR2W, #8-CAP
32	533597.370	831040.597	SW COR 6, T5NR2W, #8-CAP
33	550877.370	828389.293	CENTER 12, T5NR3W, #8-CAP
34	545603.938	831074.898	W 1/4 18, T5NR2W, AL MON
35	550881.568	831046.786	E 1/4 12, T5NR2W, #8-CAP
36	550807.305	831046.700	W 1/4 7, T5NR2W, #8-CAP
37	542921.278	833688.879	S 1/4 18, T5NR2W, #8-CAP
38	550881.568	831046.786	SW COR 18, T5NR2W, #8-CAP
39	550904.126	833691.363	CENTER 7, T5NR2W, #8-CAP
40	537617.985	833756.062	S 1/4 19, T5NR2W, #8-CAP
41	569544.866	830962.193	NE COR 25, T5NR3W, #8-CAP
42	534953.277	831144.540	W 1/4 30, T5NR2W, #8-CAP
43	540276.034	831092.961	W 1/4 19, T5NR2W, #8-CAP
44	540274.714	831092.974	E 1/4 24, T5NR3W, #8-CAP
45	540269.226	833722.479	CENTER 19, T5NR2W, #8-CAP

COORDINATES SHOWN HEREON ARE PROVIDED BY THE WISCONSIN DEPARTMENT OF TRANSPORTATION.

SCALE 1" = 900'

LEGEND

- ⊙ No. 6 rebar found with Grant
- ⊙ No. 8 rebar found with Grant
- ⊙ No. 10 rebar found with Grant
- ⊙ County Aluminum Cap
- ⊙ Aluminum Monument found
- ⊙ 1" diameter iron pipe found
- ⊙ Stone monument found
- ⊙ No. 8 x 30" rebar set with Grant
- ⊙ Grant County Aluminum Cap

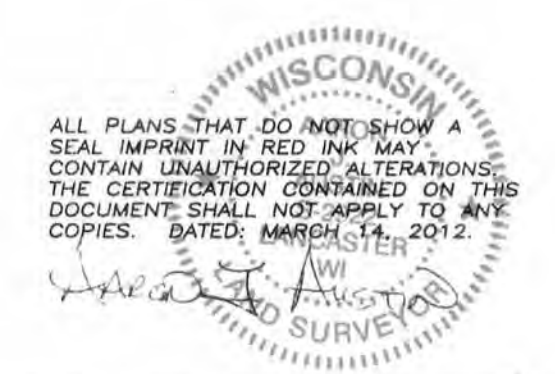

PREPARED FOR: SEH INC.
I.D. 1650-06-03
USH 61 LANCASTER-FENNIMORE
GRANT COUNTY, WISCONSIN

Austin Engineering LLC
4211 HWY 81 E
LANCASTER, WI 53813
PHONE 608-723-6363
FAX 608-723-6702



JOB NO: 11s192
S:\GRANT\DOT\11s192-HWY81N-SEH(c).DWG
FIELDBOOK: TDSR
DRAWN BY: AL AUSTIN
CREW: BS-SB
SHEET 1 OF 2

PLAT OF SURVEY

POINT	NORTHING	EASTING	DESCRIPTION

SURVEYOR'S CERTIFICATE:
 I, Aaron J. Austin, Registered Wisconsin Land Surveyor, hereby certify:
 That the corners shown on this survey were surveyed, mapped and monumented as shown on this plat by me or under my direct supervision.
 That this survey was prepared under the instructions of Ray Polkinghorn, Project Manager of SEH Inc.
 That to the best of my knowledge and belief, this plat is an accurate representation thereof.
 That all plans that do not show a seal imprint in red ink may contain unauthorized alterations.
 The certification contained on this document shall not apply to any copies.

Dated this 14th day of March, 2012
 Aaron J. Austin, S-29222

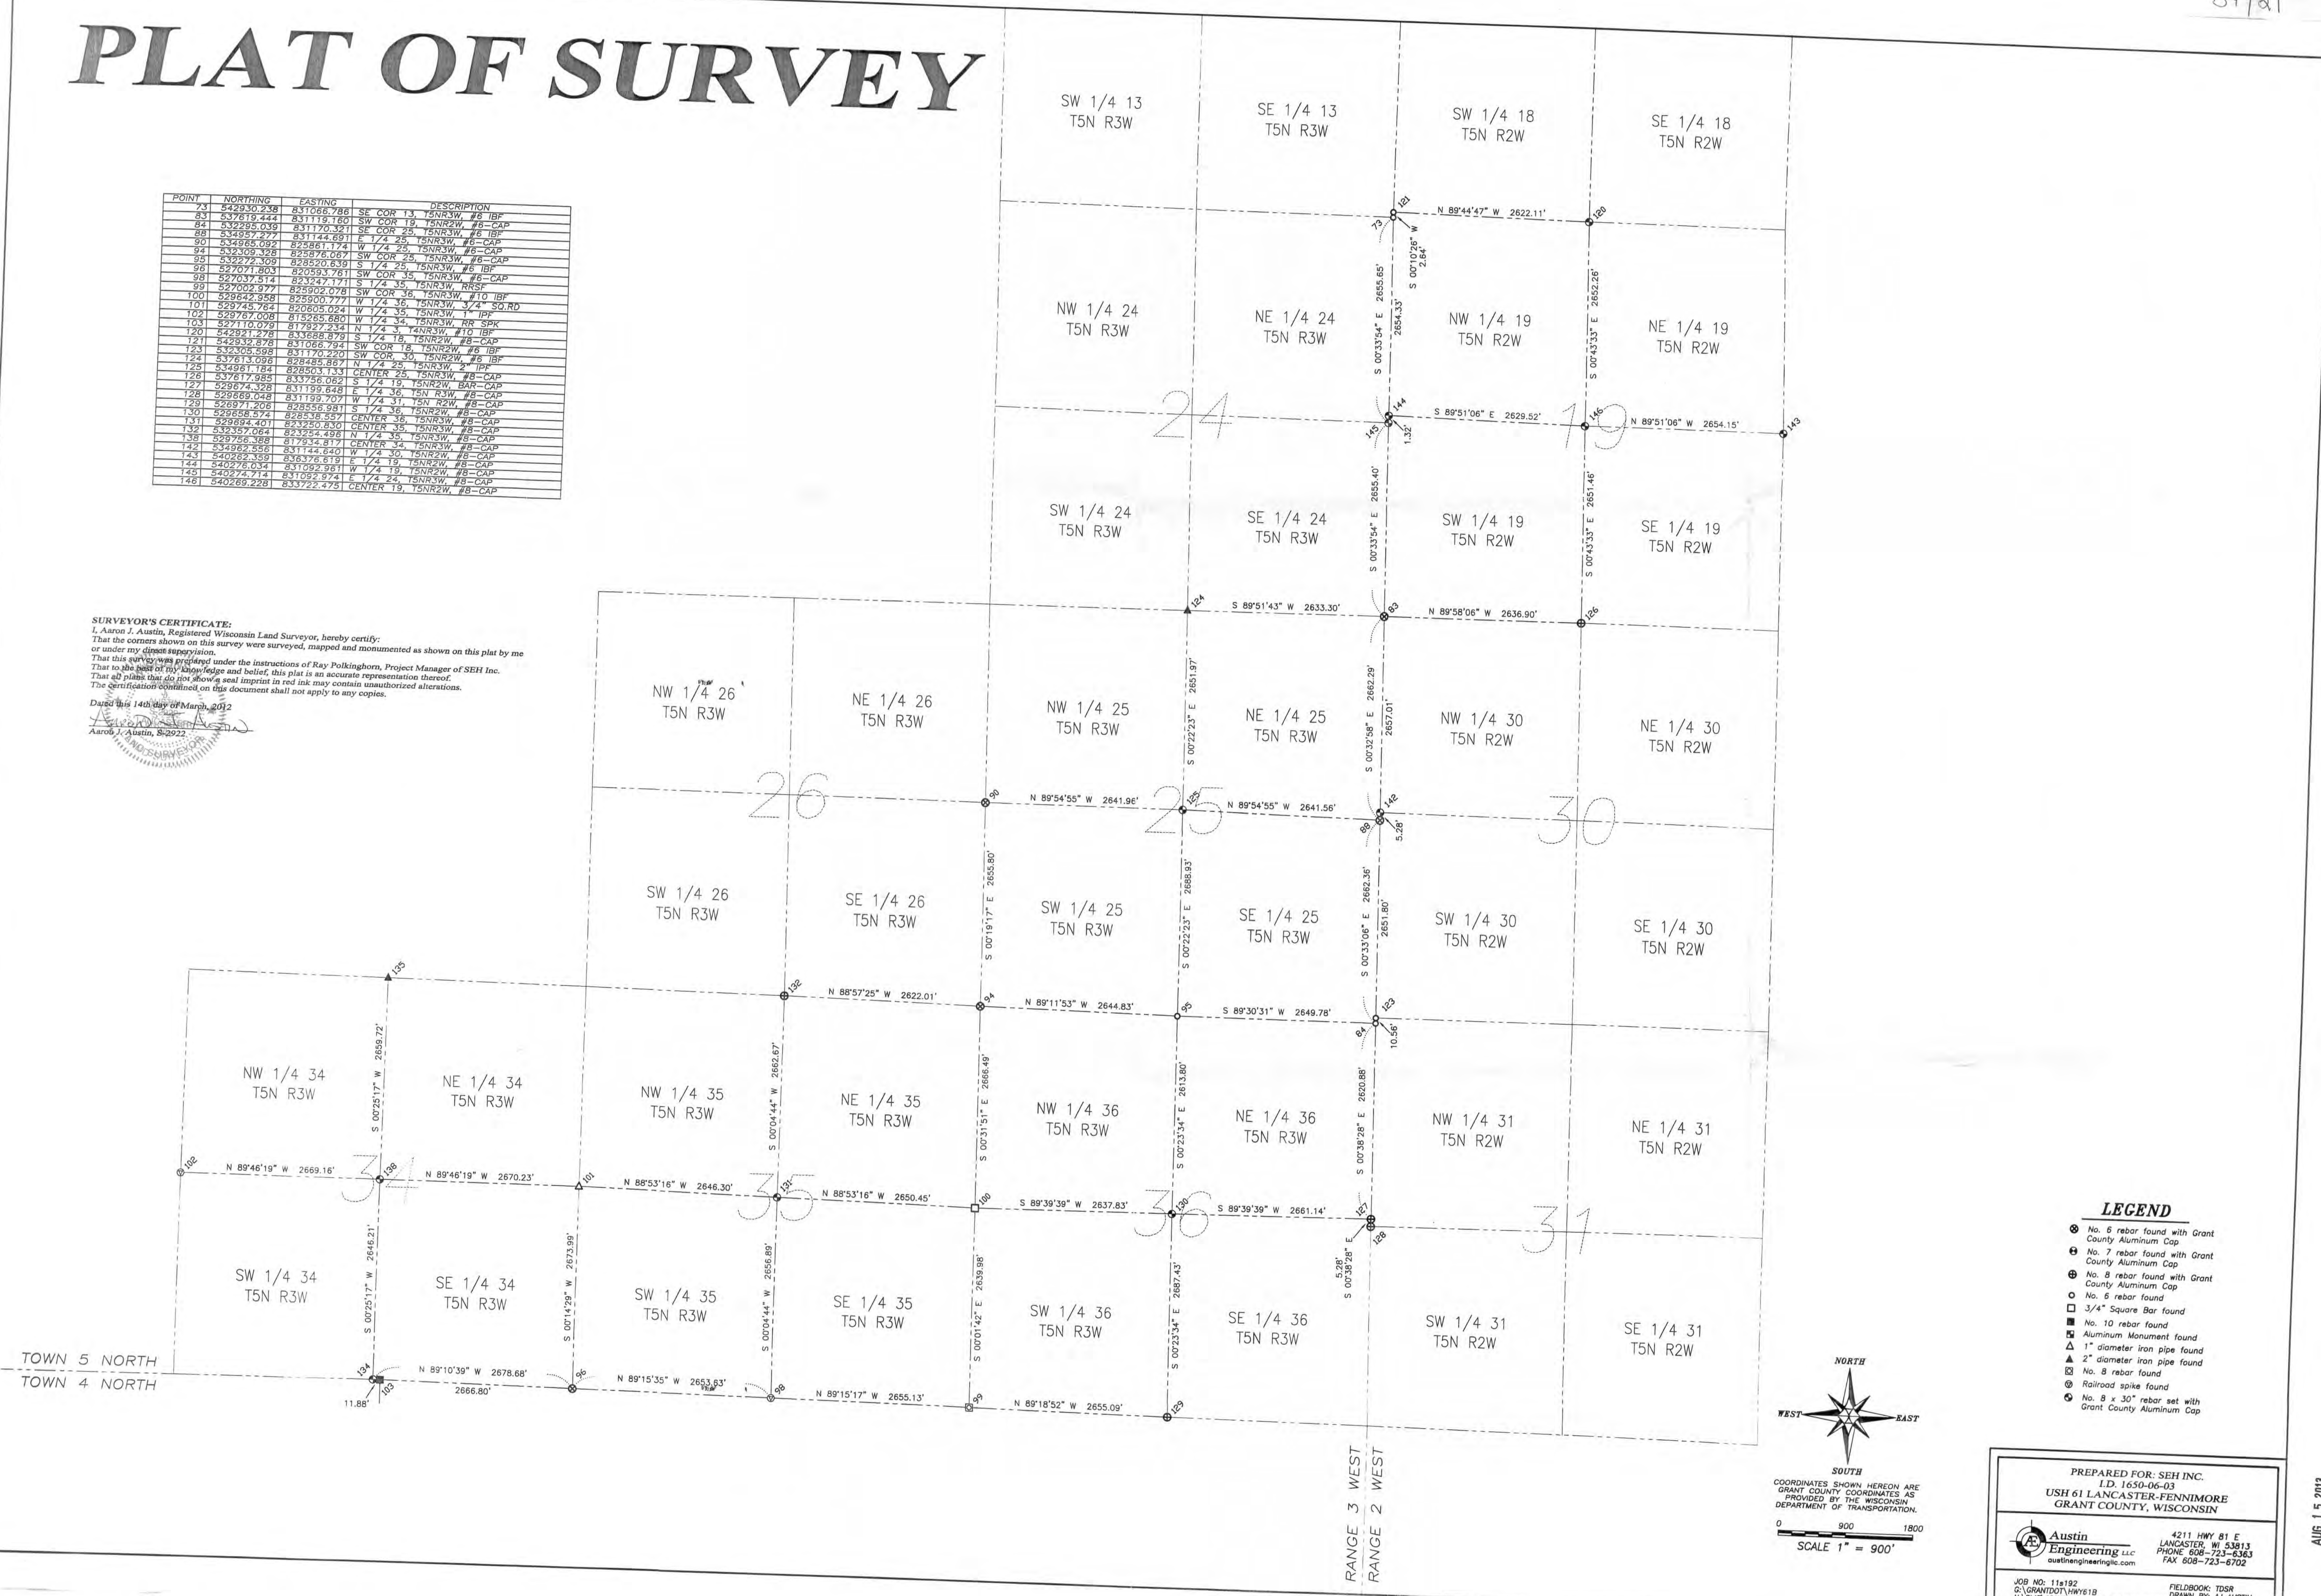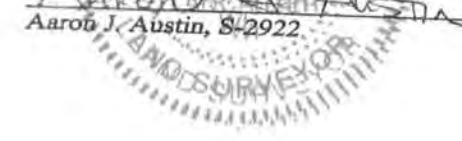

LEGEND

- ⊗ No. 6 rebar found with Grant County Aluminum Cap
- ⊕ No. 7 rebar found with Grant County Aluminum Cap
- ⊖ No. 8 rebar found with Grant County Aluminum Cap
- ⊙ No. 6 rebar found
- 3/4" Square Bar found
- No. 10 rebar found
- ▣ Aluminum Monument found
- ▲ 1" diameter iron pipe found
- △ 2" diameter iron pipe found
- ⊠ No. 8 rebar found
- ⊞ Railroad spike found
- ⊗ No. 8 x 30" rebar set with Grant County Aluminum Cap

NORTH

SOUTH

COORDINATES SHOWN HEREON ARE GRANT COUNTY COORDINATES AS PROVIDED BY THE WISCONSIN DEPARTMENT OF TRANSPORTATION.

0 900 1800
 SCALE 1" = 900'

PREPARED FOR: SEH INC.
 I.D. 1650-06-03
 USH 61 LANCASTER-FENNIMORE
 GRANT COUNTY, WISCONSIN

Austin Engineering LLC
 austinengineeringllc.com
 4211 HWY 81 E
 LANCASTER, WI 53813
 PHONE 608-723-6363
 FAX 608-723-6702

JOB NO: 11a192
 G:\GRANTDOT\HWY61B
 H:\PLAT\GRANTDOT\11a192-HWY61B-SEH(a).DWG

FIELDBOOK: TDSR
 DRAWN BY: AJ AUSTIN
 CREW: BS-59