42050

SEP 25 2018

PLAT OF SURVEY

PREPARED FOR: LIBERTY TOWNSHIP

H:\PLAT\STITZER\18S157–LIBERTY TWP
CREW: S. AUSTIN, O. AUSTIN, DRAWN BY: AJ AUSTIN

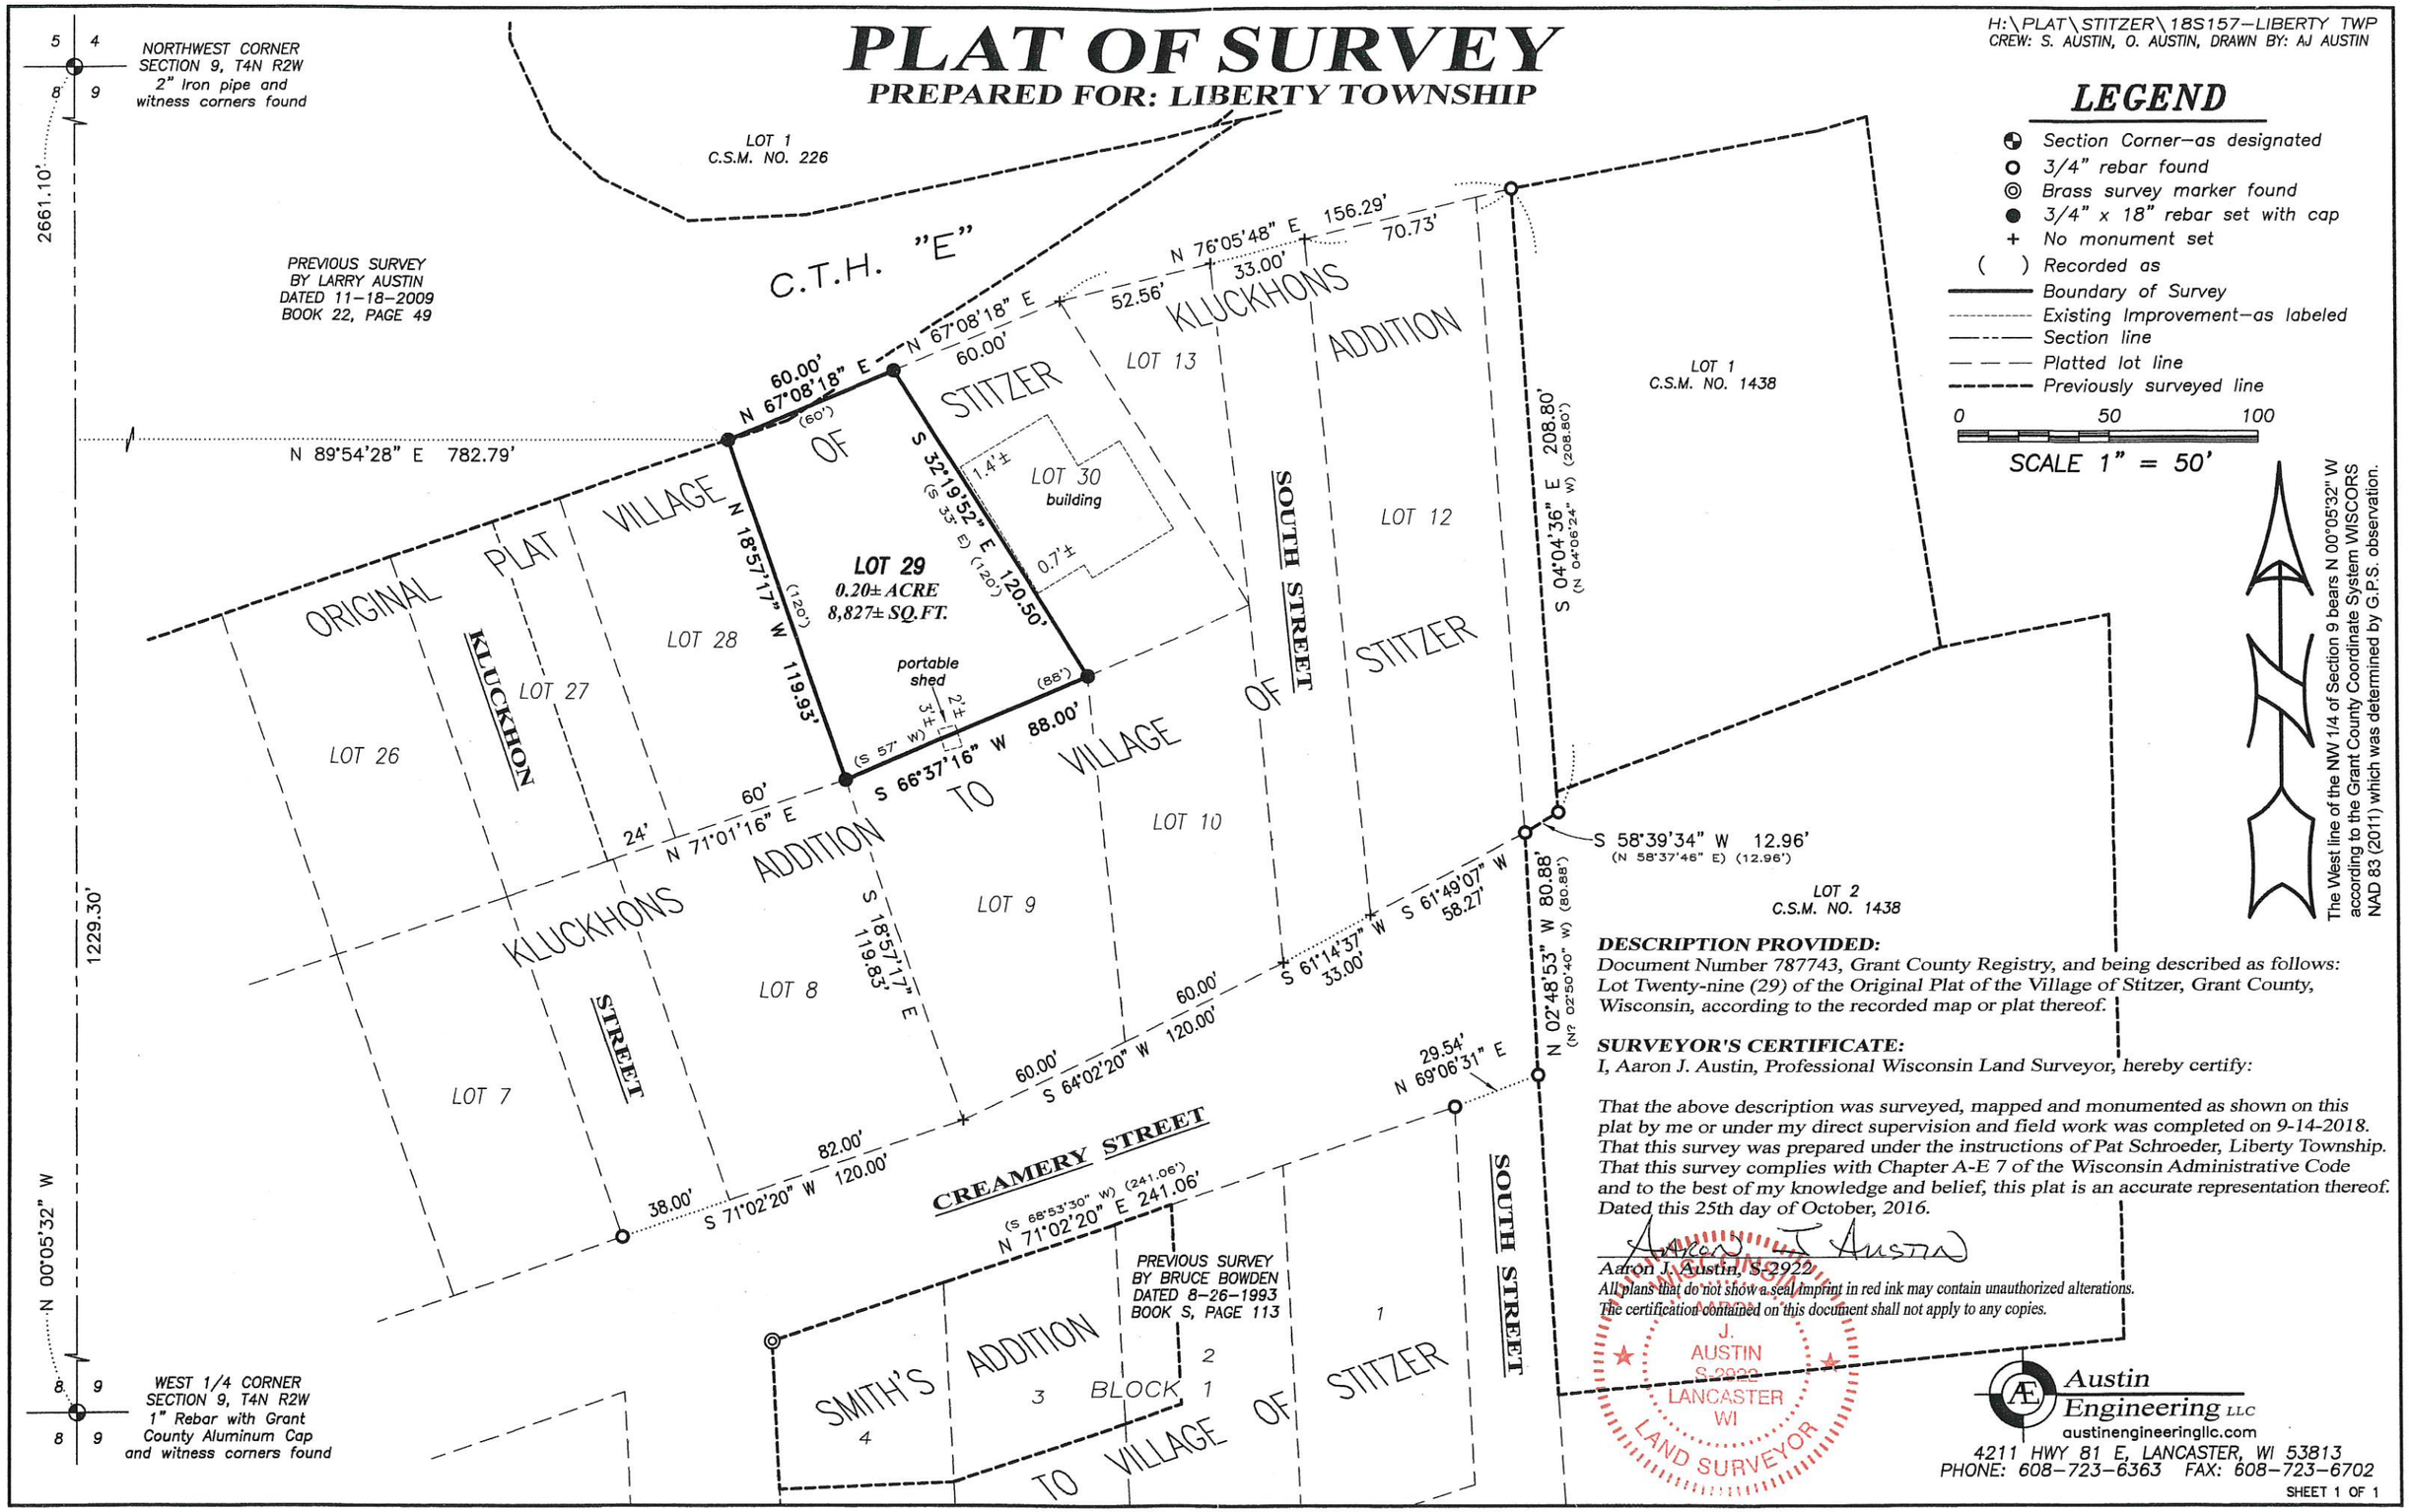

DESCRIPTION PROVIDED:
Document Number 787743, Grant County Registry, and being described as follows: Lot Twenty-nine (29) of the Original Plat of the Village of Stitzer, Grant County, Wisconsin, according to the recorded map or plat thereof.

SURVEYOR'S CERTIFICATE:
I, Aaron J. Austin, Professional Wisconsin Land Surveyor, hereby certify:

That the above description was surveyed, mapped and monumented as shown on this plat by me or under my direct supervision and field work was completed on 9-14-2018. That this survey was prepared under the instructions of Pat Schroeder, Liberty Township. That this survey complies with Chapter A-E 7 of the Wisconsin Administrative Code and to the best of my knowledge and belief, this plat is an accurate representation thereof. Dated this 25th day of October, 2016.

Aaron J. Austin, S-2922

All plans that do not show a seal imprint in red ink may contain unauthorized alterations.
The certification contained on this document shall not apply to any copies.

WISCONSIN J. AUSTIN S-2922 LANCASTER WI LAND SURVEYOR

Austin Engineering LLC
austinengineeringllc.com
4211 HWY 81 E, LANCASTER, WI 53813
PHONE: 608–723–6363 FAX: 608–723–6702