RECEIVED
By Land Information Office at 10:35 am, Jul 27, 2020

45016

MSA
ENGINEERING | ARCHITECTURE | SURVEYING
FUNDING | PLANNING | ENVIRONMENTAL
1702 Pankratz Street Madison, WI 53704
(608) 242-7779 www.msa-ps.com
© MSA Professional Services, Inc.

PROJECT NO.	MALCOLM
DRAWN BY	KCL
CHECKED BY	KCL
FILE:	MALCOLMG.DWG
SHEET NO.	1_OF_1
FIELD BOOK NO.	-

GRANT COUNTY PLAT OF SURVEY

LEGAL DESCRIPTION:

LOTS 1 AND 2 AND VACATED ALLEY IN BLOCK 11 OF SECOND PARK ADDITION TO THE VILLAGE OF BLUE RIVER, GRANT COUNTY, WISCONSIN, ACCORDING TO THE RECORDED MAP OR PLAT THEREOF.

CLIENT:
MALCOLM GREELEY
111 MARTHA STREET
BLUE RIVER, WI

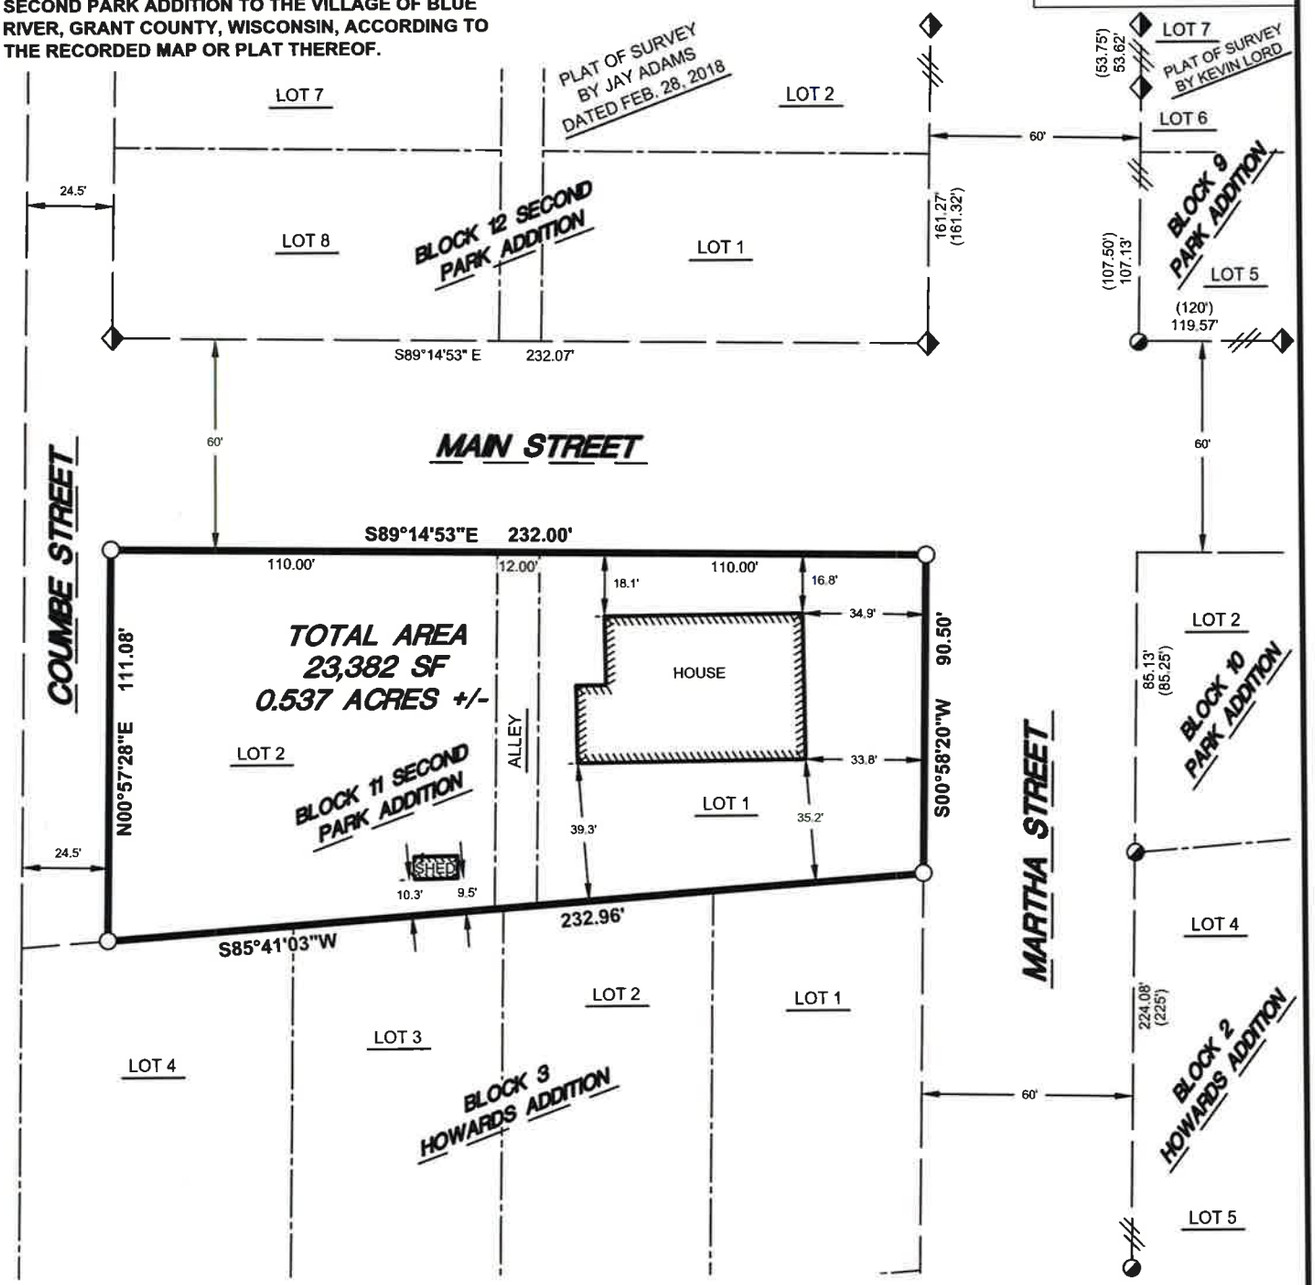

LEGEND

- FOUND 1/2" IRON PIPE
- FOUND 3/4" IRON BAR
- SET 3/4" X 24" IRON REBAR (WEIGHT = 1.50 LBS/FT)

(x.xx') RECORDED INFORMATION

N
W E
S

BEARINGS ARE ASSUMED

0 25' 50'

SURVEYOR'S SEAL

WISCONSIN
KEVIN C. LORD
S-2645
MADISON, WIS.
7-20-2020
LAND SURVEYOR

I, Kevin C. Lord, Professional Land Surveyor S-2645, do hereby certify by the order of Malcolm Greeley, I have surveyed and mapped the herein described property to the best of my knowledge and belief and that this map is a true and correct representation thereof and that I have complied with Wisconsin Administrative Code AE-7.

© Personal Surveys\Malcolm Survey\Malcolm3.dwg 15 Jul 2020 11:03am PDS