No 26 Surveyed for ~~John Carpenter~~ the Heirs

to the estate of John Carpenter deceased
a part of the West ½ of the S. W. quarter
of Section 18 of T. No. 4 of Range 1 E.

The West ½ of N. W. qr. of Section 19
of Town No. 4 North and of Range No. 1 East
of the fourth principal Meridian
March 24 & 25th 1840

also the N. E. qr. of N. E. qr. and the West ½ of
the North West qr. of Sec. 24 of T. 4 of R. 1 West
March 26 1840
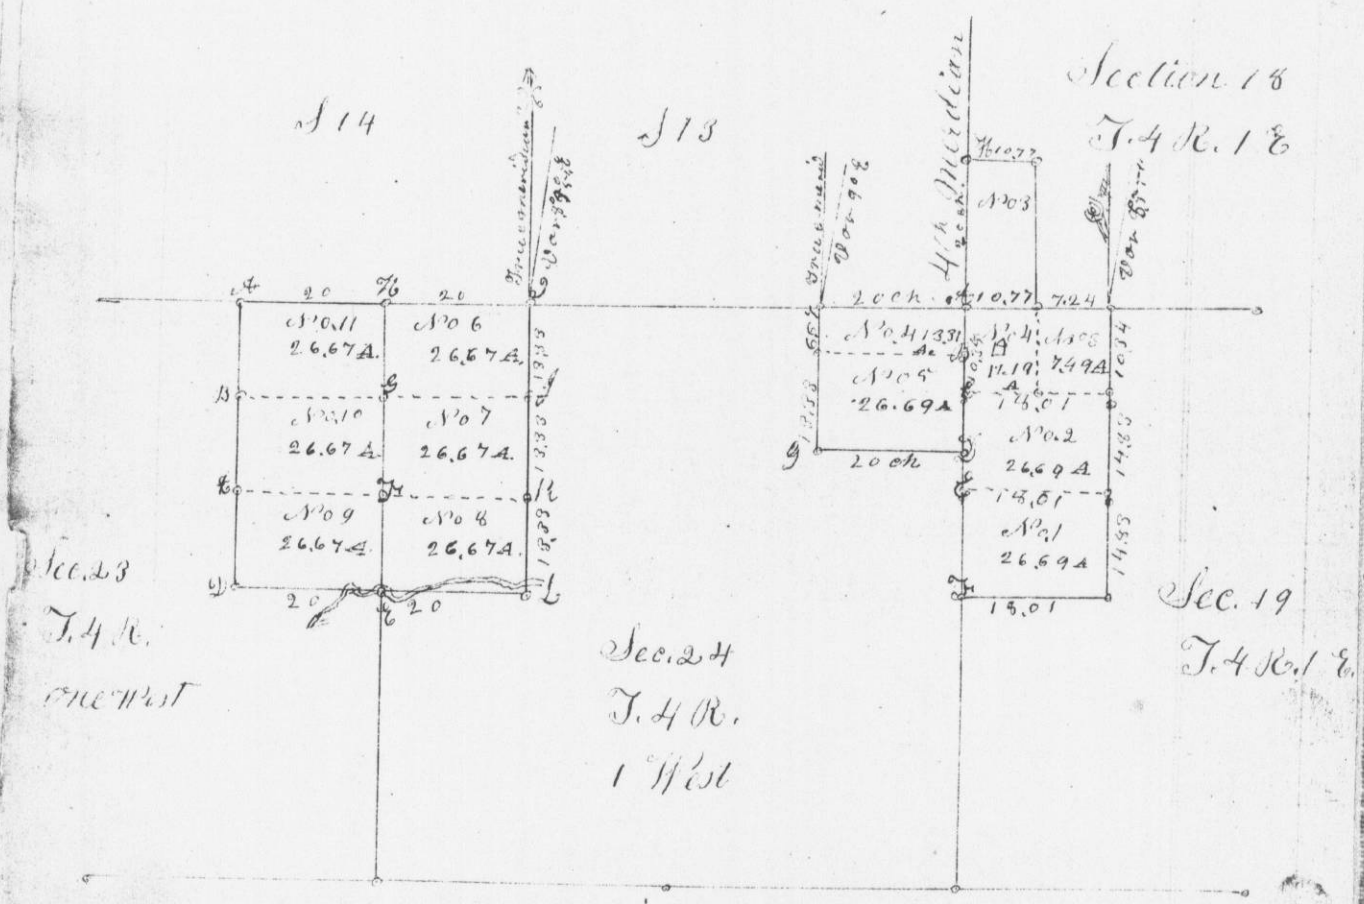
also the East ½ of N. E. qr. of Section 23 of T. No. 4 of
Range No. 1 West of the 4th principal Meridian
March 27th 1840.